

# REVISED SURVEY TO RESTORE PROPERTY CORNERS

## LOT'S PT. 3, 4, 31, 32, 34, 36, 38, 40, 42, 44, 46, & 47 BOGG'S ORCHARD TRACTS

### SURVEYED FOR LAWRENCE NEWTON SEC'S 1 & 12, T.28S., R.6 W., W.M. &

### BY BAUGHMAN SURVEYING SERVICE SEC. 6, T.28S., R.5 W., W.M.

SCALE 1" = 400'

LEGEND

- DENOTES 3/4" I.R. SET
- ⊙ DENOTES MONUMENTS AS NOTED
- DENOTES 3/4" I.R. FO.

FEB. 1967 PER M-32-58  
 REVISED AUG. 1973


COUNTY SURVEYORS FILE DATA  
 DO NOT REMOVE FROM OFFICE

REGISTERED  
 PROFESSIONAL  
 LAND SURVEYOR

*Glenn S. Baughman*  
 OREGON  
 JULY 14, 1961  
 GLENN S. BAUGHMAN  
 536

FILED  
 RECORD # 24  
 AUG 31  
 COUNTY SURVEYOR  
 DOUGLAS COUNTY, OREGON  
*ms*

M.50 - 55

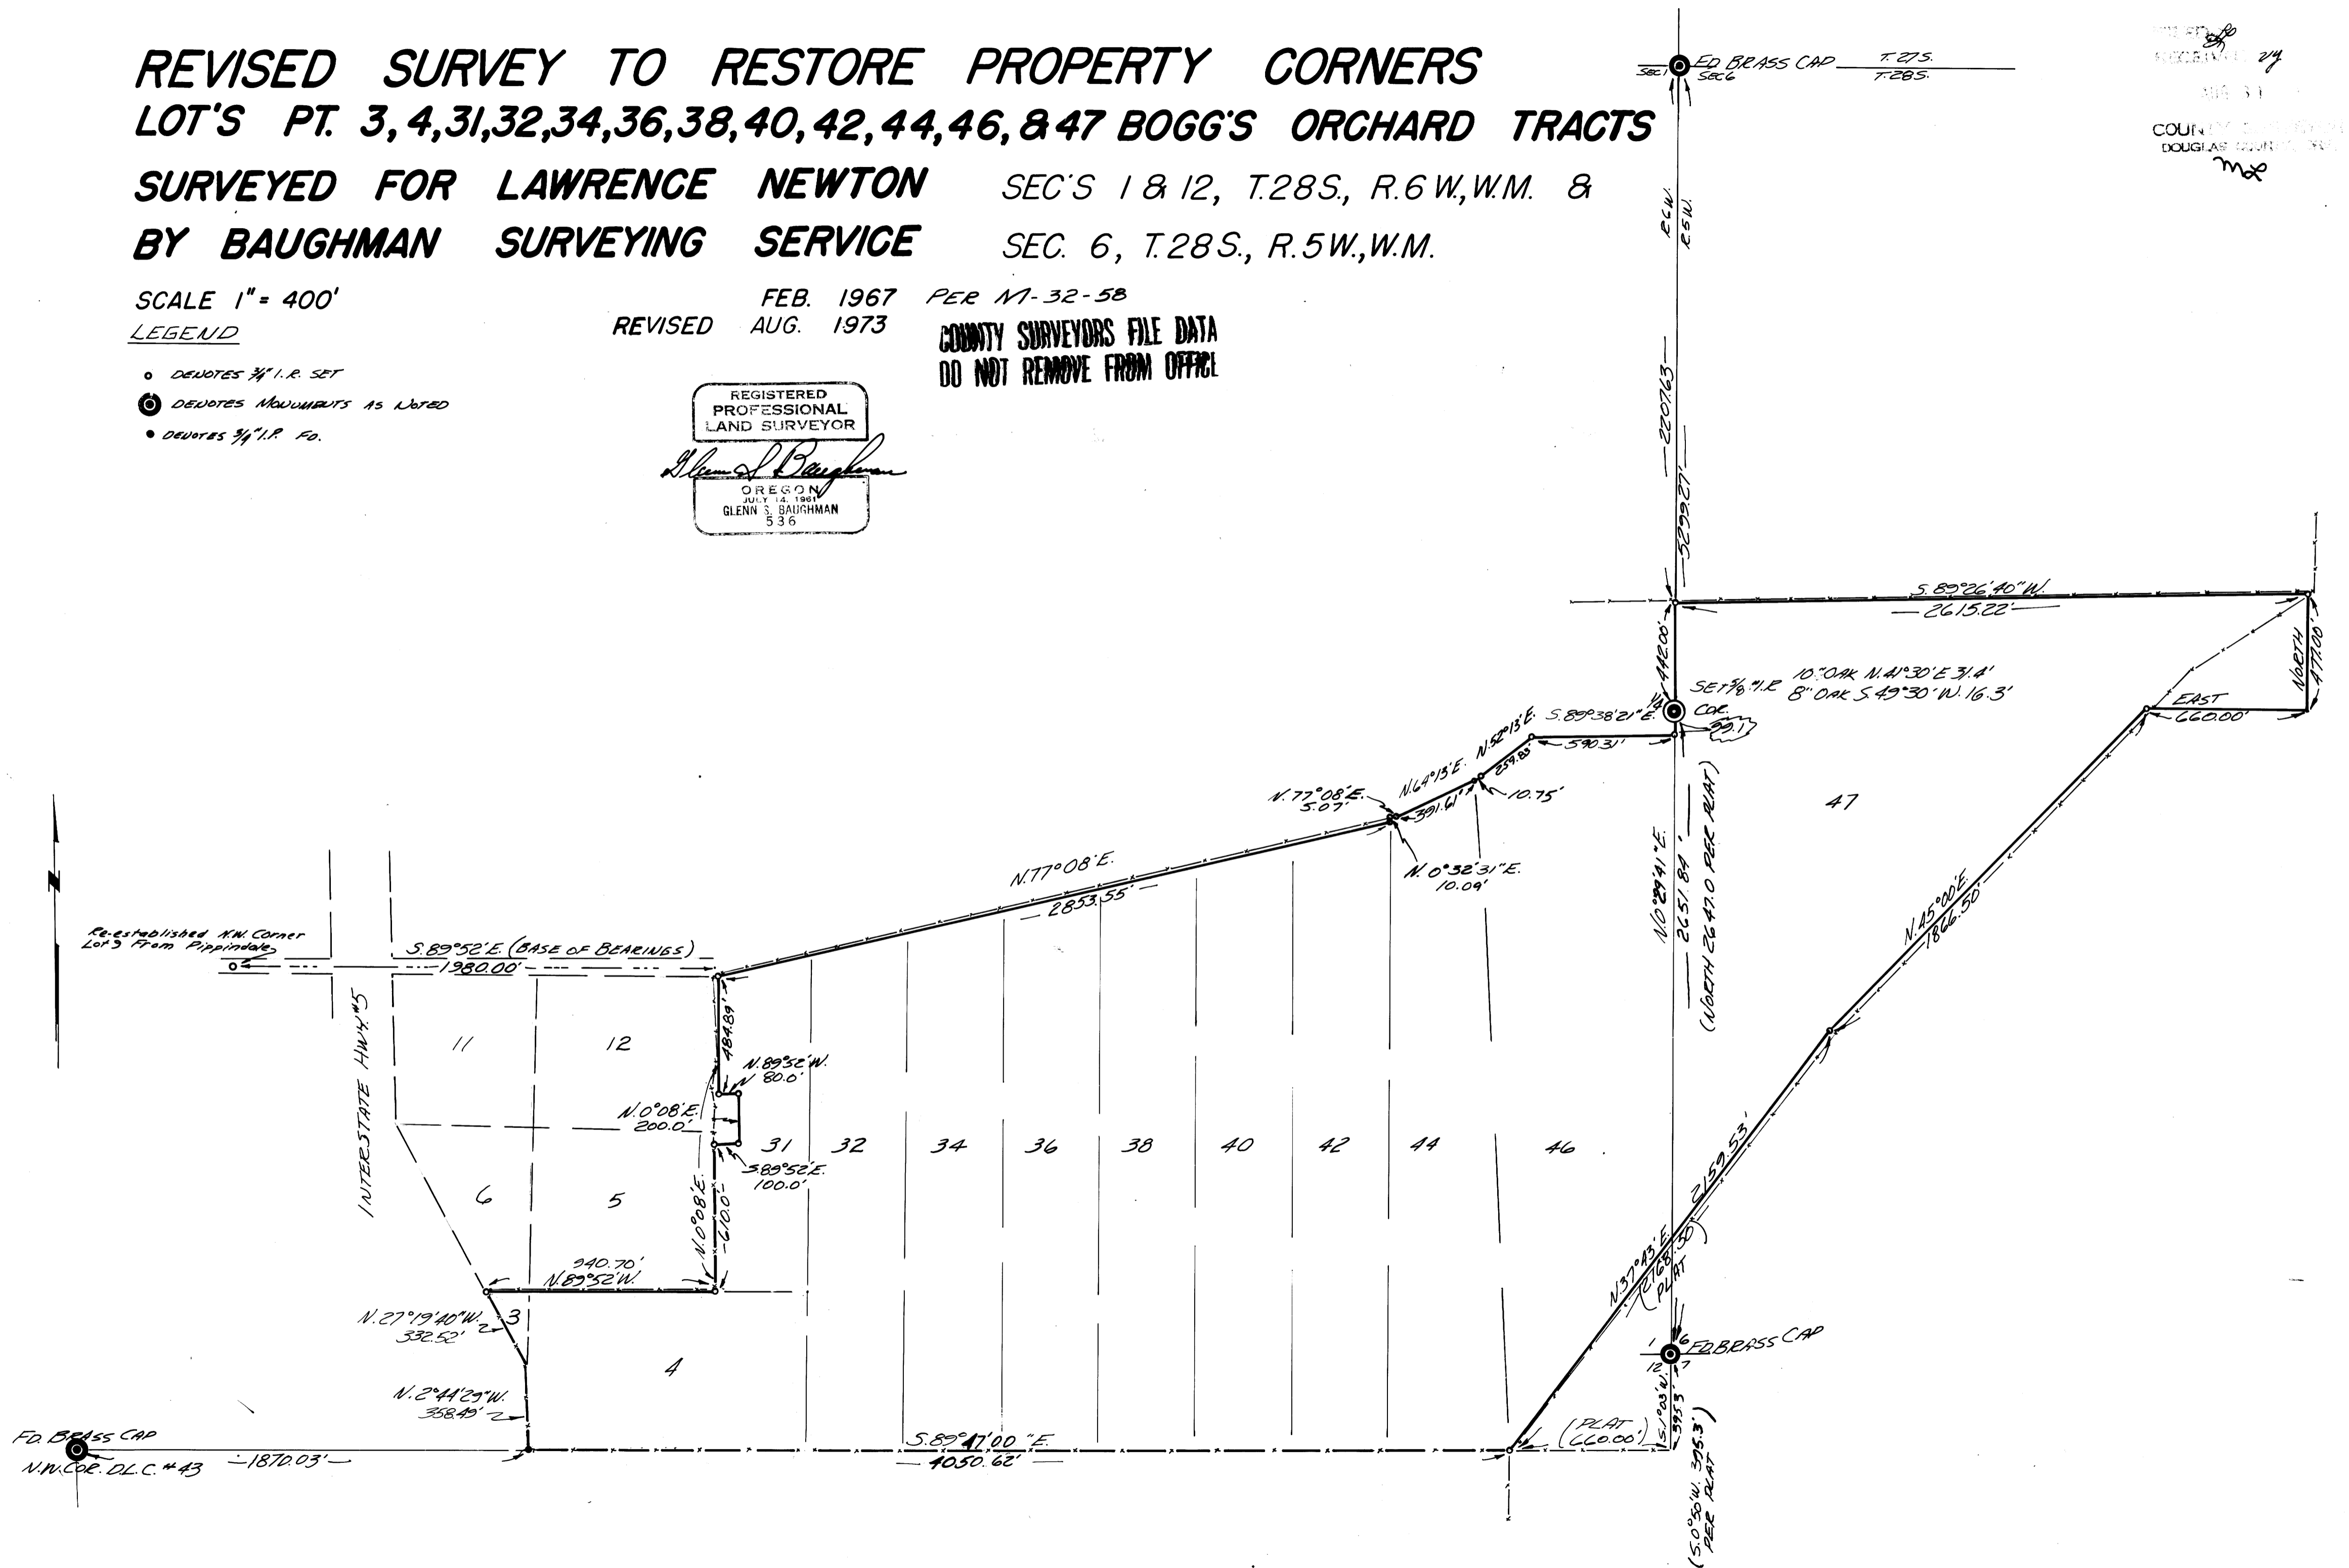

M.50 - 55