

DO NOT REMOVE FROM OFFICE

FILED 27  
RECEIVED me


OCT 19 1973

COUNTY SURVEYOR  
DOUGLAS COUNTY, ORE  
me

**SURVEY IN LOT 2, BLOCK 3, BROWN'S FAIR ACRES  
SECTION 24, TOWNSHIP 27 SOUTH, RANGE 6 WEST, W.M.  
Surveyed for M.F. Peterson by Don E. Garrett  
Oct. 1973**

Scale 1" = 50'

• Set 5/8" Iron Rod

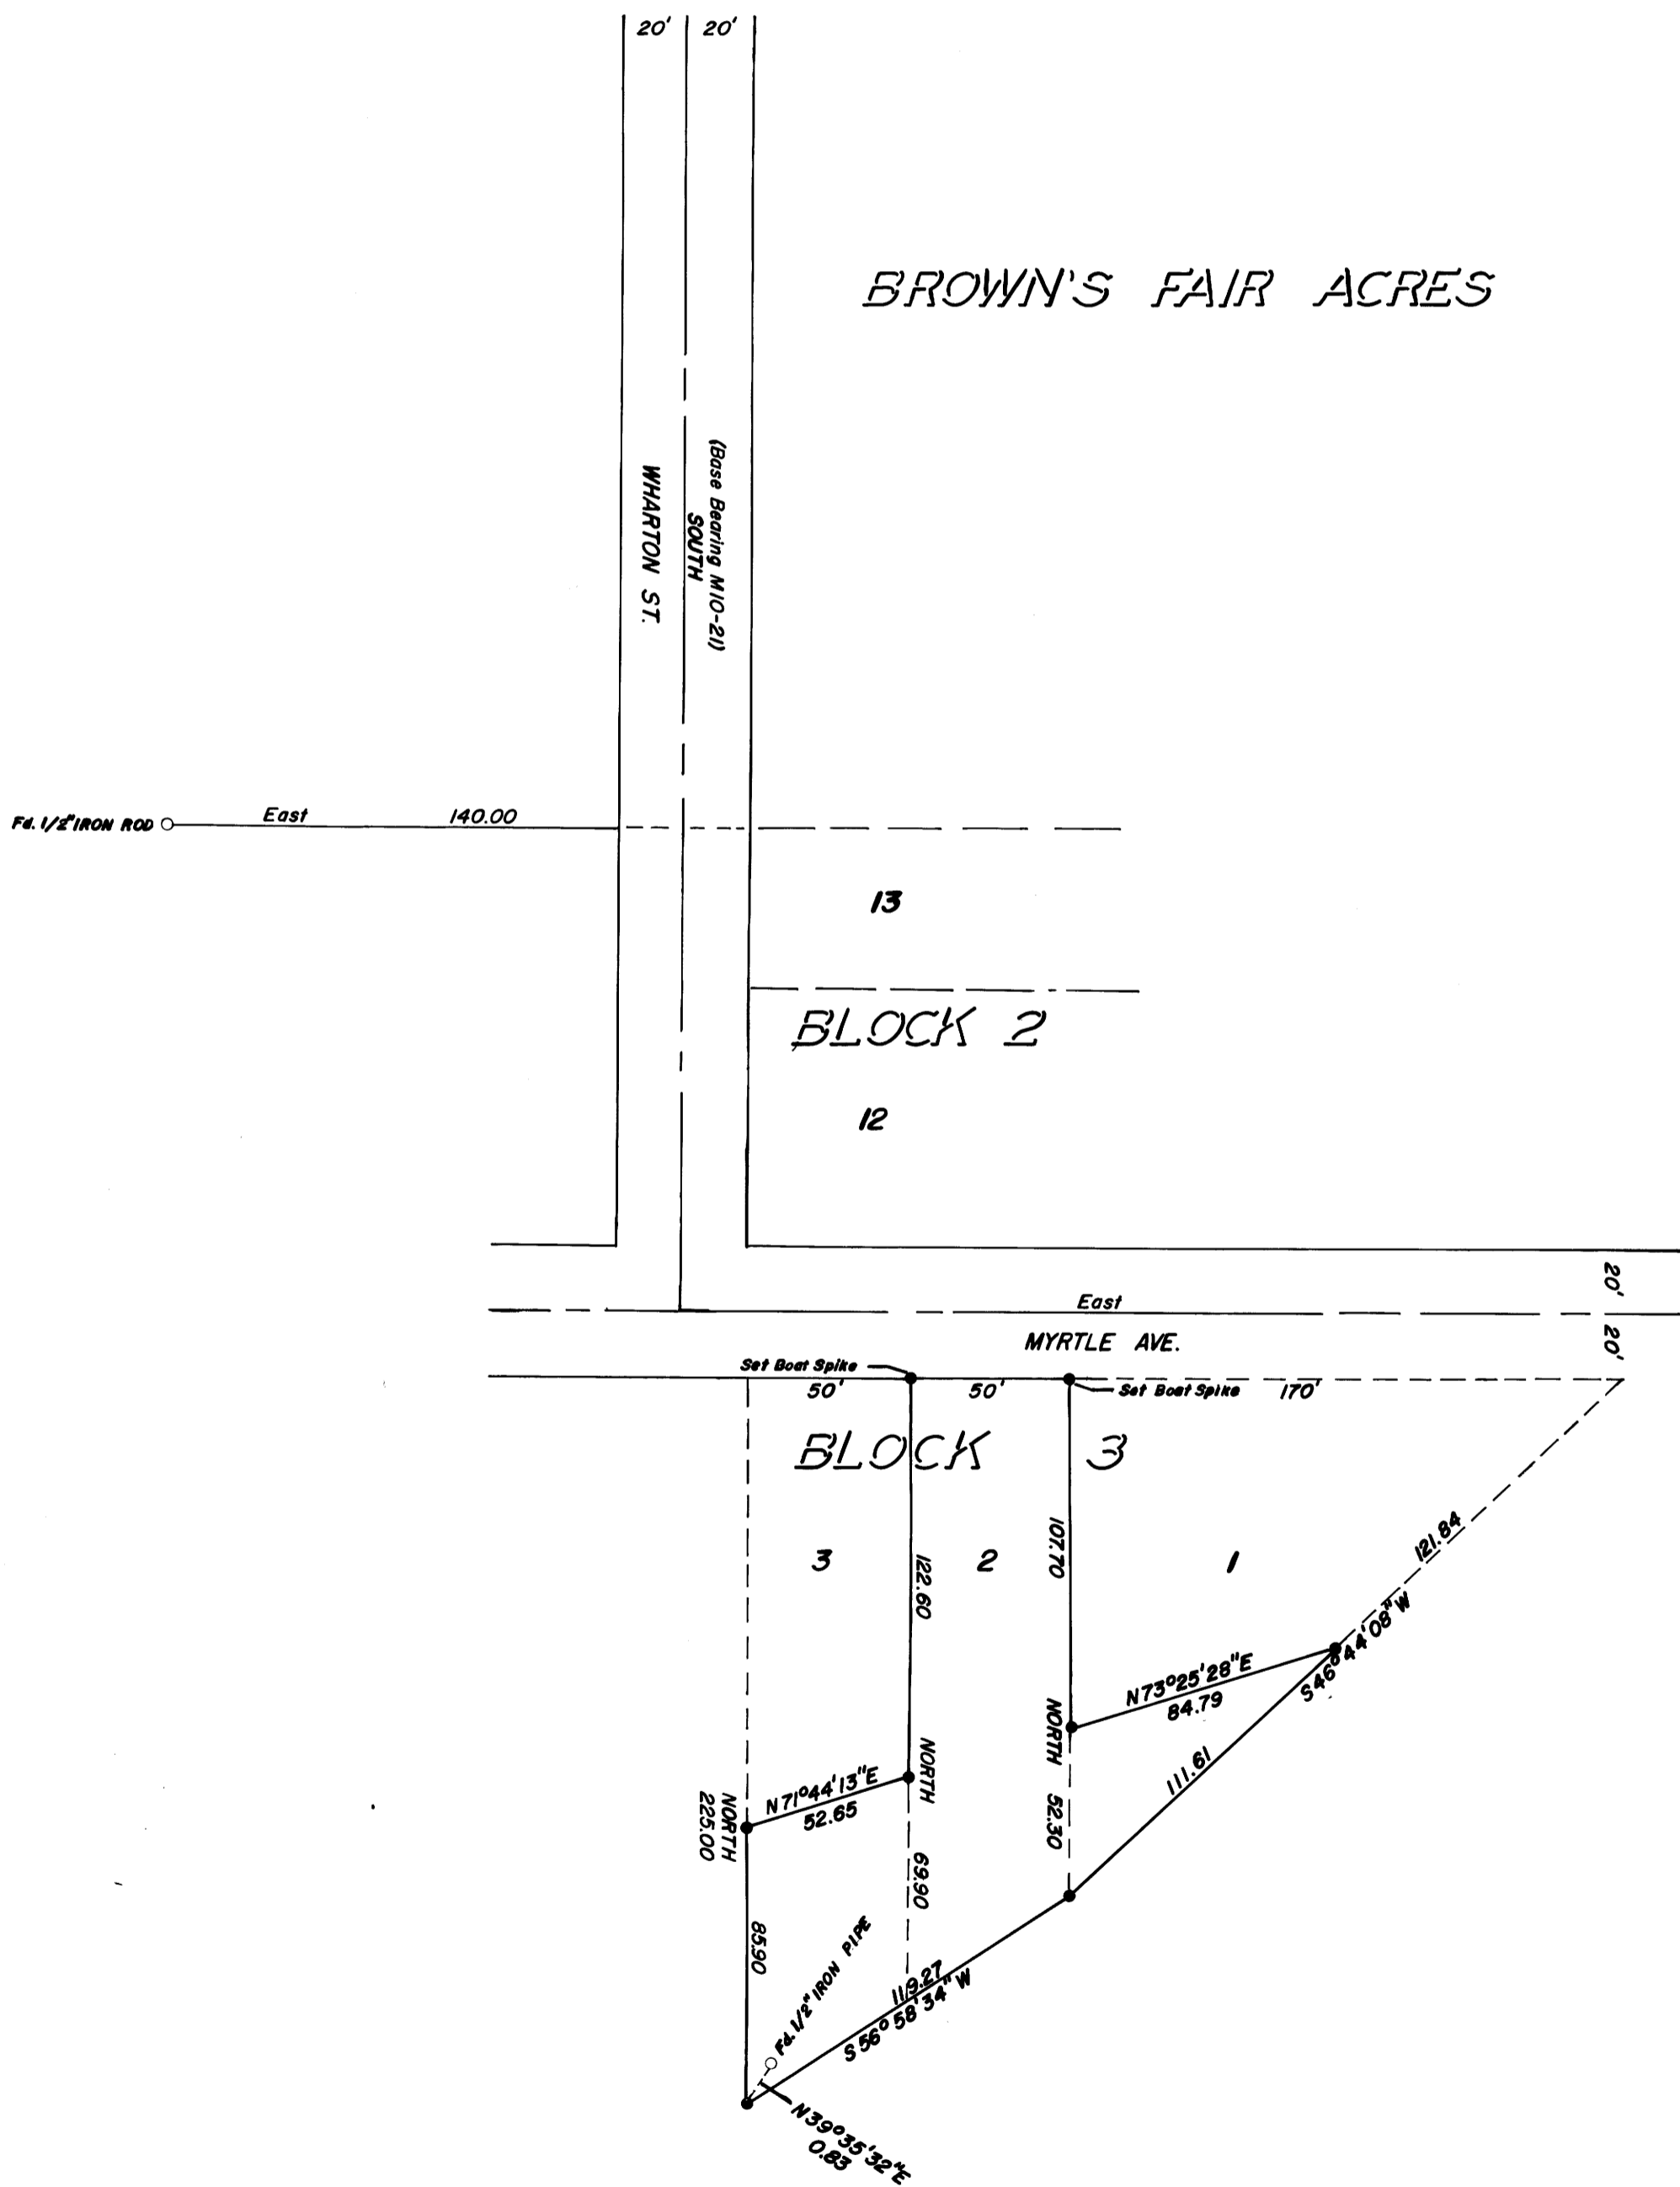

REGISTERED  
PROFESSIONAL  
LAND SURVEYOR

*Don E. Garrett*

OREGON  
1957-14-196  
DON E. GARRETT  
544