


M51-57

COUNTY SURVEYORS FILE DATA  
DO NOT REMOVE FROM OFFICE

FILED ✓  
RECEIVED 2/7  
DEC 12 1973  
COUNTY SURVEYOR  
DOUGLAS COUNTY, OREGON

RIO VISTA SUBDIVISION

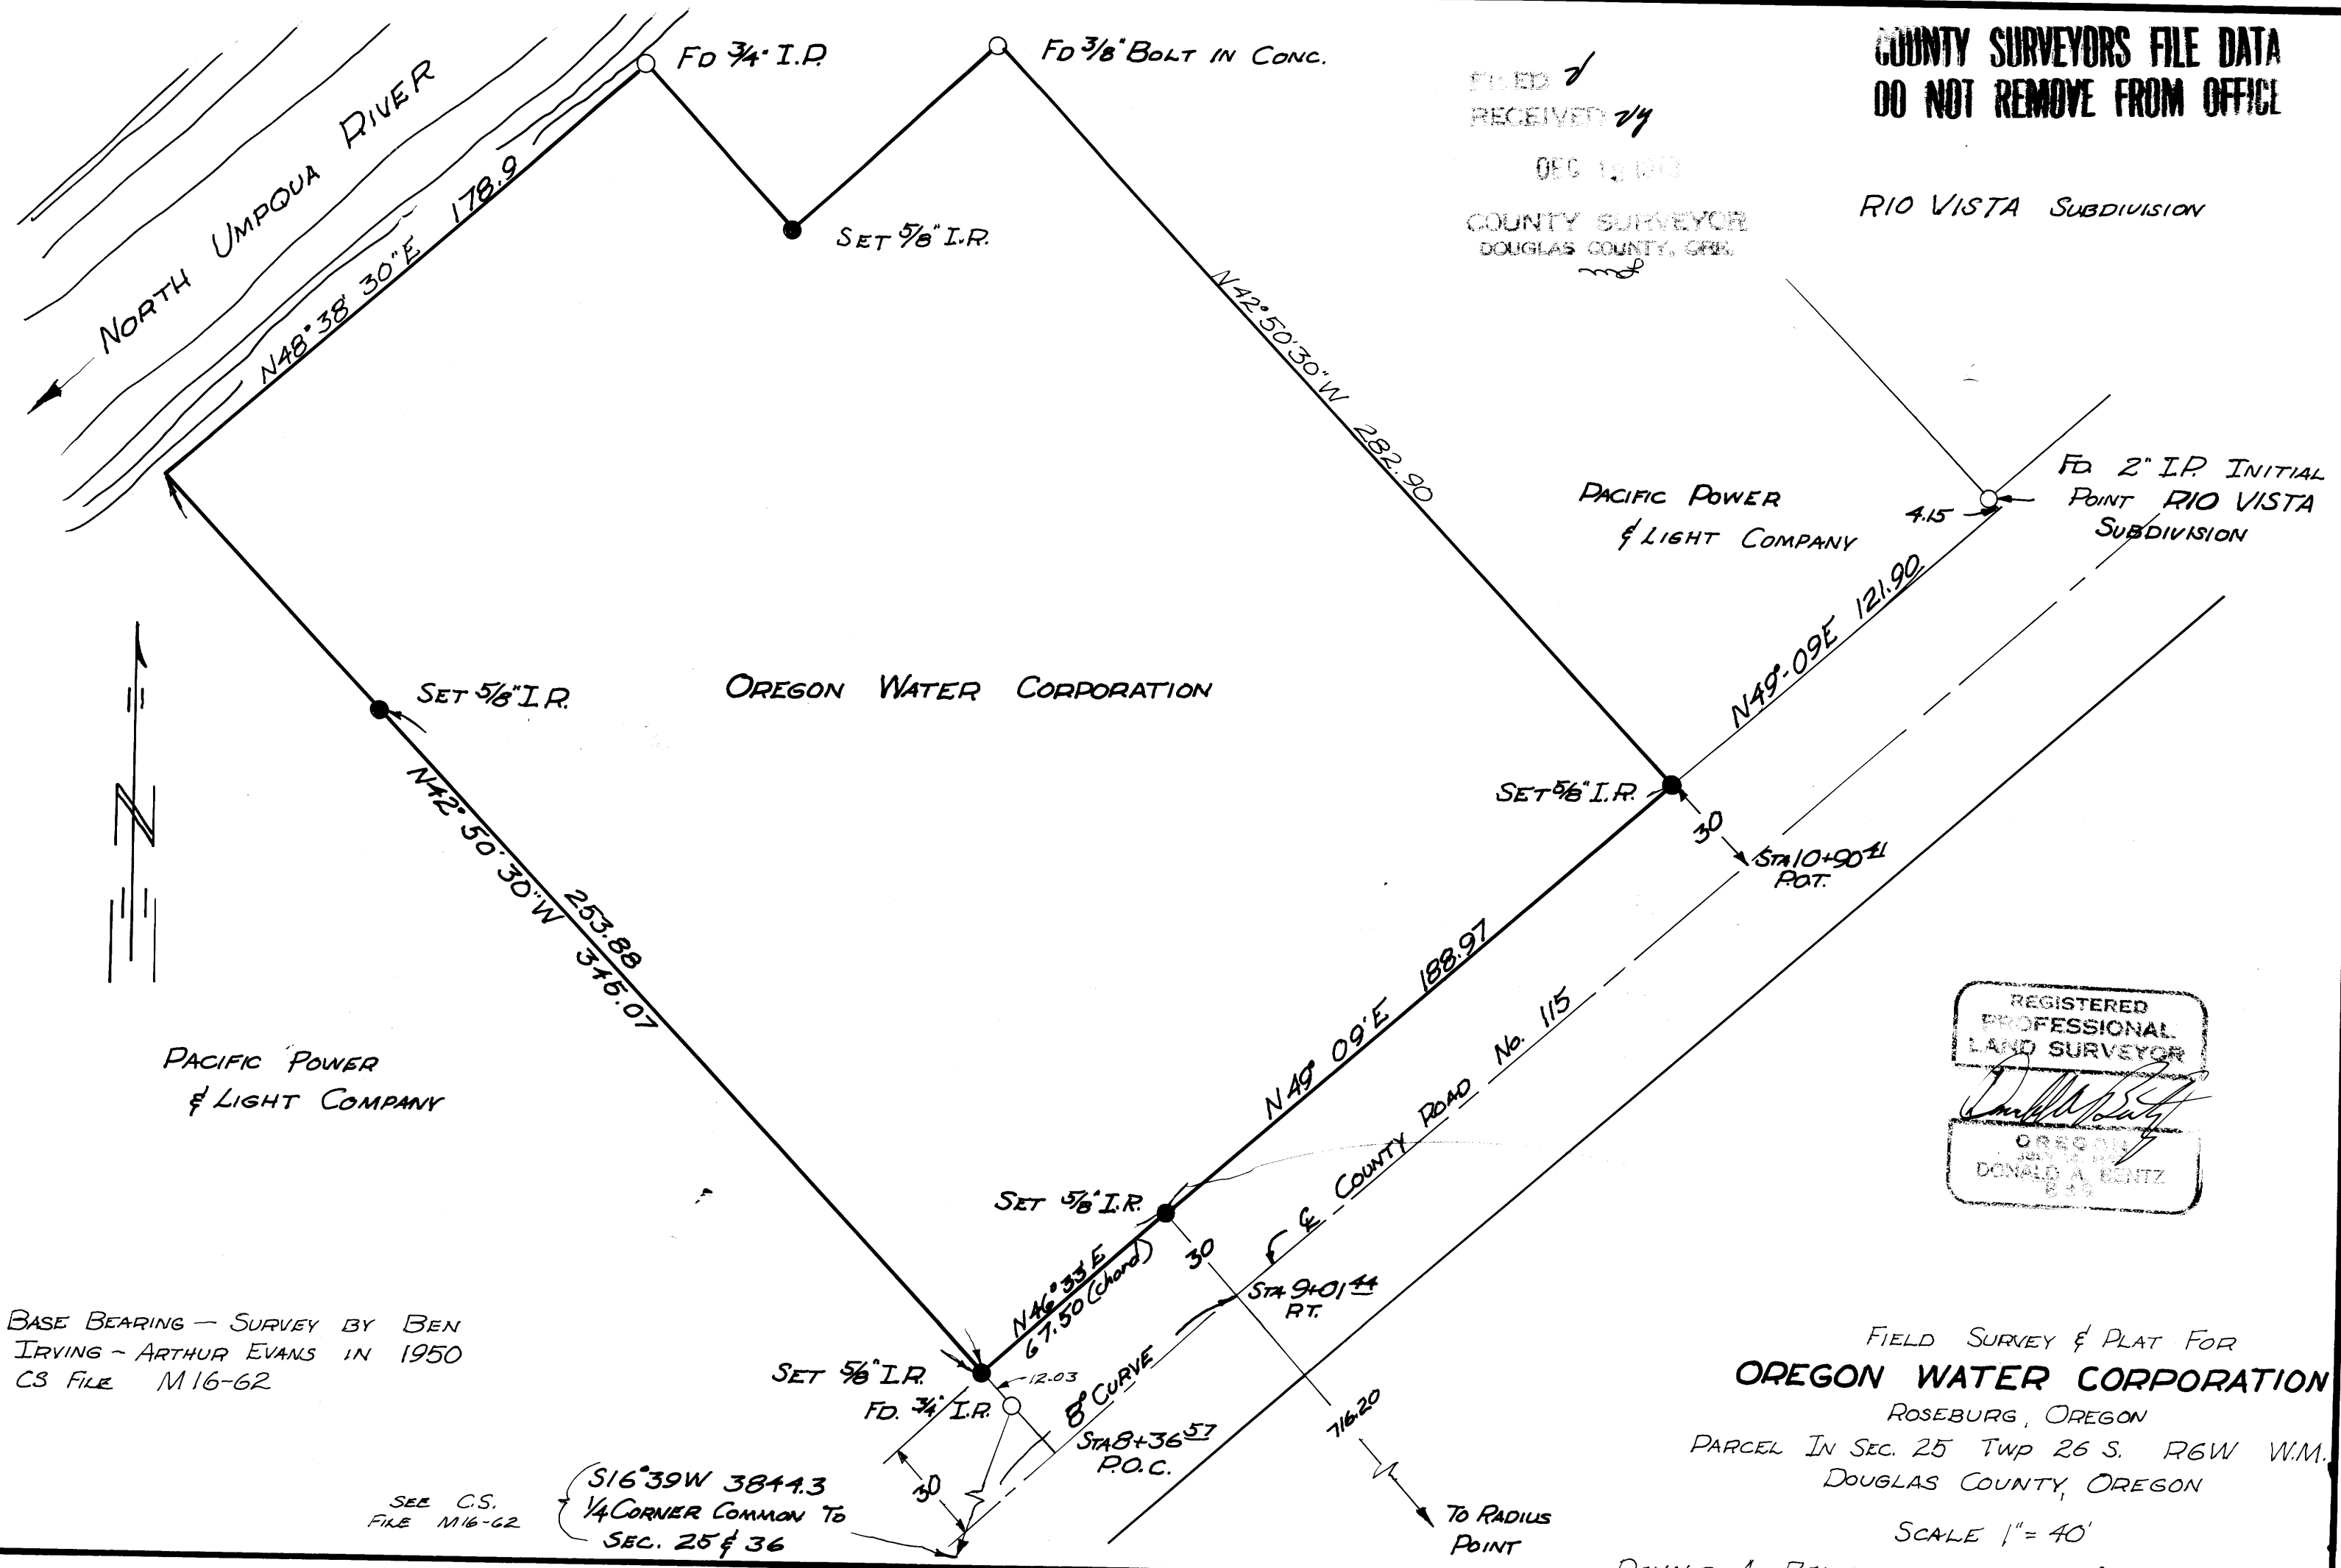

PACIFIC POWER  
& LIGHT COMPANY

OREGON WATER CORPORATION

PACIFIC POWER  
& LIGHT COMPANY

REGISTERED  
PROFESSIONAL  
LAND SURVEYOR

*Donald A. Bentz*

OREGON  
DONALD A. BENTZ

BASE BEARING - SURVEY BY BEN  
IRVING - ARTHUR EVANS IN 1950  
CS FILE M16-62

SEE C.S.  
FILE M16-62

$S16^{\circ}39'W$  3844.3  
 $\frac{1}{4}$  CORNER COMMON TO  
SEC. 25 & 36

FIELD SURVEY & PLAT FOR  
**OREGON WATER CORPORATION**

ROSEBURG, OREGON  
PARCEL IN SEC. 25 TWP 26 S. R6W W.M.  
DOUGLAS COUNTY, OREGON

SCALE 1" = 40'

DONALD A. BENTZ

APRIL 1973

M51-57