


FILED  
RECEIVED 24  
DEC 10 1973  
COUNTY SURVEYOR  
DOUGLAS COUNTY, ORE.  
mf

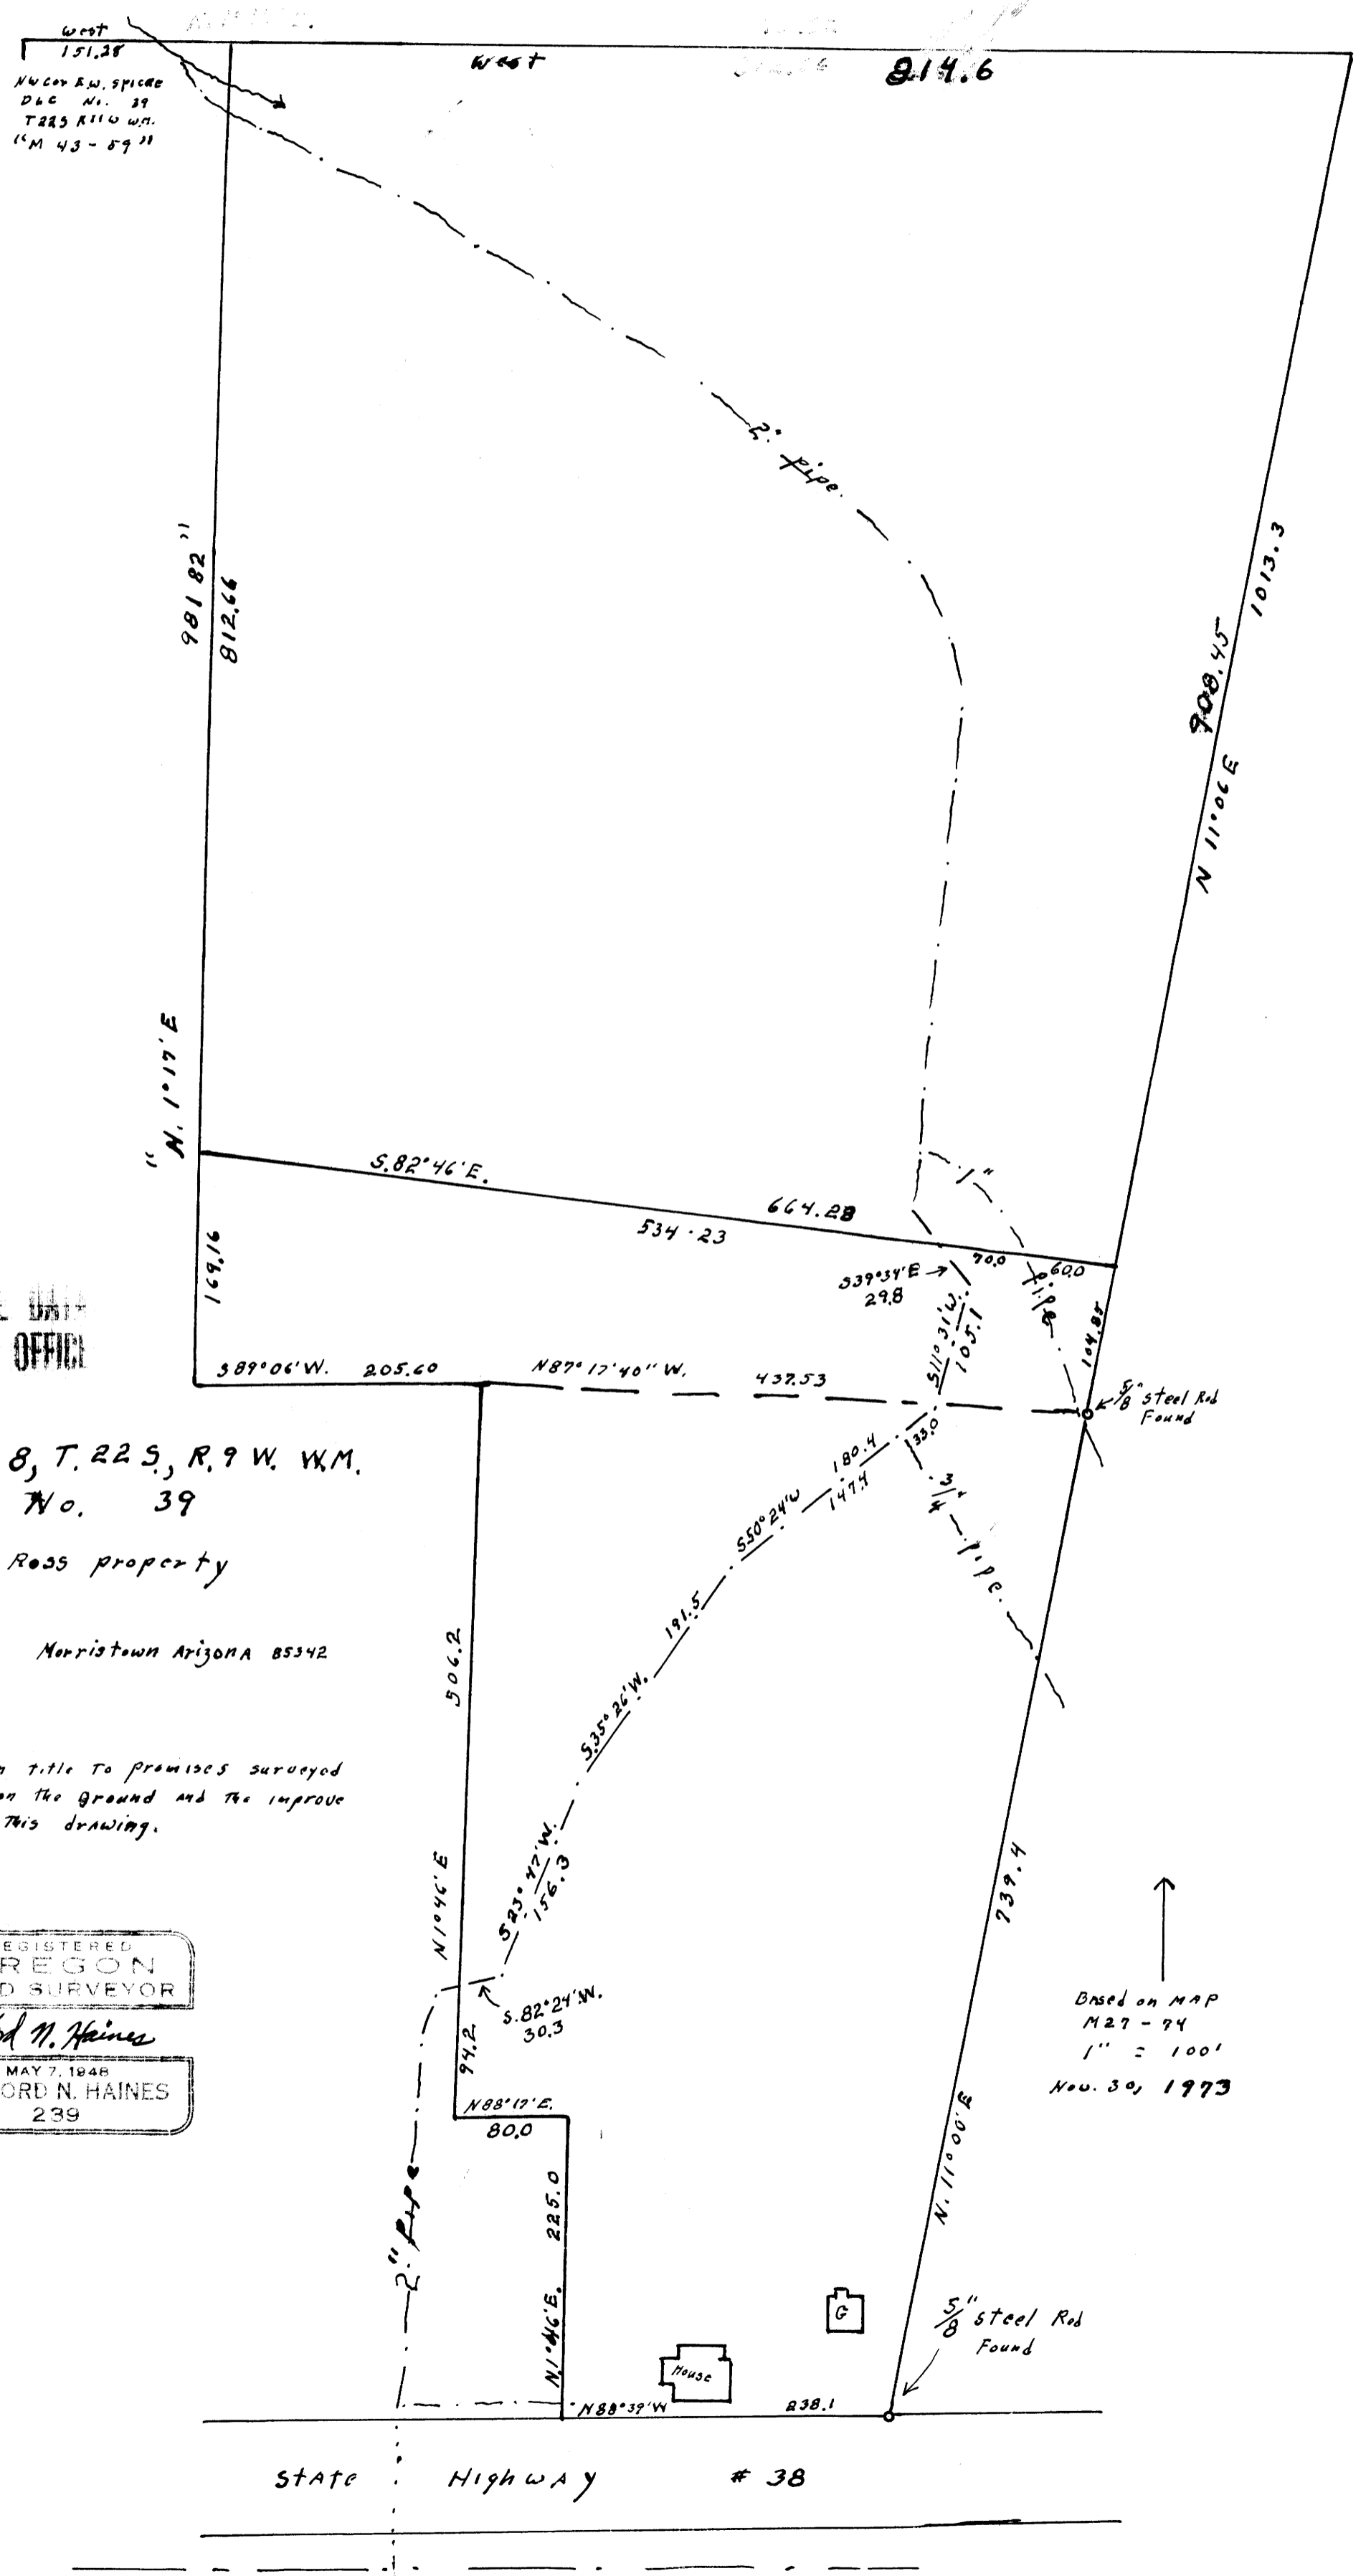

COUNTY SURVEYORS WILL DATE  
AND REMOVE FROM OFFICE

SURVY IN SECTS. 5+8, T. 22 S, R. 9 W. W.M.  
E.W. SPICER D.L.C. No. 39  
PIPE LINE ACROSS ERIC ROSS PROPERTY  
FOR  
Mrs Maud L. Jackson Morristown Arizona 85342

Certificate  
To all parties interested in title to premises surveyed  
This survey was actually made on the ground and the improve-  
ments are as shown on this drawing.

REGISTERED  
OREGON  
LAND SURVEYOR  
Wilford N. Haines  
MAY 7, 1948  
WILFORD N. HAINES  
239

Based on MAP  
M27-74  
1" = 100'  
Nov. 30, 1973