

SURVEY FOR DESCRIPTION FOR MORTGAGE PURPOSES

IN SECTION 18, T.29S. R.4.W.W.M.

FOR: WILLIAM KINGSLEY

BY: BAUGHMAN SURVEYING SERVICE


JANUARY 1974 SCALE: 1"=100'

COUNTY SURVEYORS FILE DATA
DO NOT REMOVE FROM OFFICE

FILED 7
RECEIVED Pd

JAN 21 1974

COUNTY SURVEYOR
DOUGLAS COUNTY, ORE.
mX

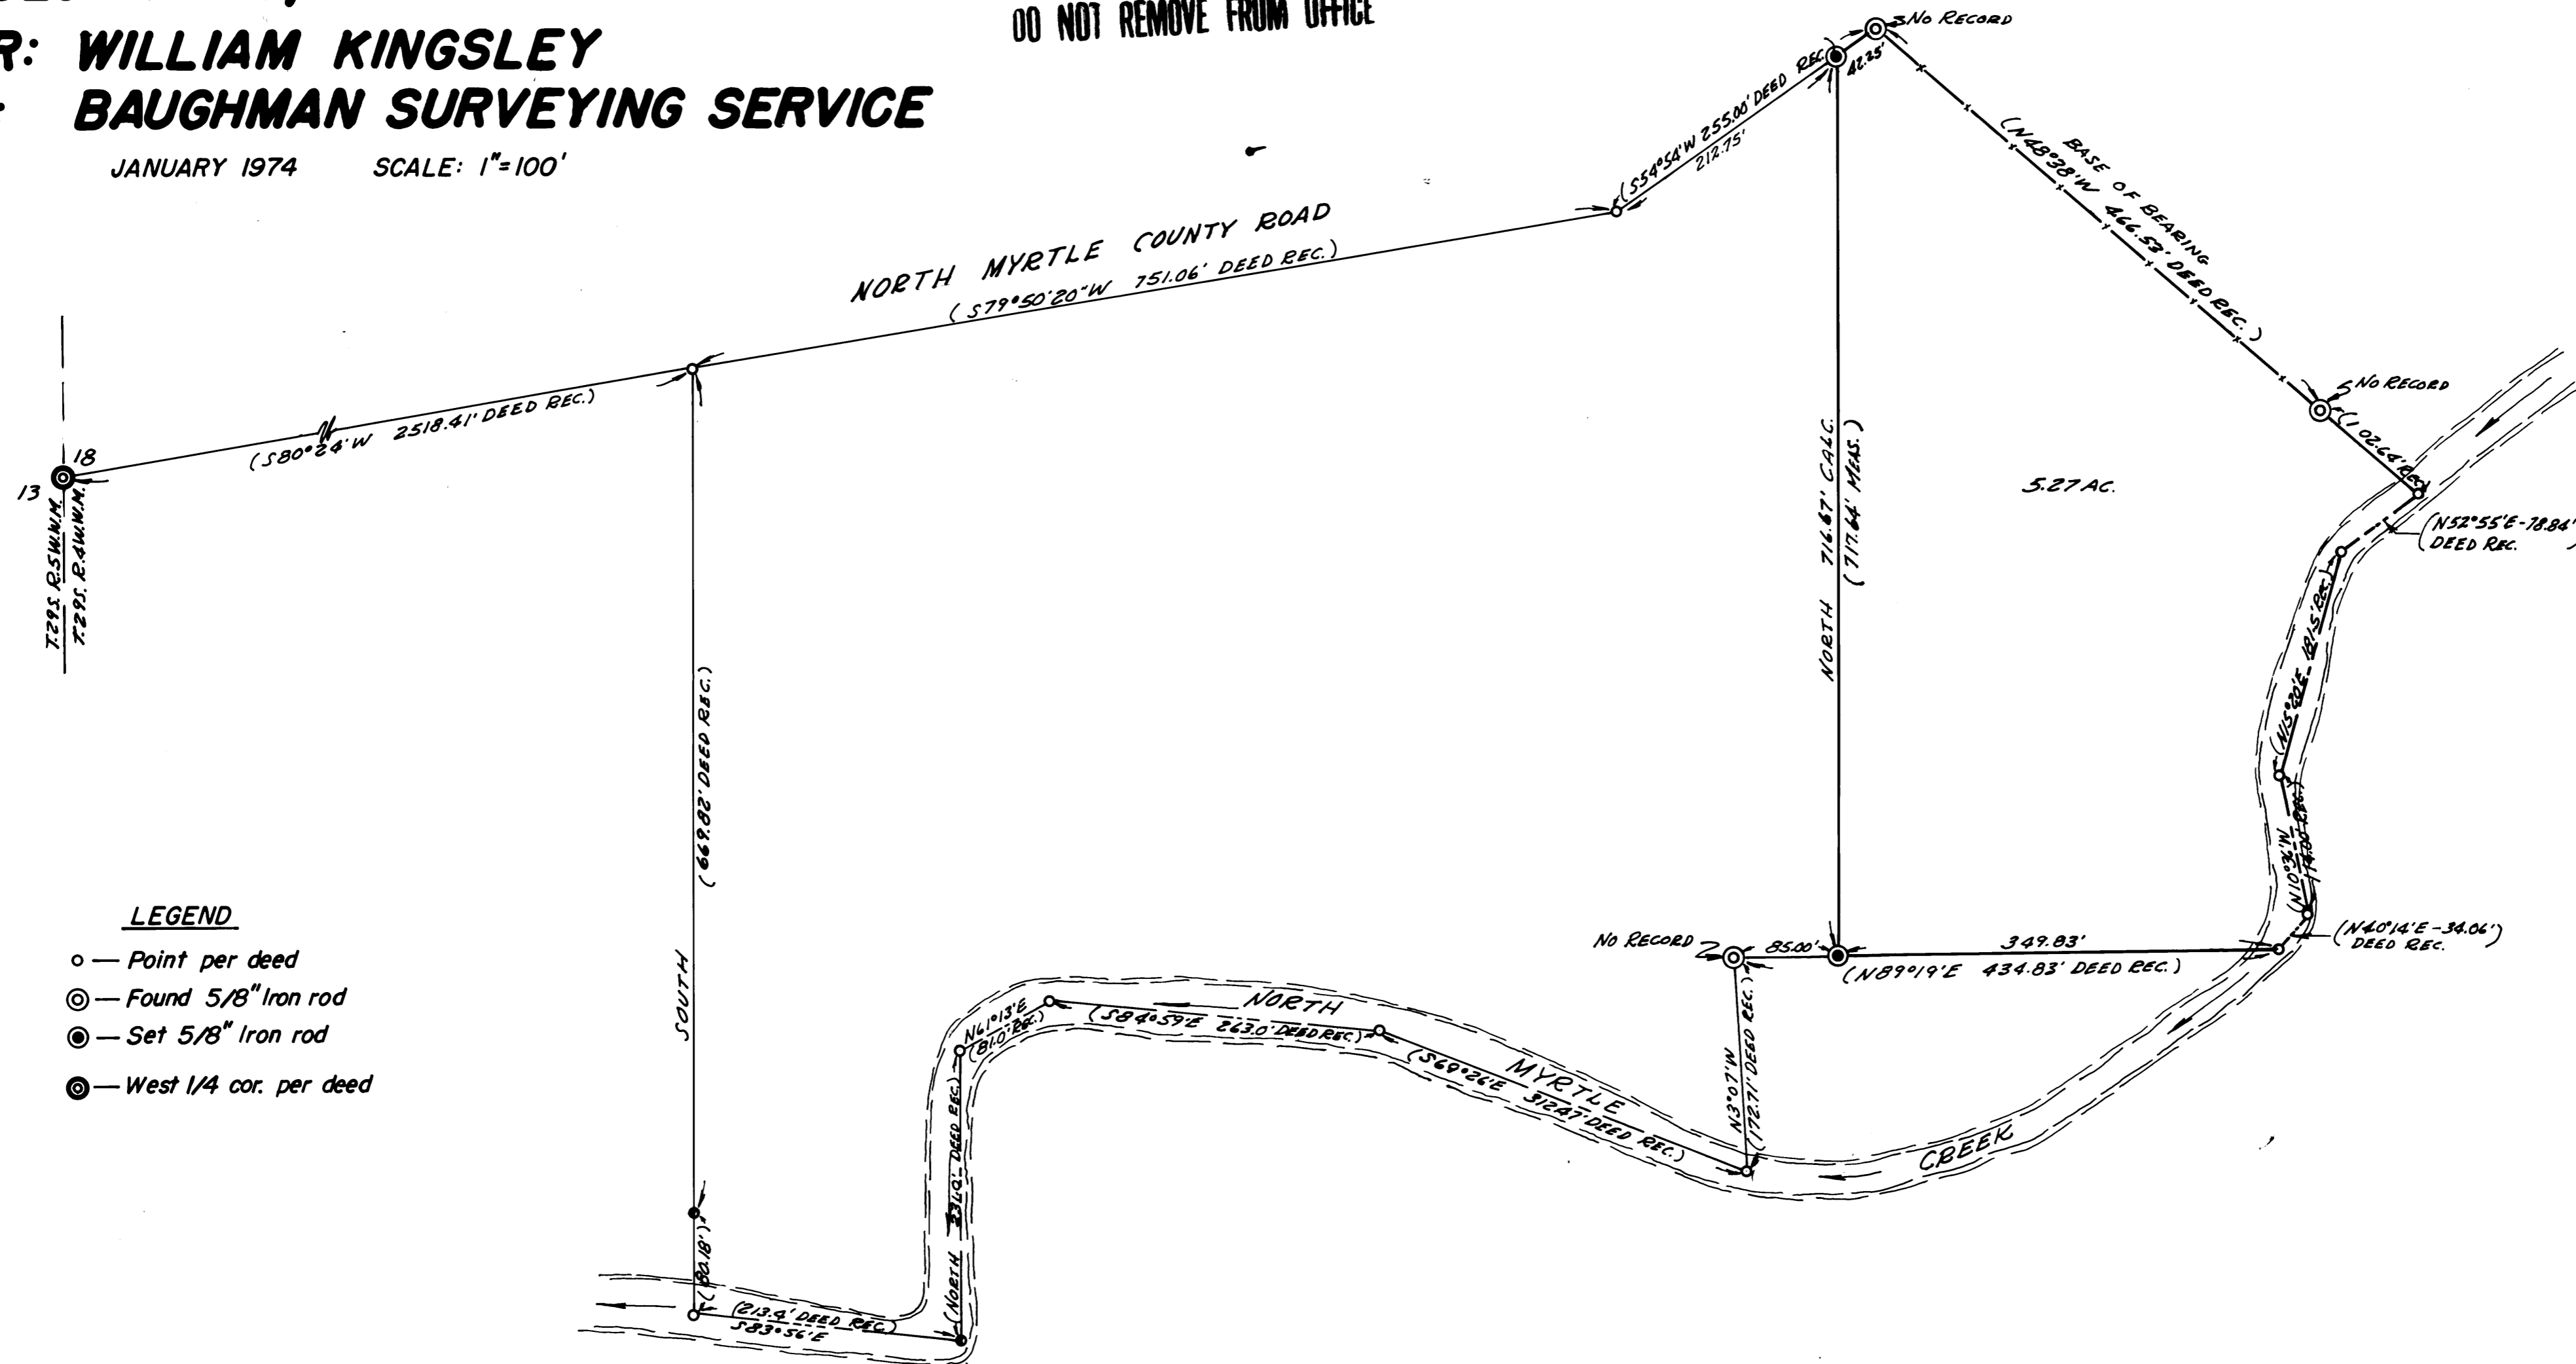

BASED ON DEED DESCRIPTION

MAP FILE 52-178