

COUNTY SURVEYORS FILE DATA
DO NOT REMOVE FROM OFFICE

SURVEY FOR DEED & EASEMENT DESCRIPTION IN SEC. 35, T27 S, R5 W. W.M.

SURVEYED FOR - RAY KARCHER
SURVEYED BY - W.S. BARNES


FEB. 1974
SCALE 1" = 40'

FILED
RECEIVED *Od*

FEB 11 1974

COUNTY SURVEYOR
DOUGLAS COUNTY, ORE.

35-36 1/4 cor.
T27S, R5W.

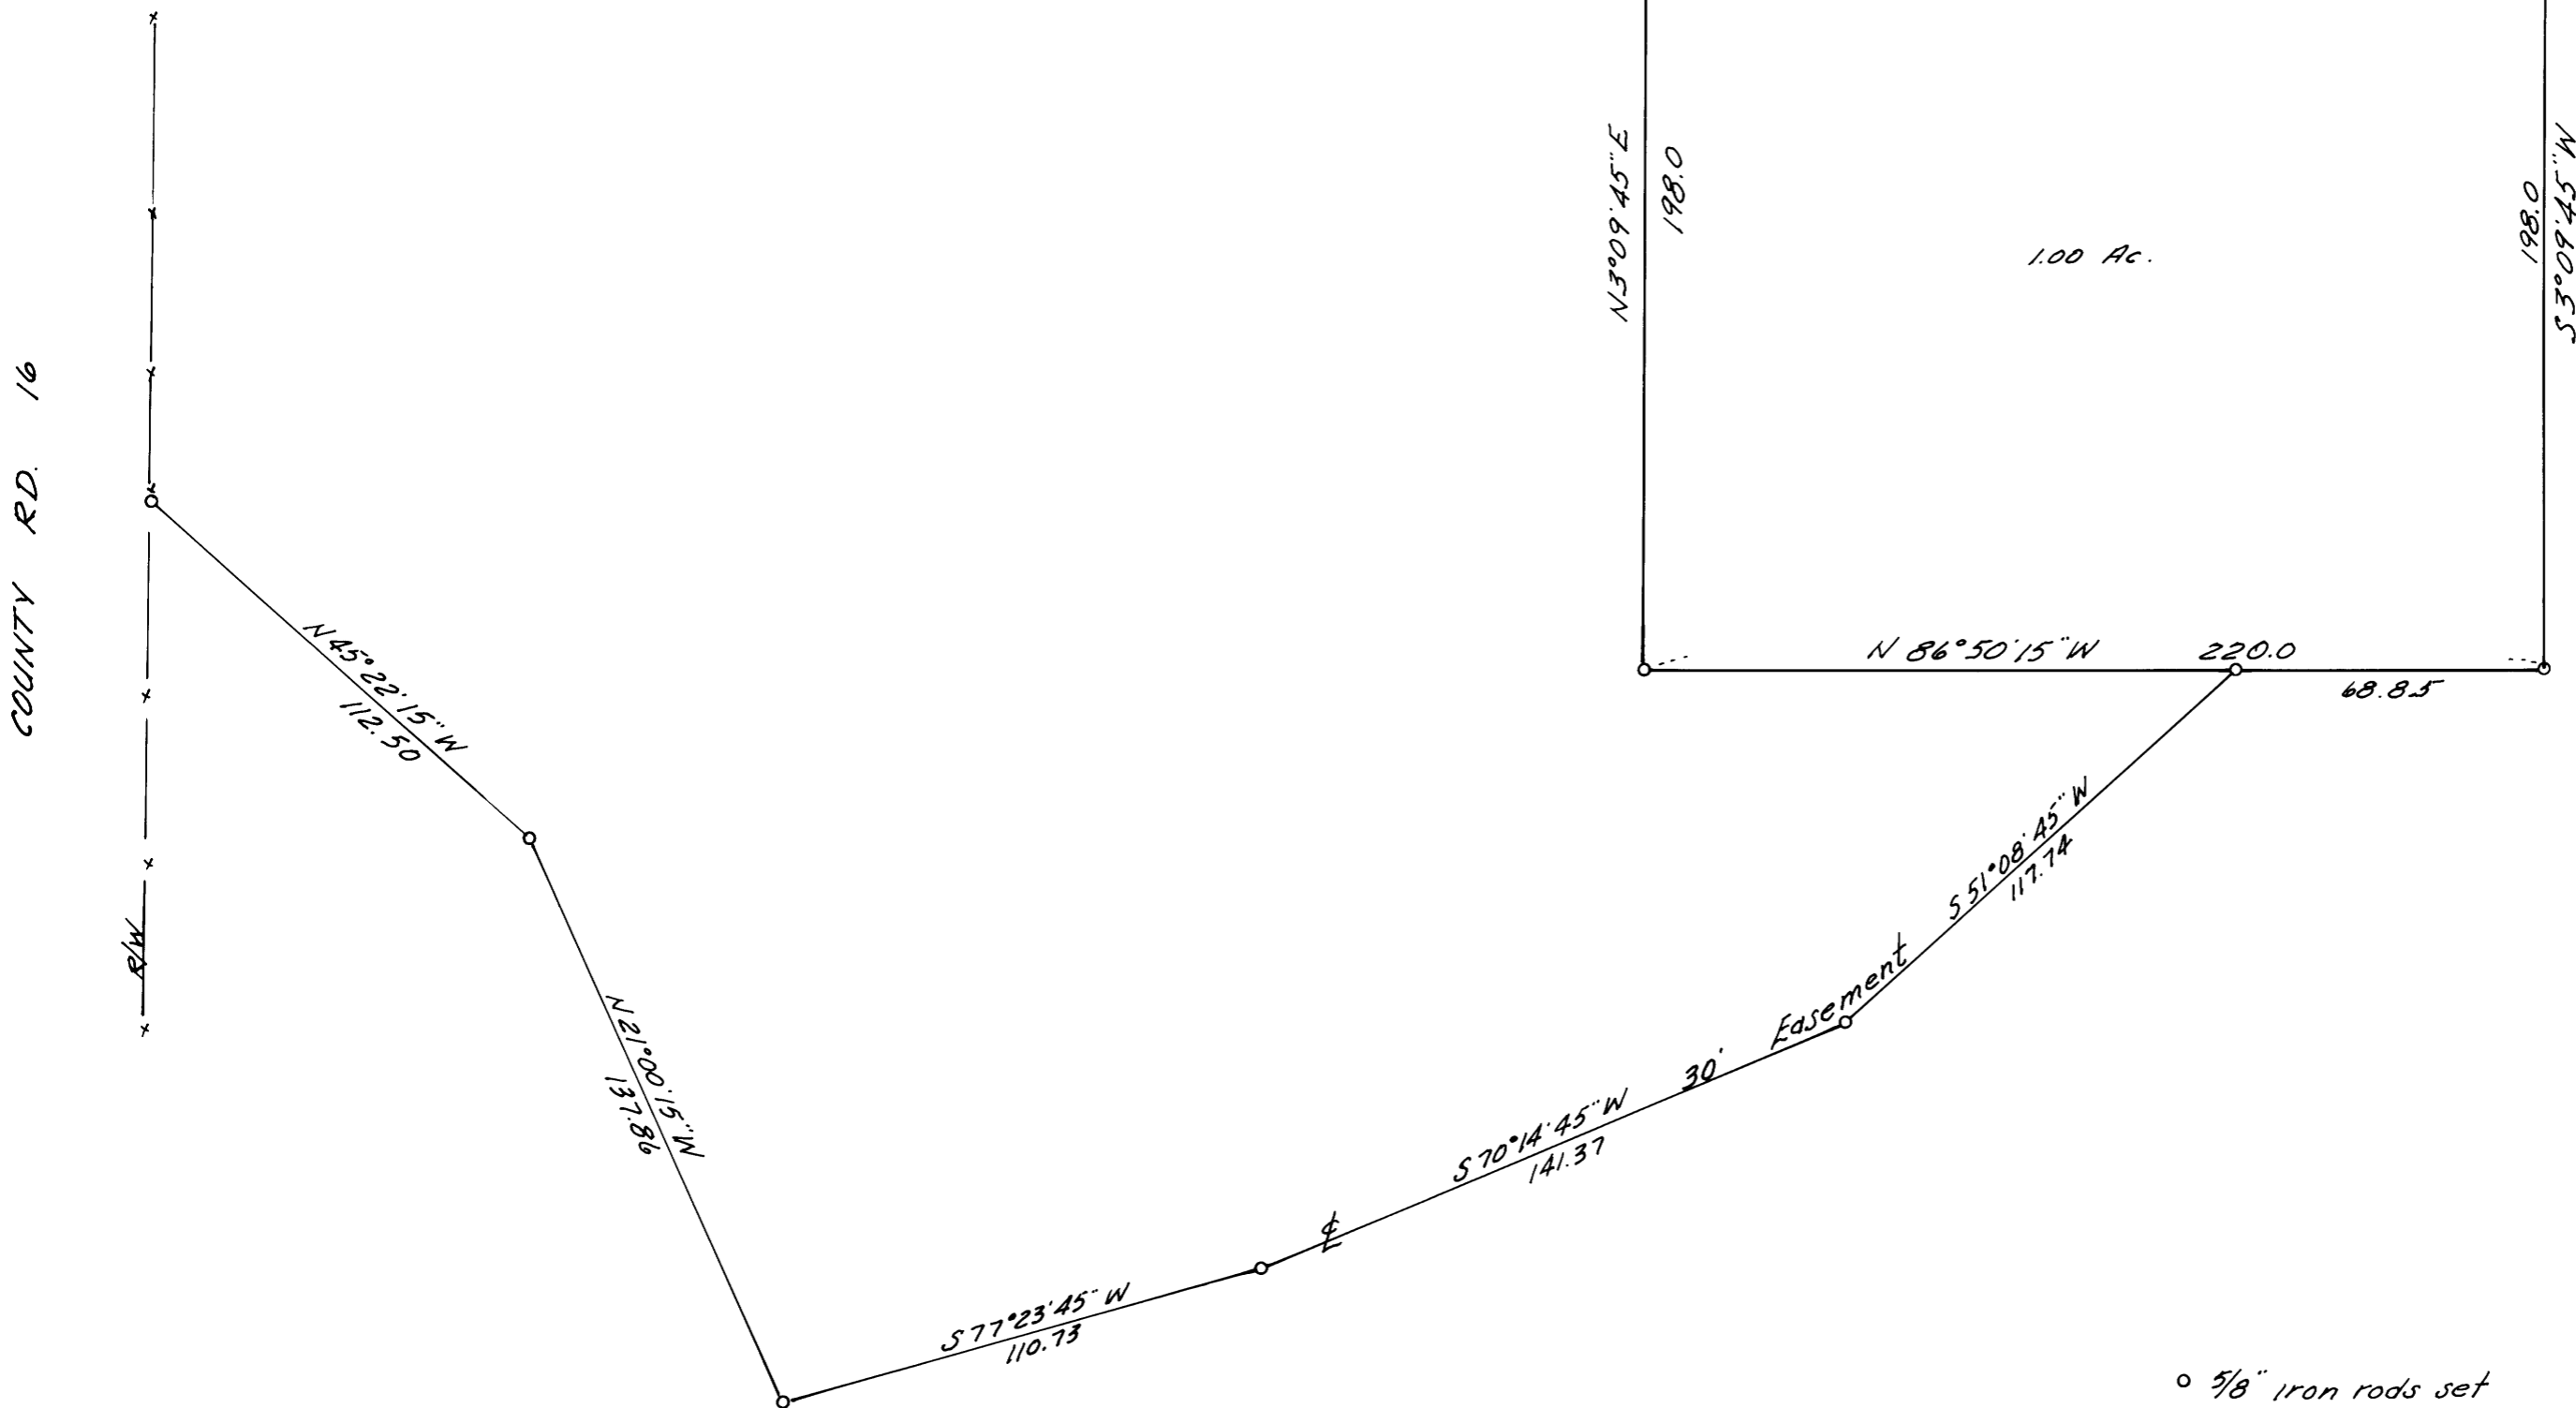

o 5/8" iron rods set
Base of bearings taken from
C.S. File 2-42.



COUNTY RD. 16

152 - 35

152 - 35