


SURVEY FOR PROPERTY CORNERS
IN LOT 20, BLK. 18 OF JONES ADDITION TO ROSEBURG
SEC. 18, T.27S., R.5W., W.M.
FOR - RALPH EYRE JR.
BY - BAUGHMAN SURVEYING SERVICE
FEBRUARY 1974

COUNTY SURVEYORS FILE DATA
 DO NOT REMOVE FROM OFFICE

FILED 7
 RECEIVED *Ed*
 FEB 27 1974

COUNTY SURVEYOR
 DOUGLAS COUNTY, ORE.
m

MAP FILE M 52-43

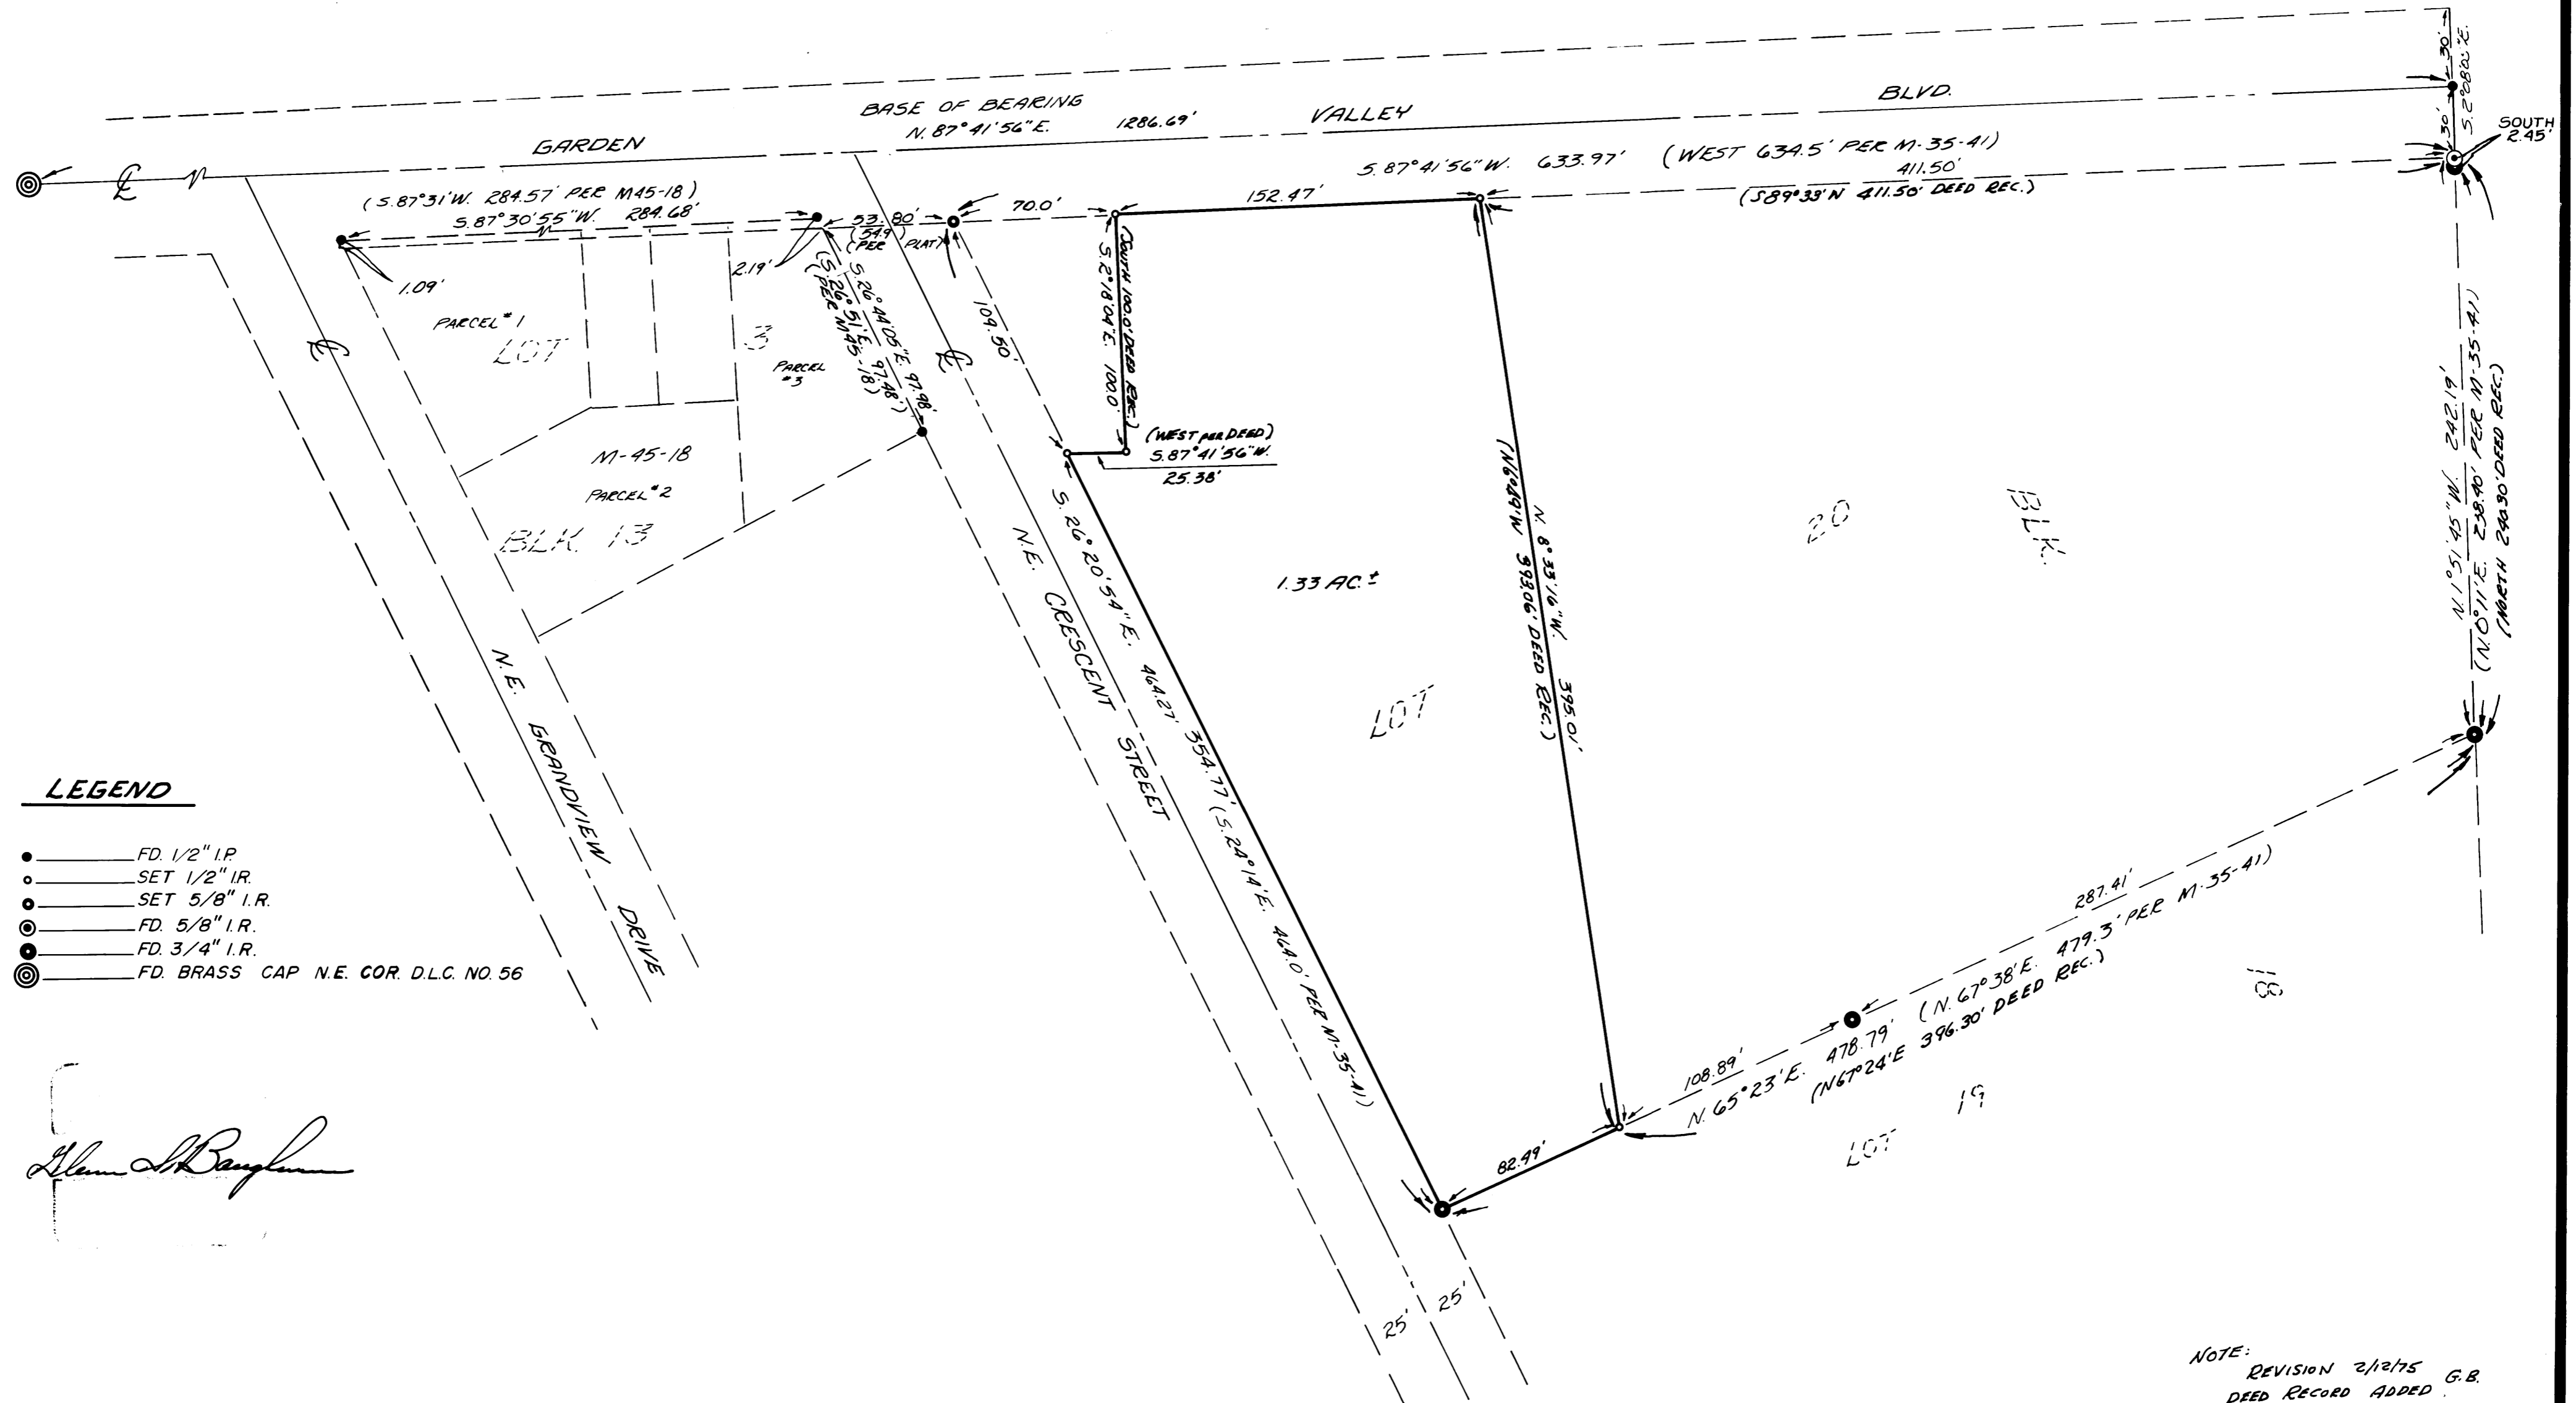

BASED ON M 31-1

MAP FILE M 52-43