


FILED *✓*
RECEIVED *21*
FEB 27 1974
COUNTY SURVEYOR
DOUGLAS COUNTY, ORE.
mz

MAP FILE M52 - 45

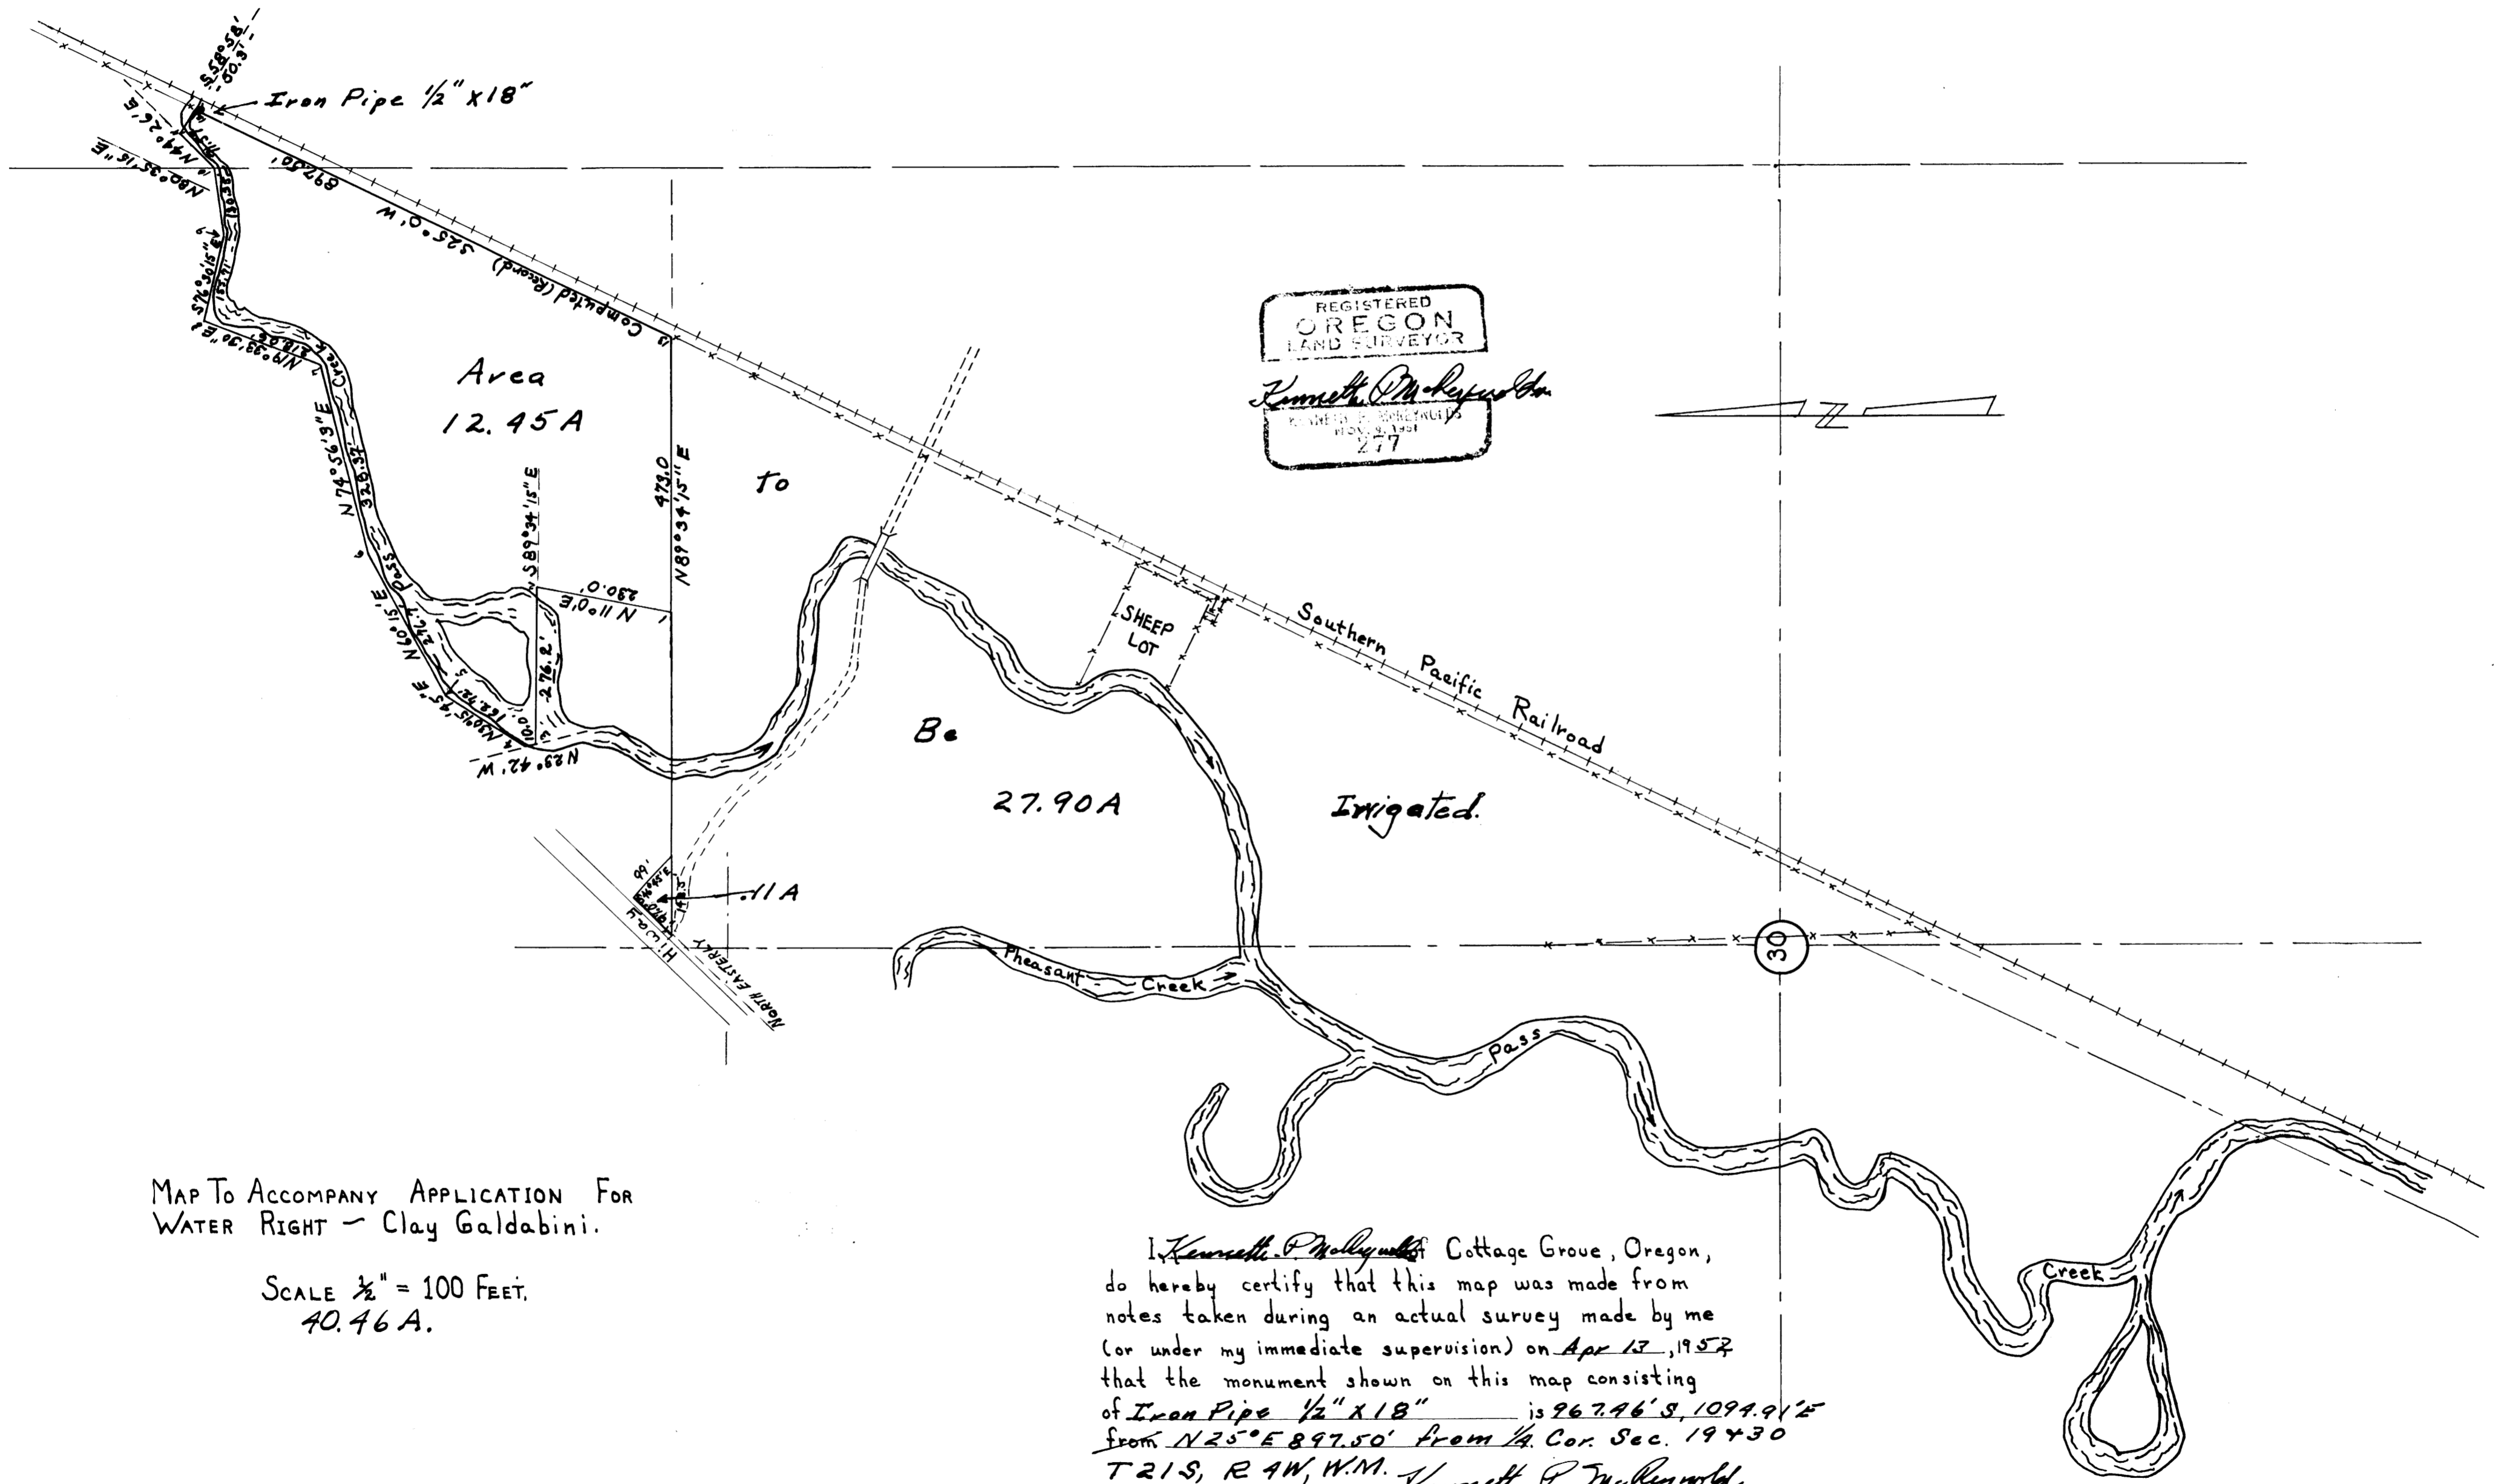

MAP TO ACCOMPANY APPLICATION FOR
WATER RIGHT - Clay Galdabini.

SCALE 1/2" = 100 FEET.
40.46A.

I, Kenneth P. McReynolds Cottage Grove, Oregon,
do hereby certify that this map was made from
notes taken during an actual survey made by me
(or under my immediate supervision) on Apr 17, 1952
that the monument shown on this map consisting
of Iron Pipe 1/2" x 18" is 267.96' S, 1094.91' E
from N 25° E 897.50' from 1/4 Cor. Sec. 19 + 30
T 21 S, R 4 W, W.M. Kenneth P. McReynolds.

MAP FILE M52 - 45