

SUBDIVISION OF SECTION 4

T.26S., R.7W.

Douglas County, Ore.

COUNTY SURVEYORS FILE DATA
DO NOT REMOVE FROM OFFICE


FILED ✓
RECEIVED 2/4

FEB 28 1974

COUNTY SURVEYOR
DOUGLAS COUNTY, ORE.
mj

Feb. 25, 1974

Scale 1" = 600'

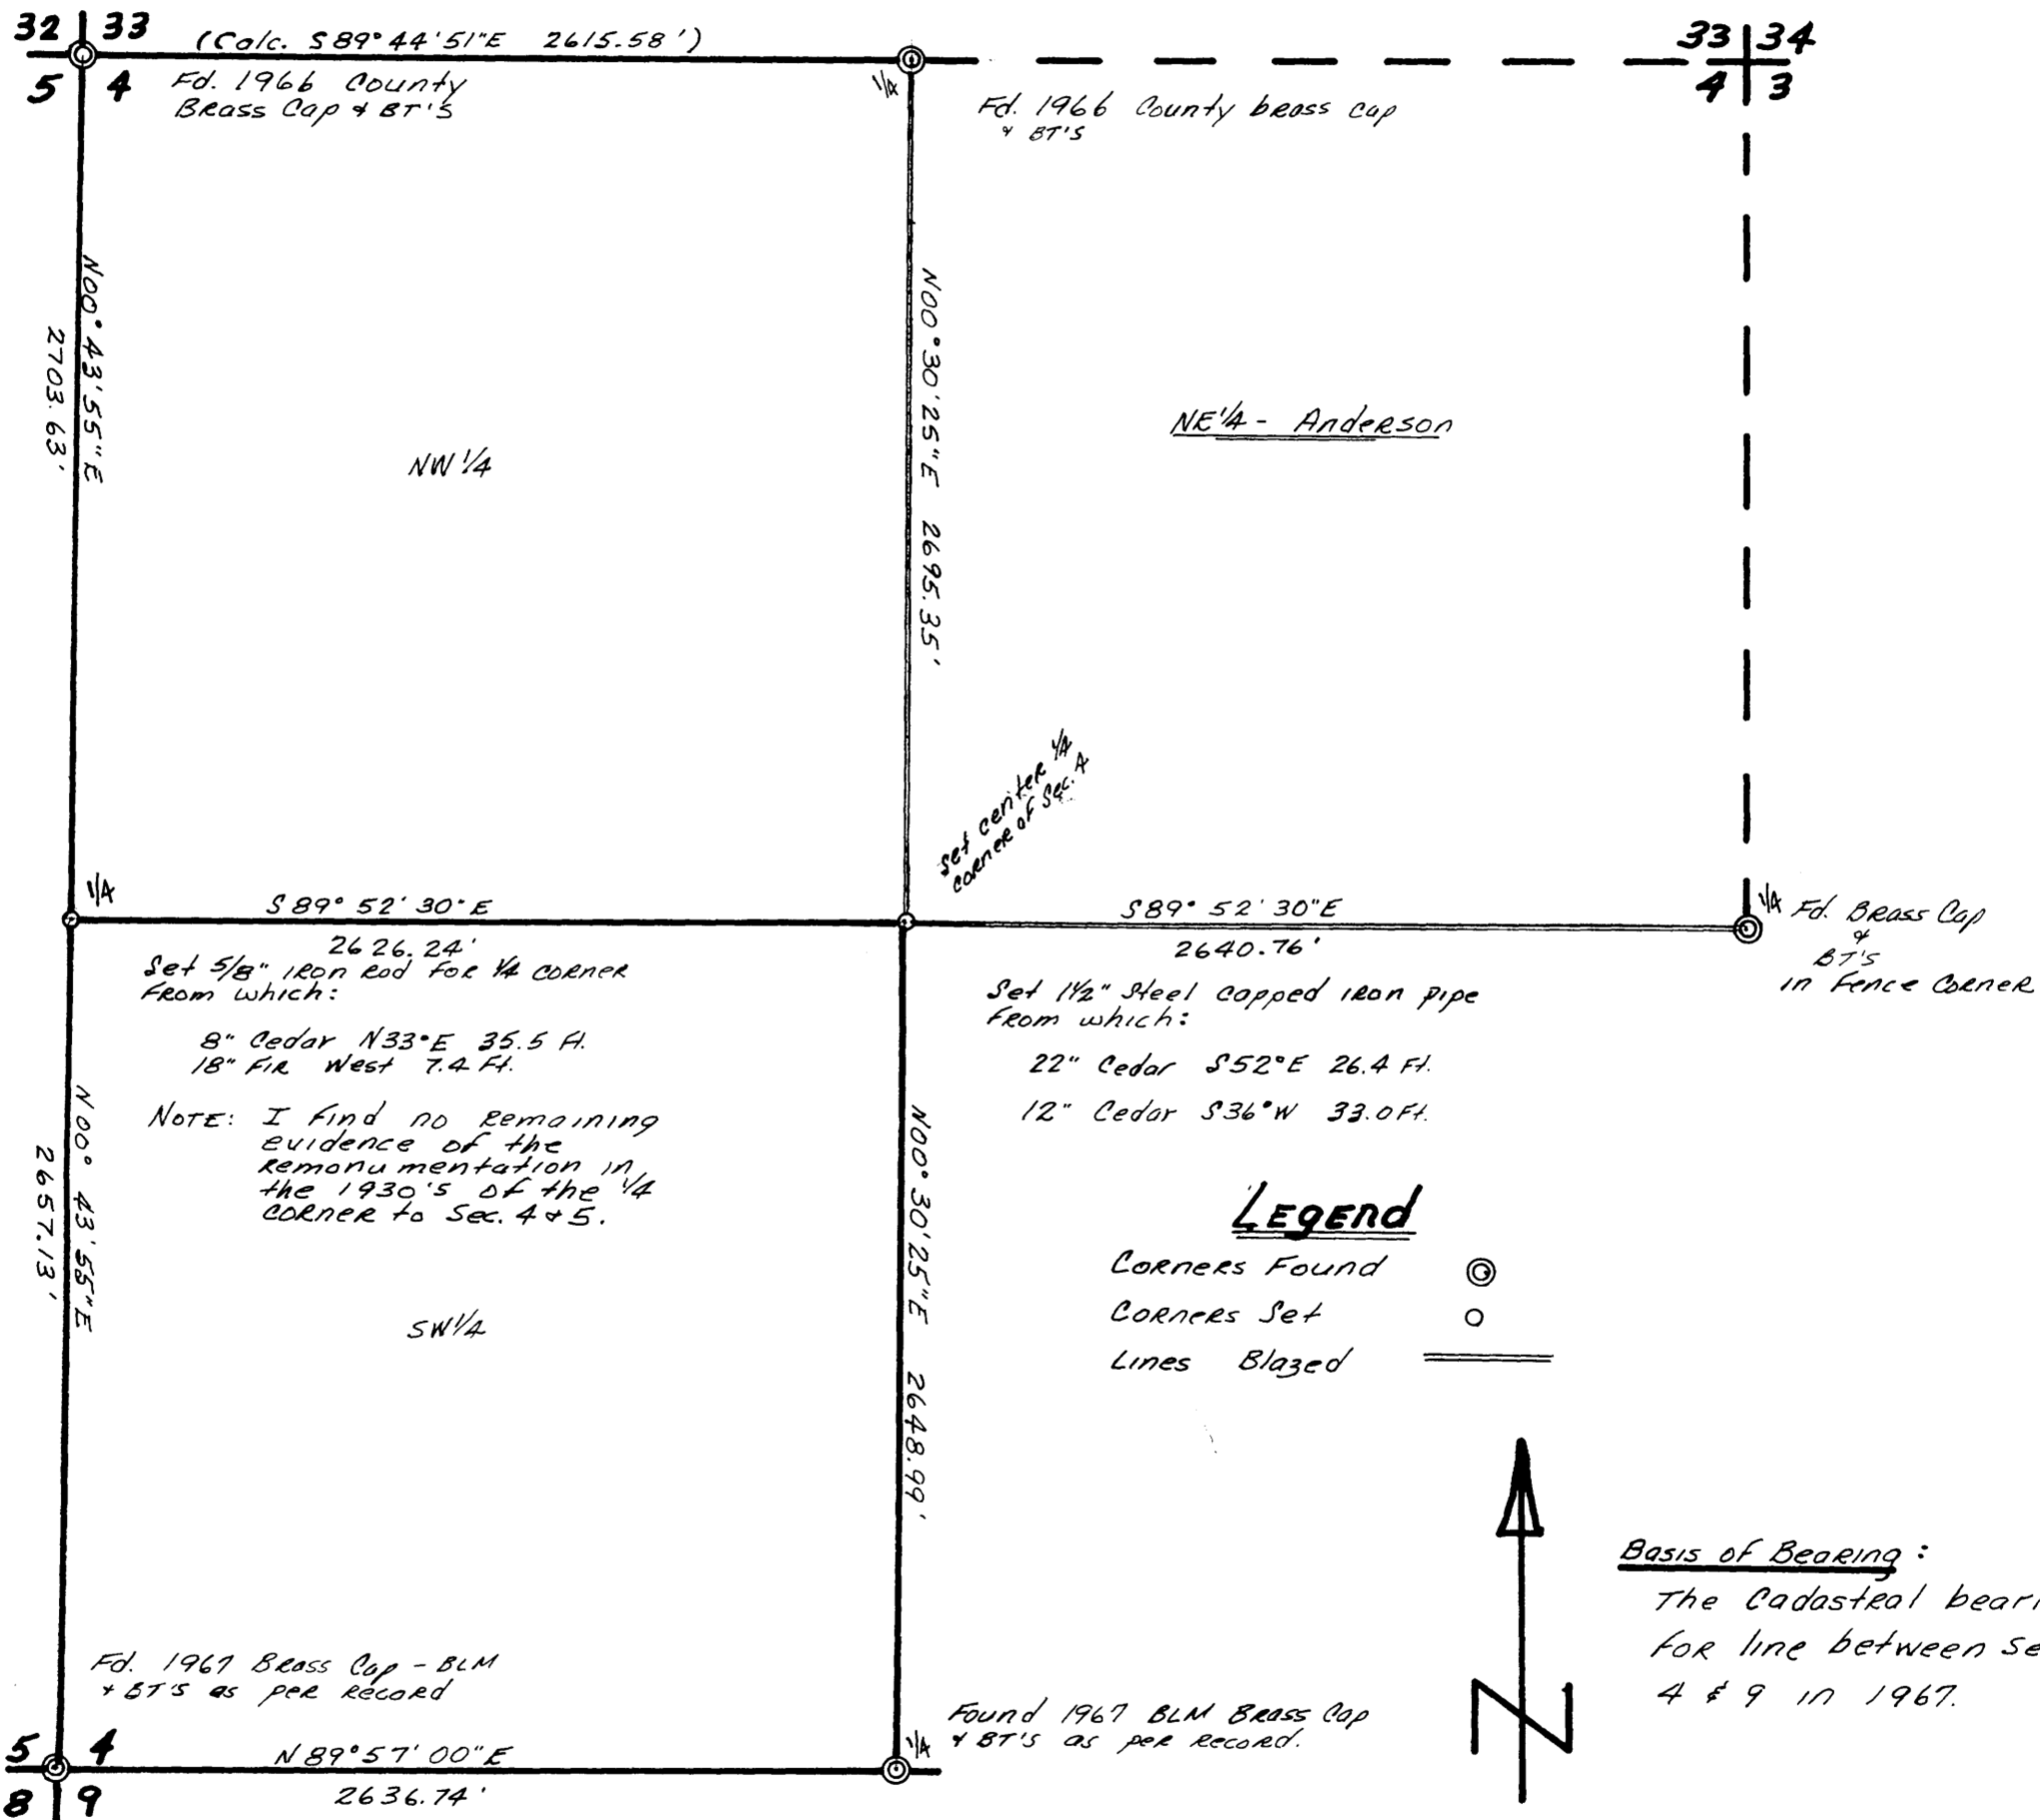

Survey For:
Reservation Ranch
P.O. Box 1094
Coos Bay, Oregon

Survey By:
R.E. Stuntzner
1260 Golden
Coos Bay, Oregon

