



MAP FILE M52-61

SURVEY OF PARCEL IN BLOCK 1, CLOVERDALE ADDITION  
TO ROSEBURG IN SECTION 18, T.27 S., R.5 W., W.M., DOUGLAS CO., ORE.  
FOR BREITIGAM CONSTRUCTION, P.O. BOX 726 CANYONVILLE, ORE.

BY HERBERT L. NORTHCRAFT

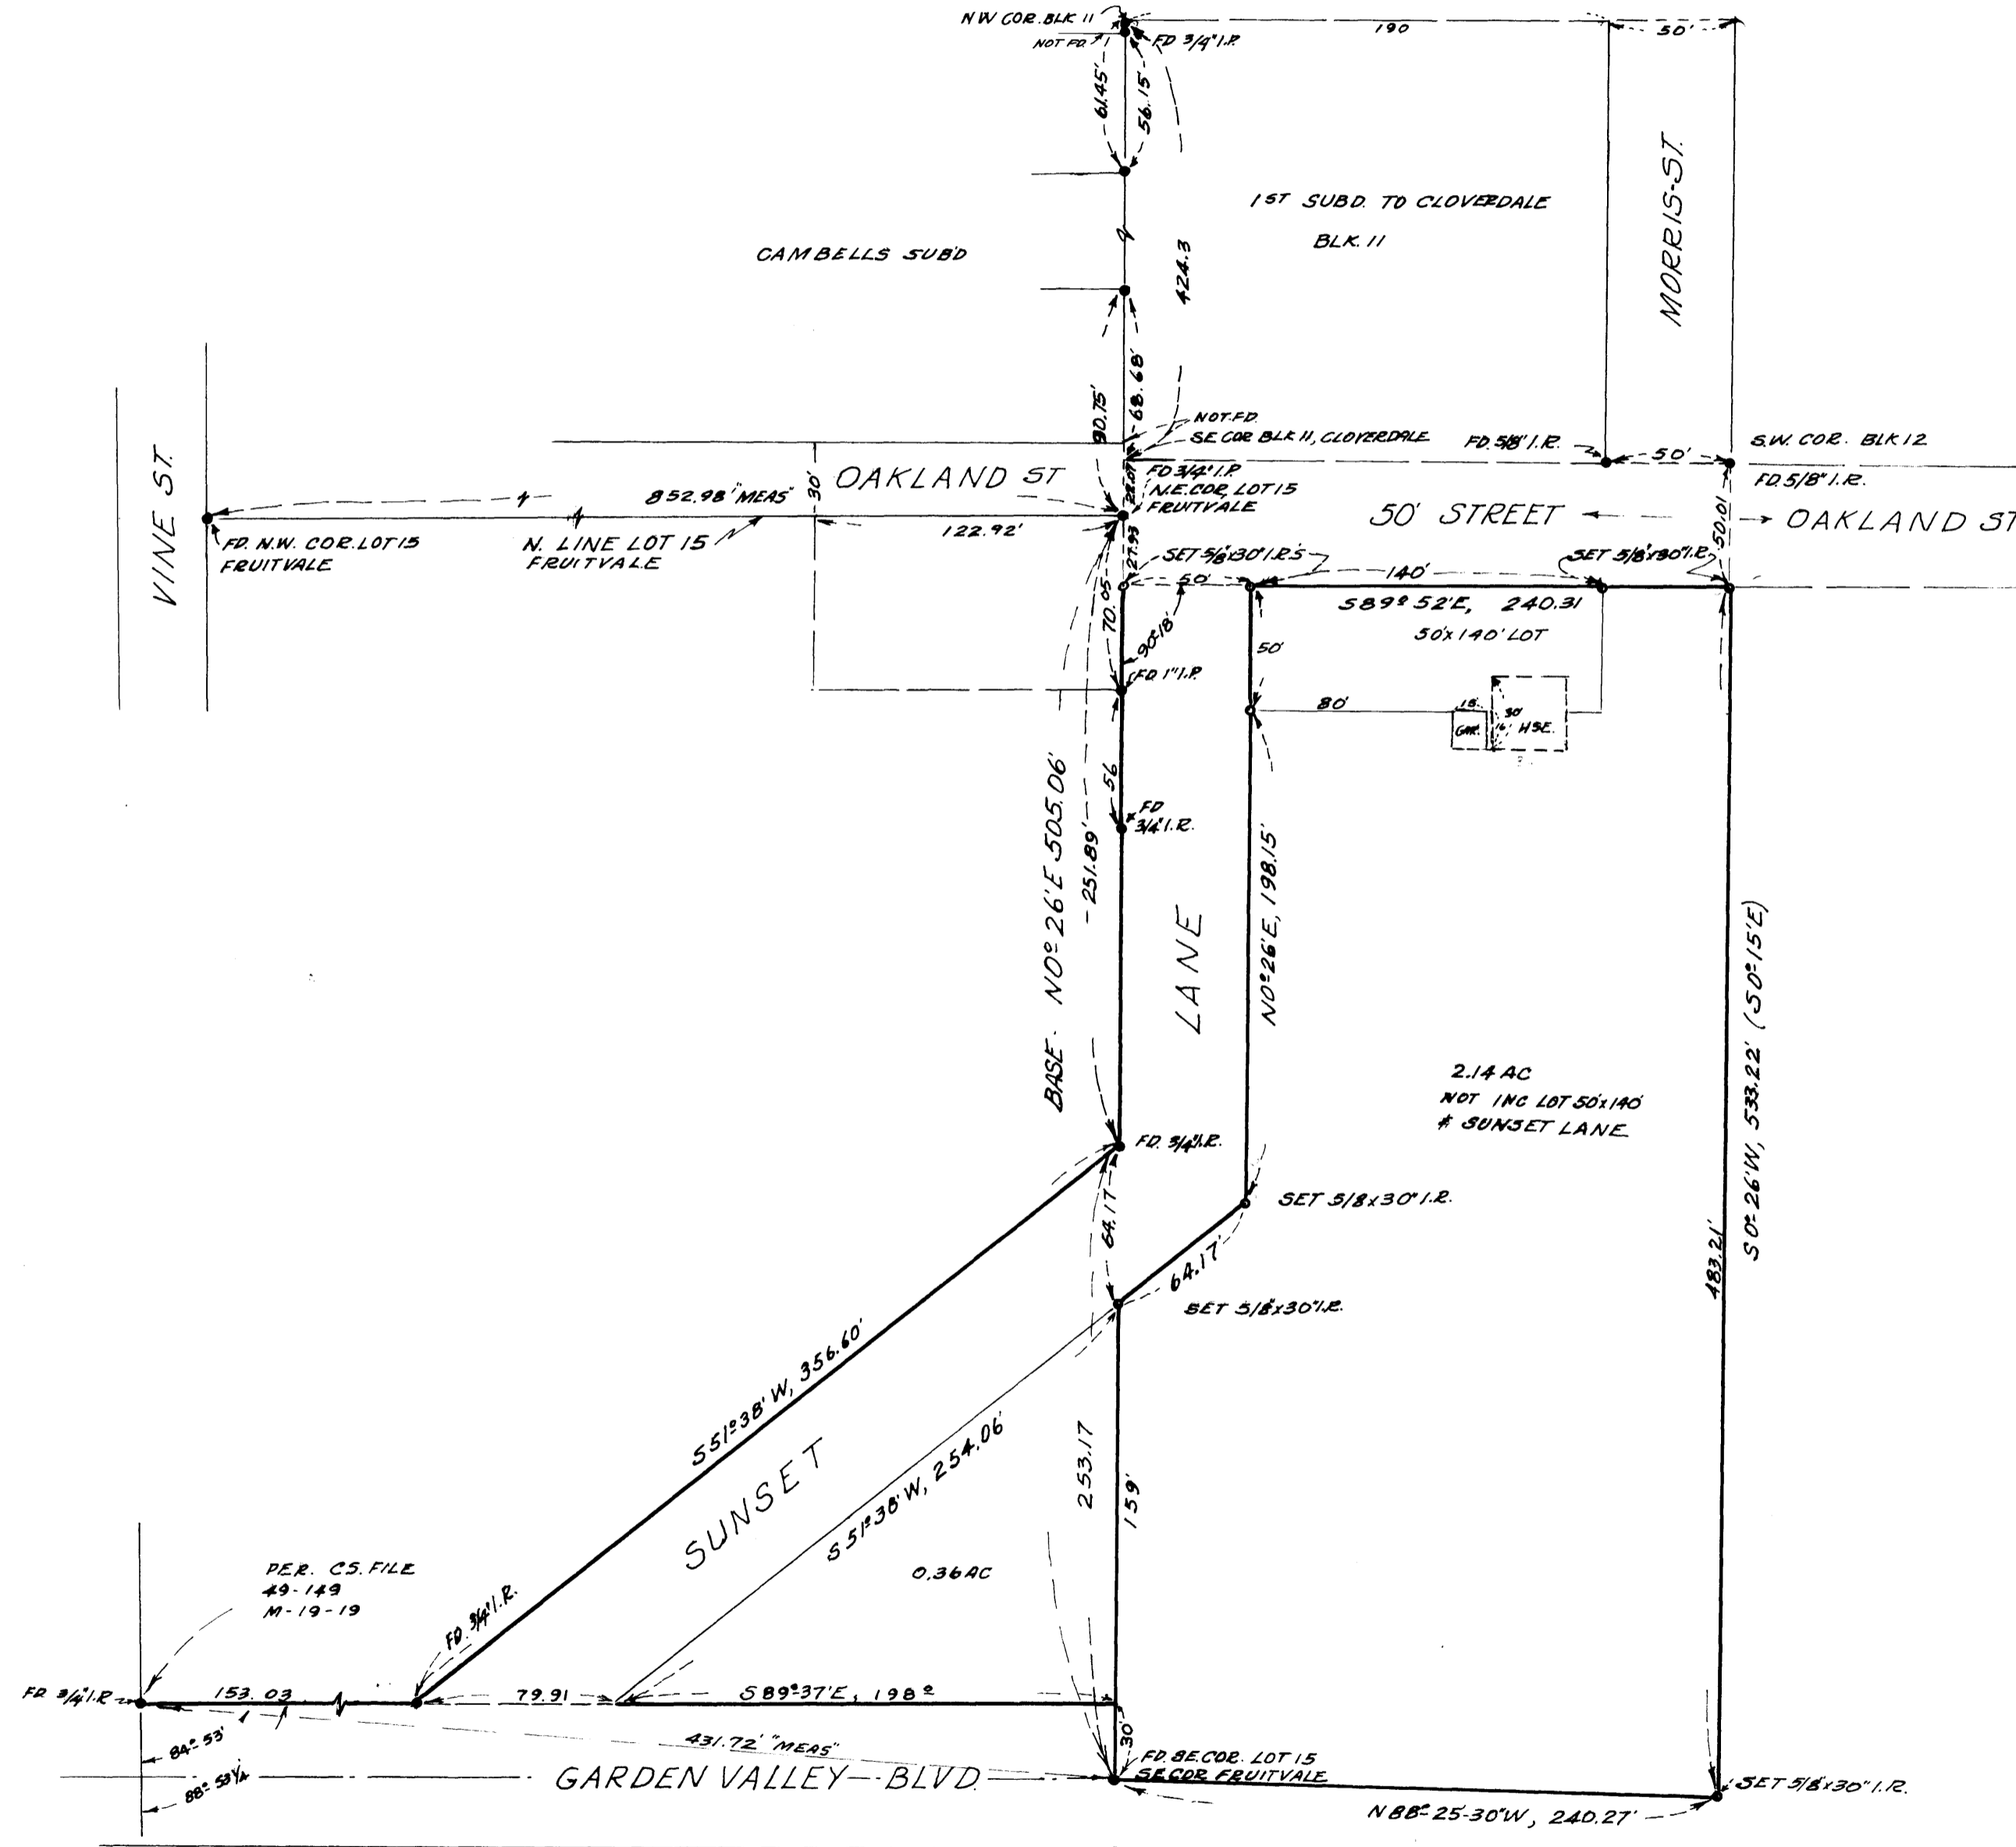

SCALE 1" = 60'  
JAN + FEB, 1974

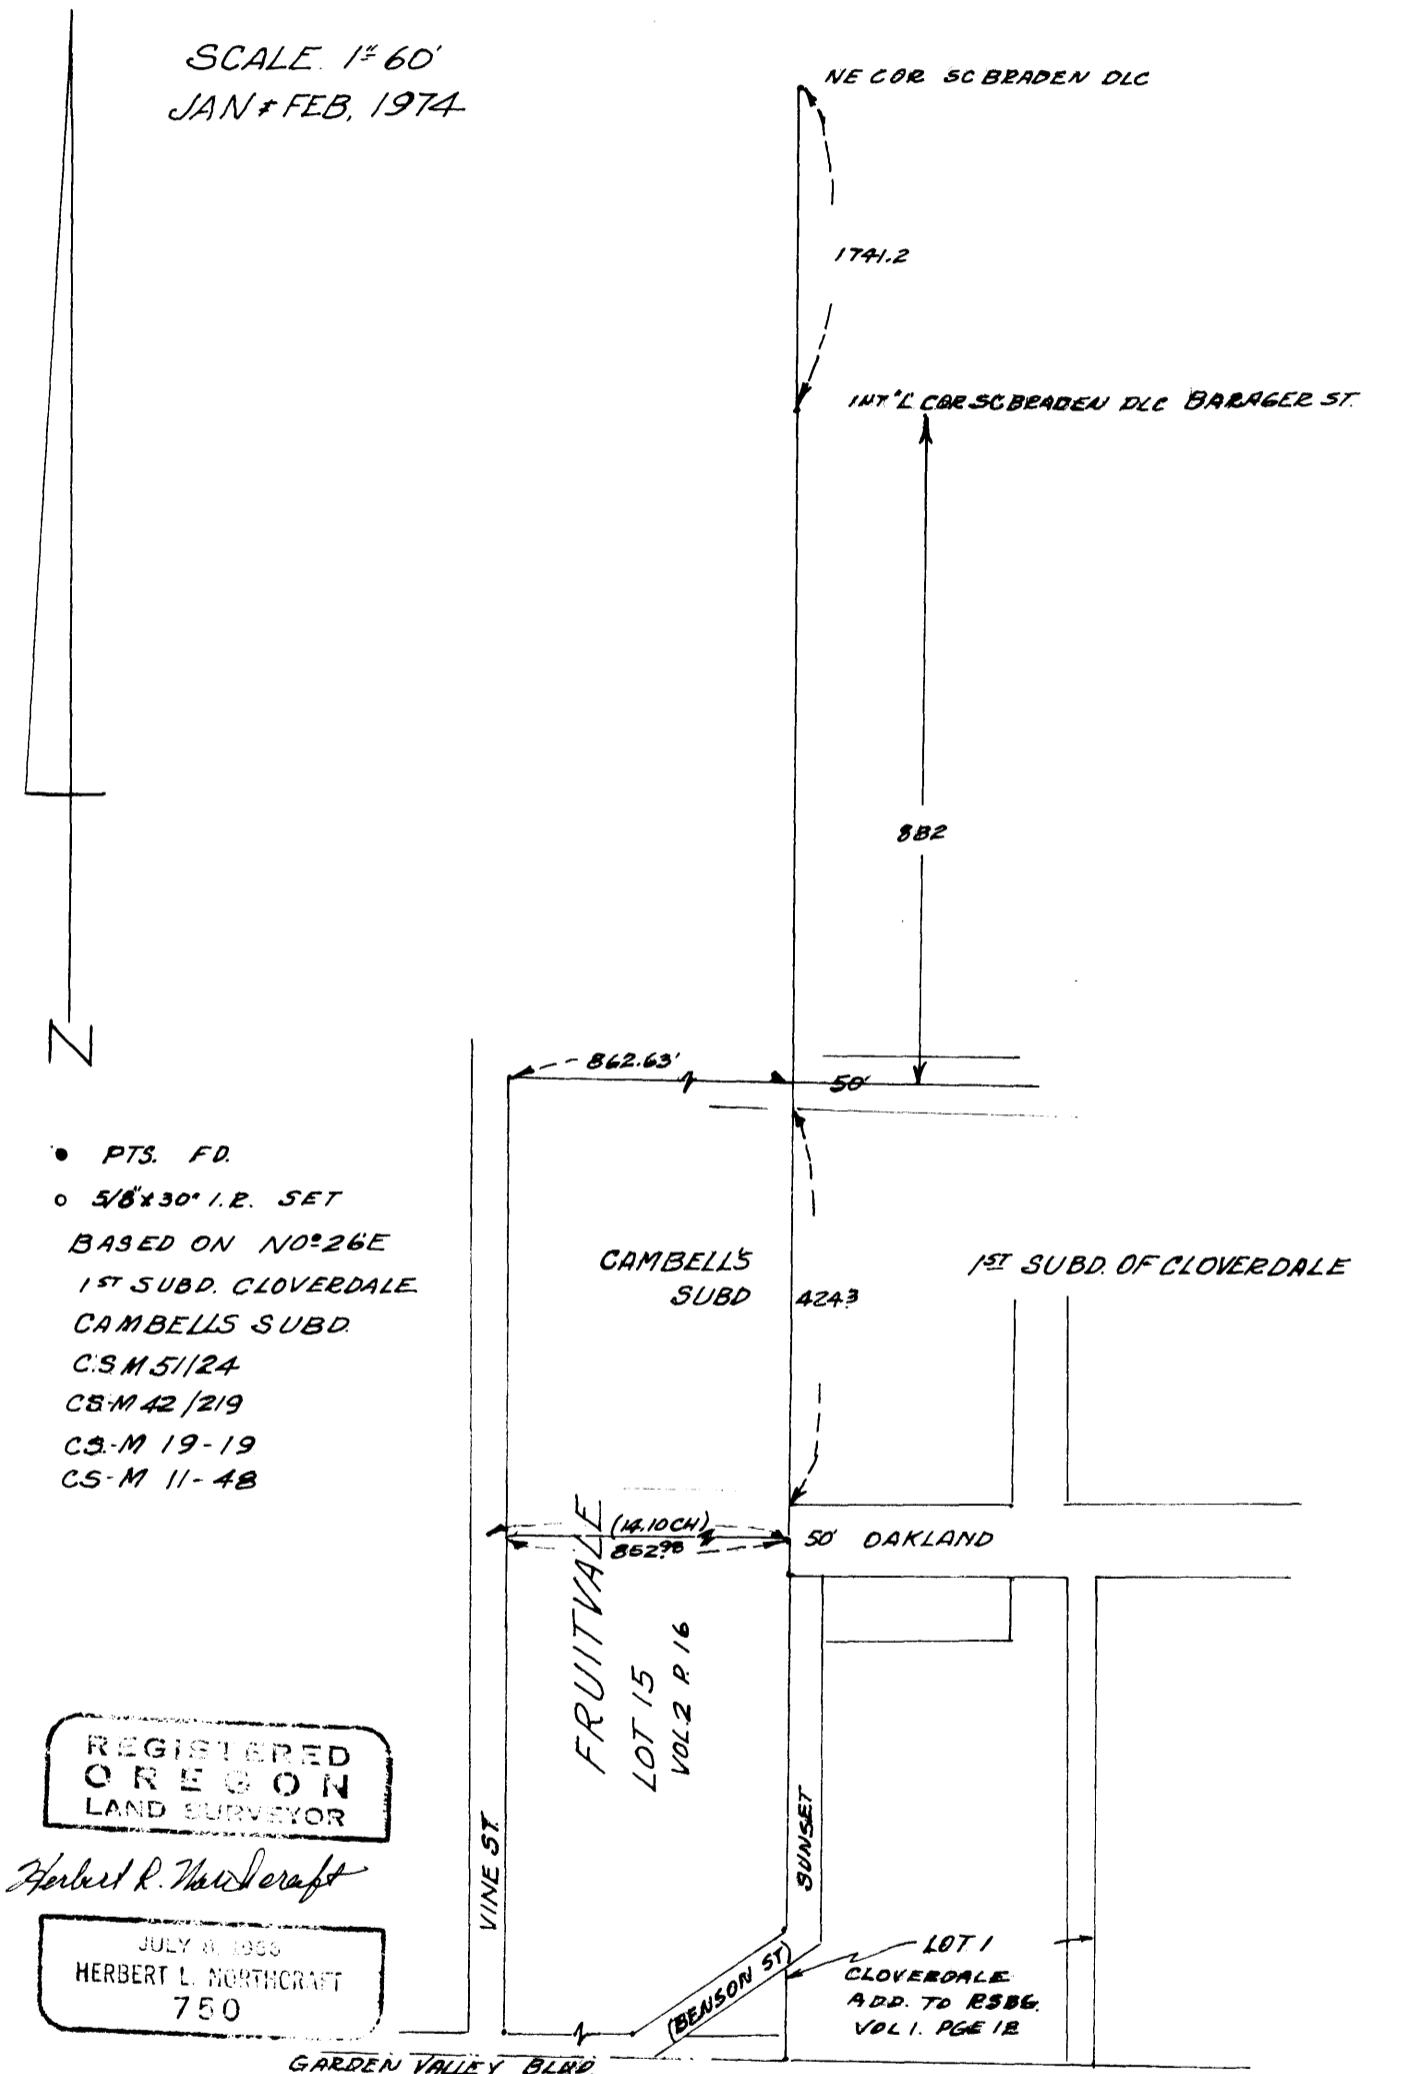

- PTS. FD.
  - 5/8" x 30" I.R. SET
- BASED ON NO. 26E  
1ST SUBD. CLOVERDALE  
CAMBELLS SUBD  
C.S.M 5/124  
C.S.M 42/219  
C.S.M 19-19  
C.S.M 11-48

REGISTERED  
OREGON  
LAND SURVEYOR

Herbert L. Northcraft

JULY 8 1963  
HERBERT L. NORTHCRAFT  
750

THE E. LINE OF FRUITVALE & WEST LINES OF  
FIRST SUBD. OF CLOVERDALE ARE THE SAME LINES  
AS EVIDENCED BY MAPS ON FILE & POINTS FD.  
LOT 15 FRUITVALE IS BOUNDED BY THIS LINE  
AND VINE ST. WHICH VERIFY DISTANCES & ACCOUNT  
FOR DISTANCE OF 852.98' ON CS FILE 42/219  
AND THIS MAP.

MAP FILE M52-61