

SURVEY TO SET PROPERTY CORNERS LOT 2, BLOCK 1, PLEASANT VIEW SECTION 23, T.27S.R.6W.W.M.

FOR: MARY ANN PARSON


BY: BAUGHMAN SURVEYING SERVICE

JULY 1974.

SCALE: 1" = 40'

COUNTY SURVEYORS FILE DATA
DO NOT REMOVE FROM OFFICE

FILE # 7
SS
COUNTY SURVEYORS
OFFICE
M&S

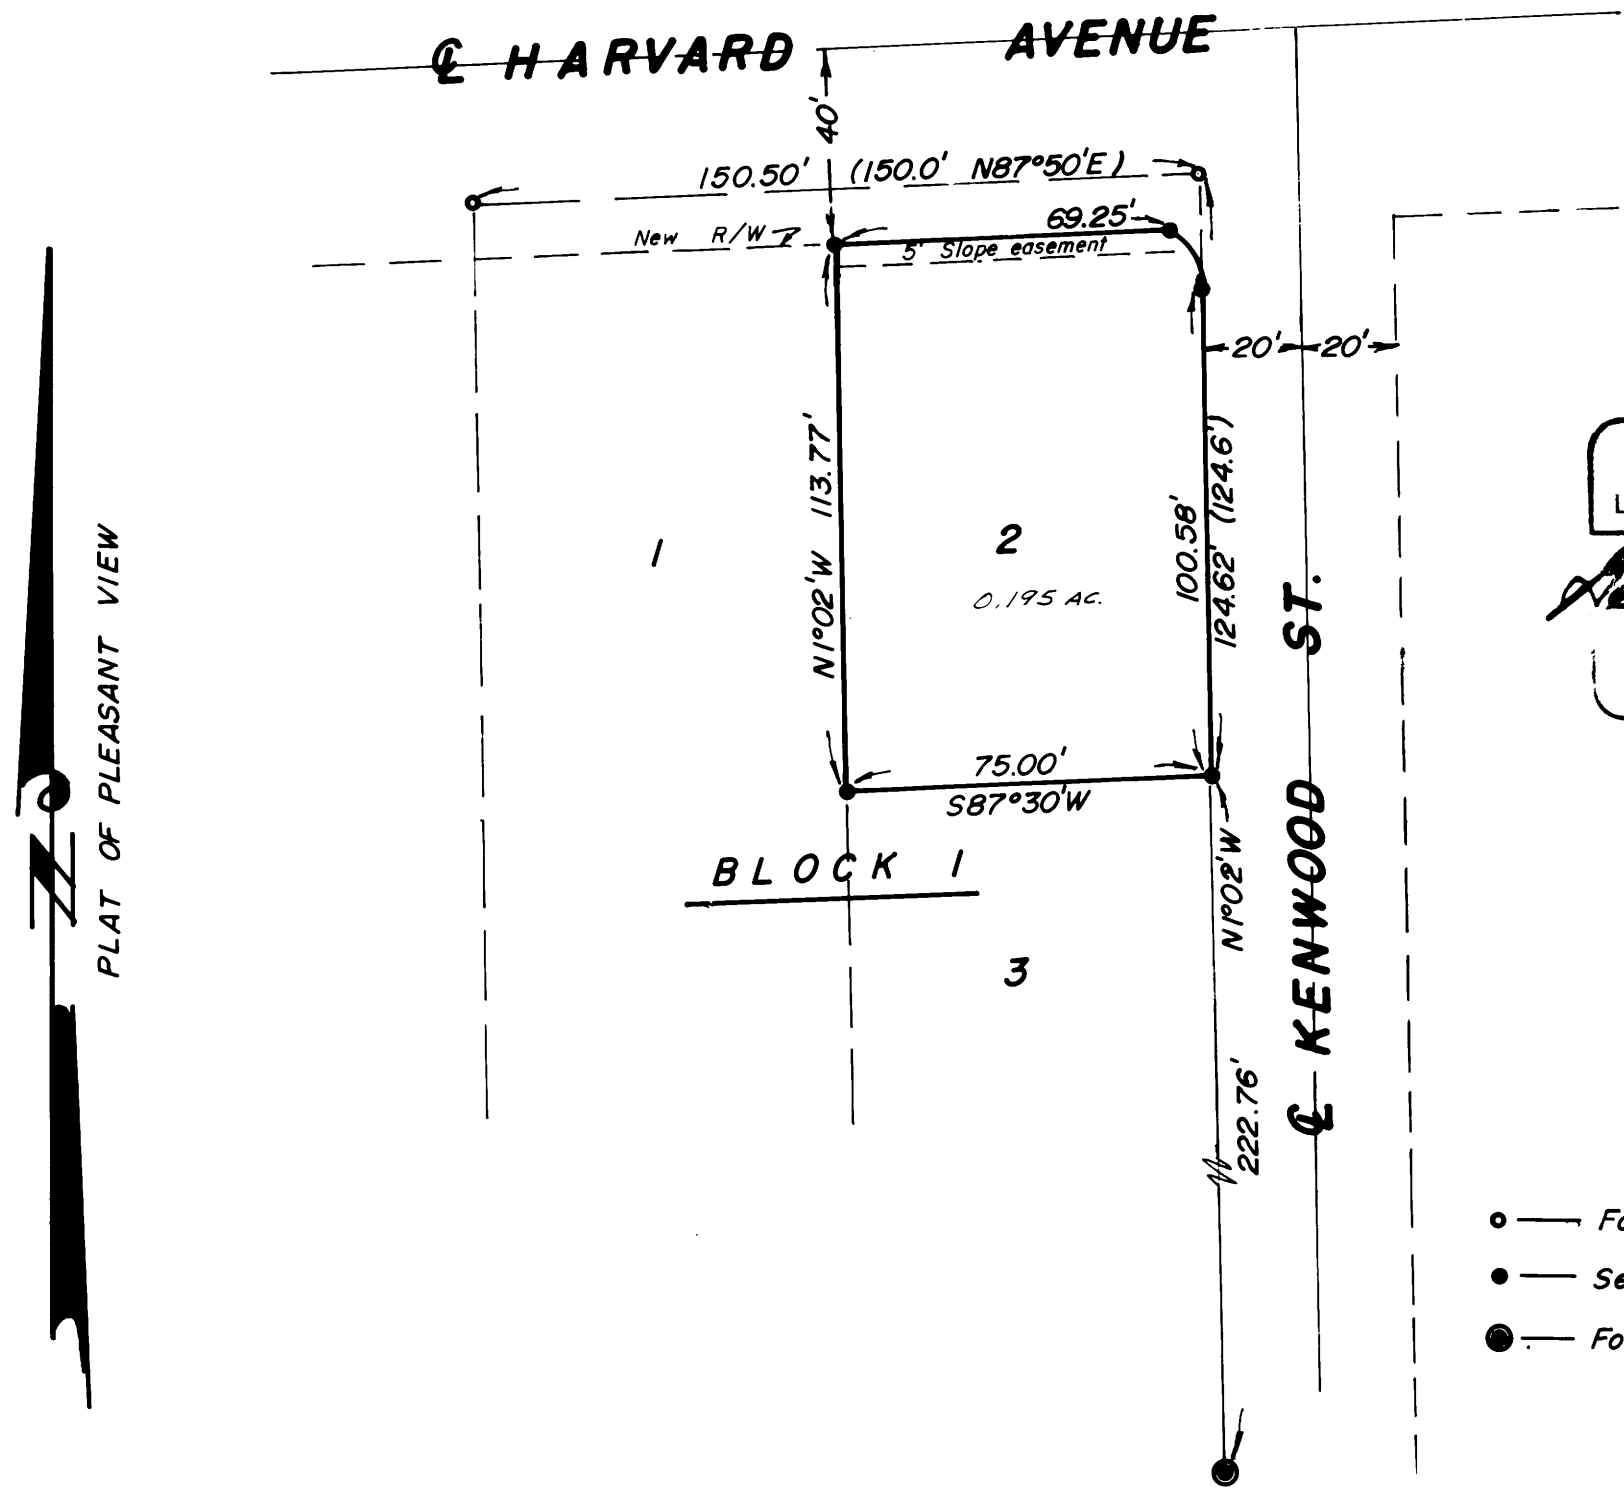

REGISTERED
PROFESSIONAL
LAND SURVEYOR

Alvin S. Baughman

CLARENCE S. BAUGHMAN
1935

LEGEND

- — Found Ref's. for corner, DC.R.C.
- — Set 5/8" iron rod
- — Found 1" iron rod