

FILED ✓
RECEIVED SS

JUL 31 1974

COUNTY SURVEYOR
DOUGLAS COUNTY, ORE.
ml


M 53-79

SURVEY TO LOCATE NORTH PROPERTY LINE FOR DWAINE BOLING IN SE 1/4, NE 1/4 OF SEC. 32, T. 27 S., R. 7 W., W.M., DOUGLAS COUNTY, OREGON

FOR DWAIN BOLING, LOOKINGGLASS, ORE.
BY HERBERT L. NORTHCRAFT

SCALE 1" = 200'

MAY & JUNE, 1974

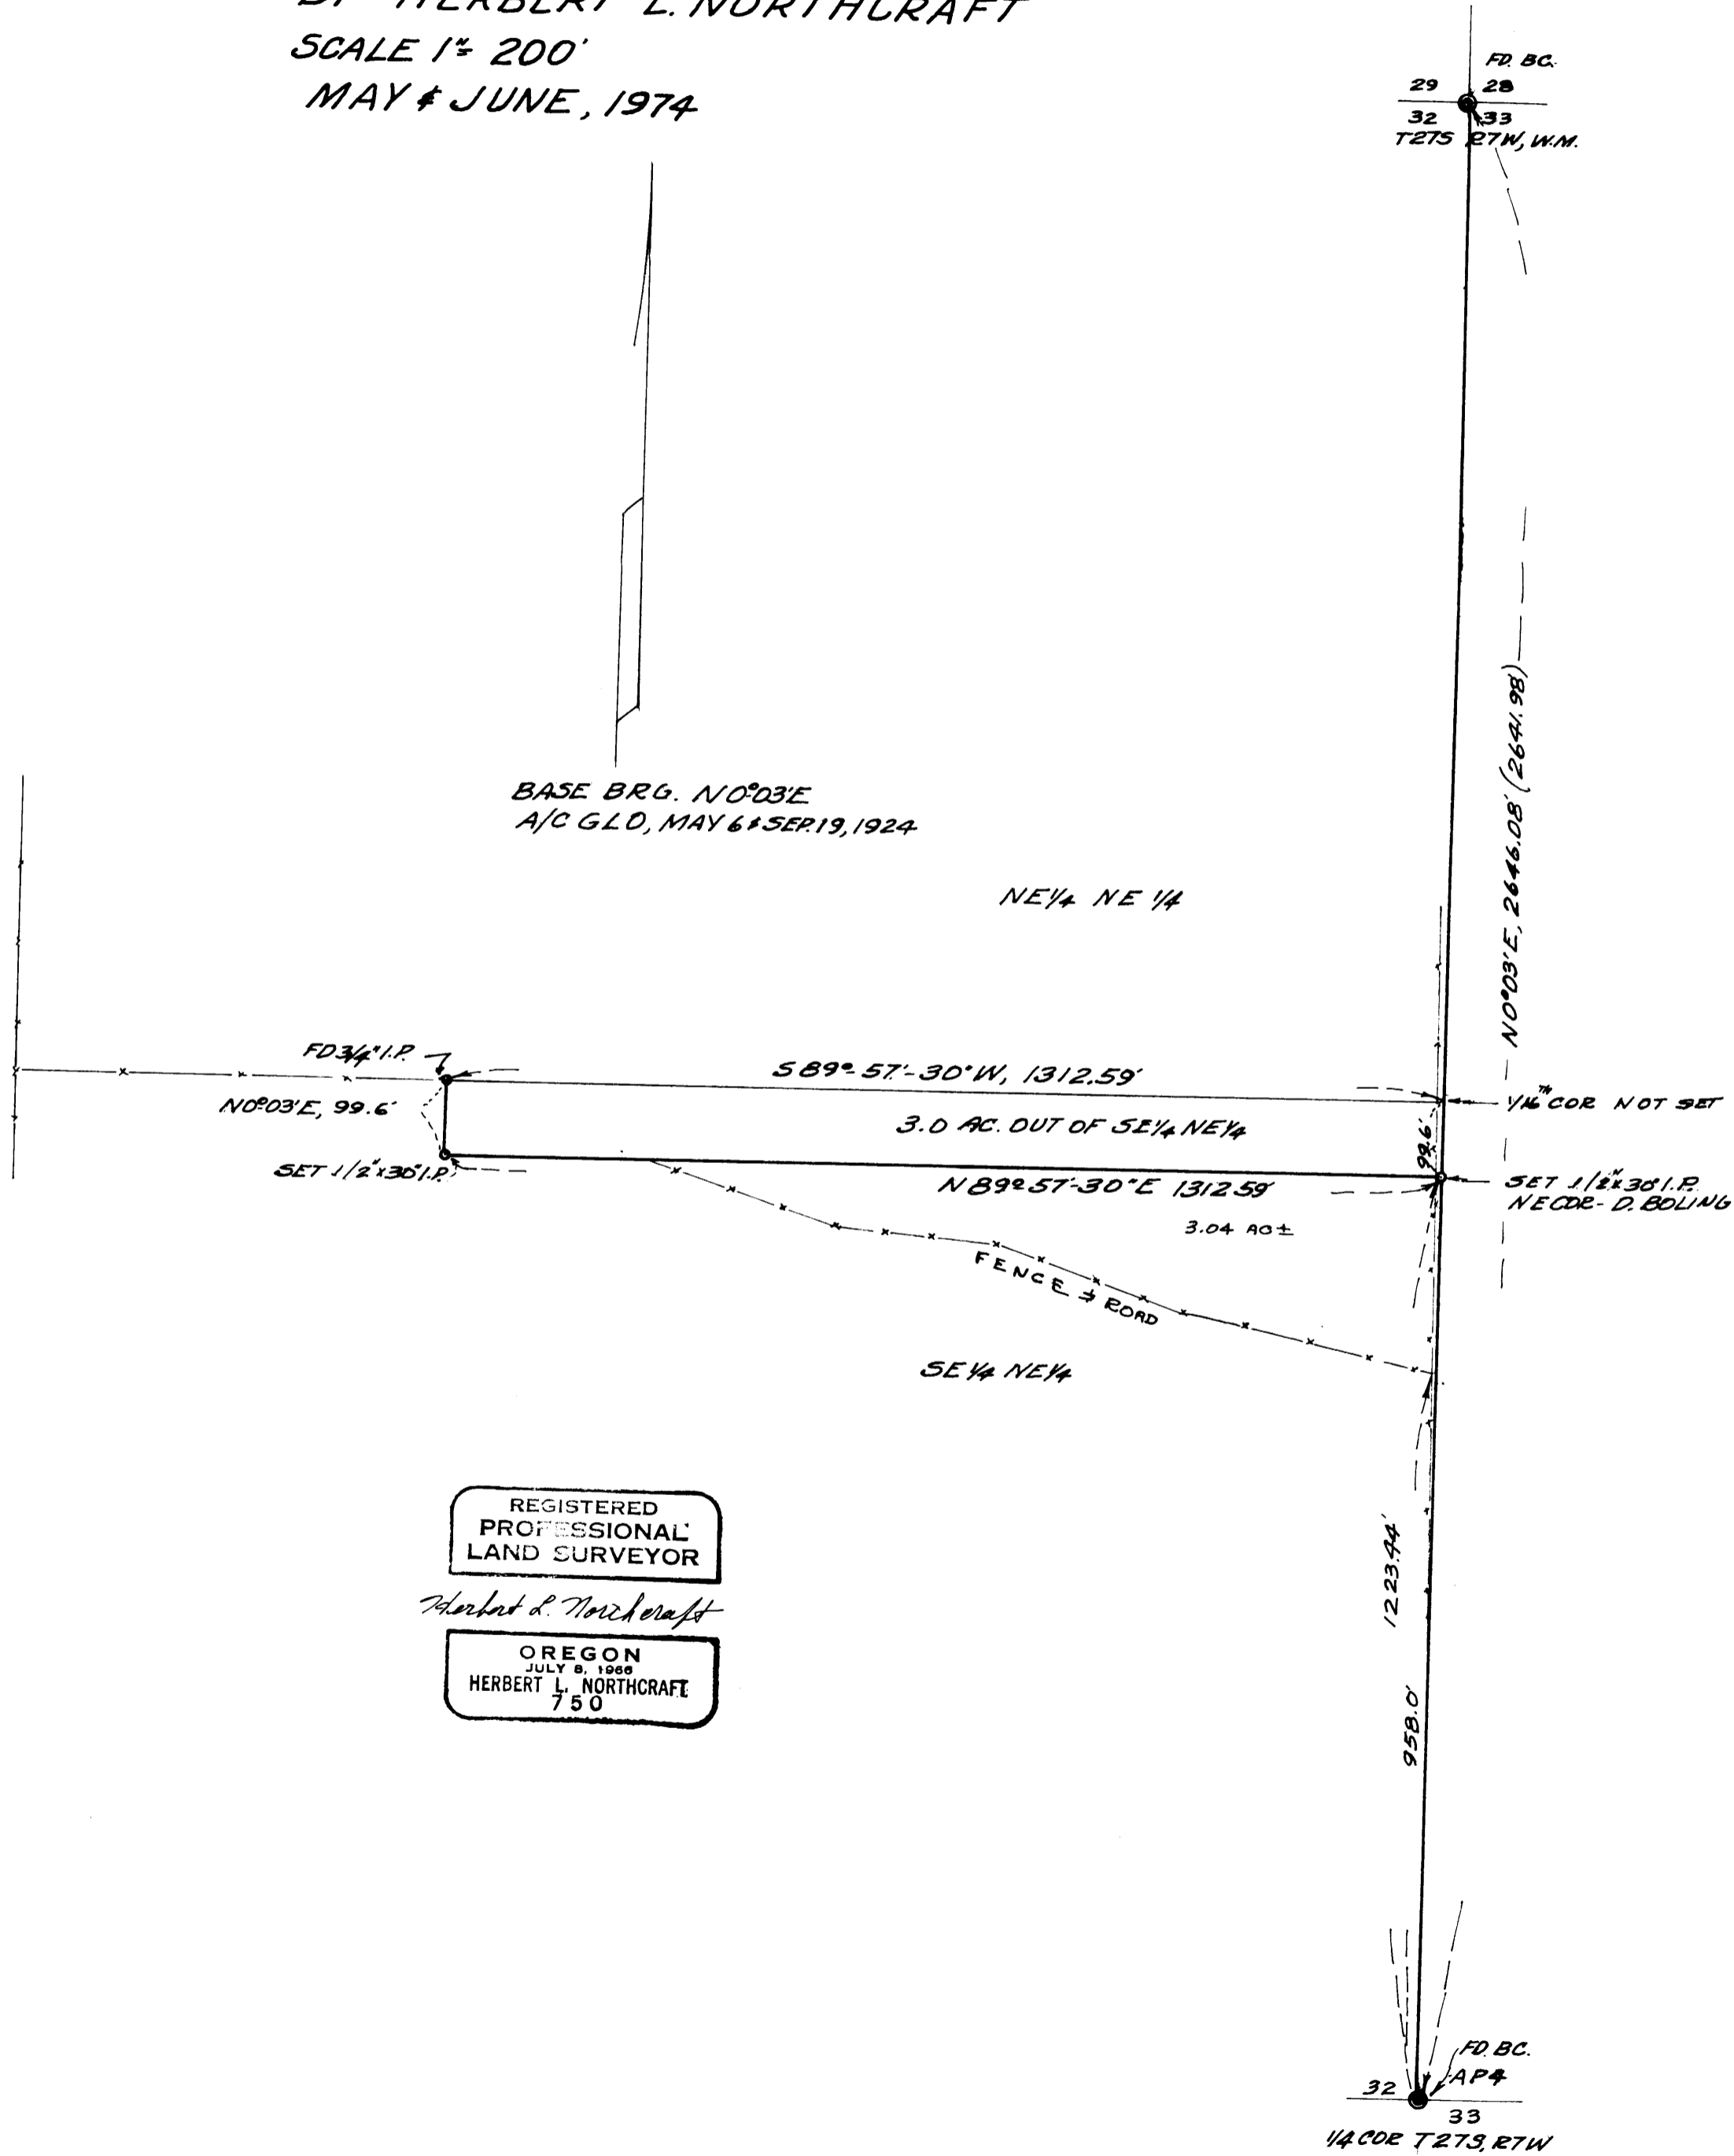

REGISTERED
PROFESSIONAL
LAND SURVEYOR

Herbert L. Northcraft

OREGON
JULY 9, 1966
HERBERT L. NORTHCRAFT
750

M 53-79