

FILED
RECEIVED

AUG 12 1974

FIELD SURVEY & PLAT FOR
DELMAR B. DEARDORFF
MYRTLE CREEK, ORE.

(PROPERTY TO BE DEEDED TO DEAM.)

**COUNTY SURVEYORS FILE DATA
DO NOT REMOVE FROM OFFICE**


COUNTY SURVEYOR NE 1/4 SEC. 25 T29 S0. R5W W. M.
DOUGLAS COUNTY, ORE. DOUGLAS COUNTY, OREGON

SCALE: 1" = 100'

MARTIN ENGINEERING SERVICE - MYRTLE CREEK

BASE OF BEARING: DEED & FENCELINE = N5°-30'W

● SET 3/4" x 30" IRON PIPE

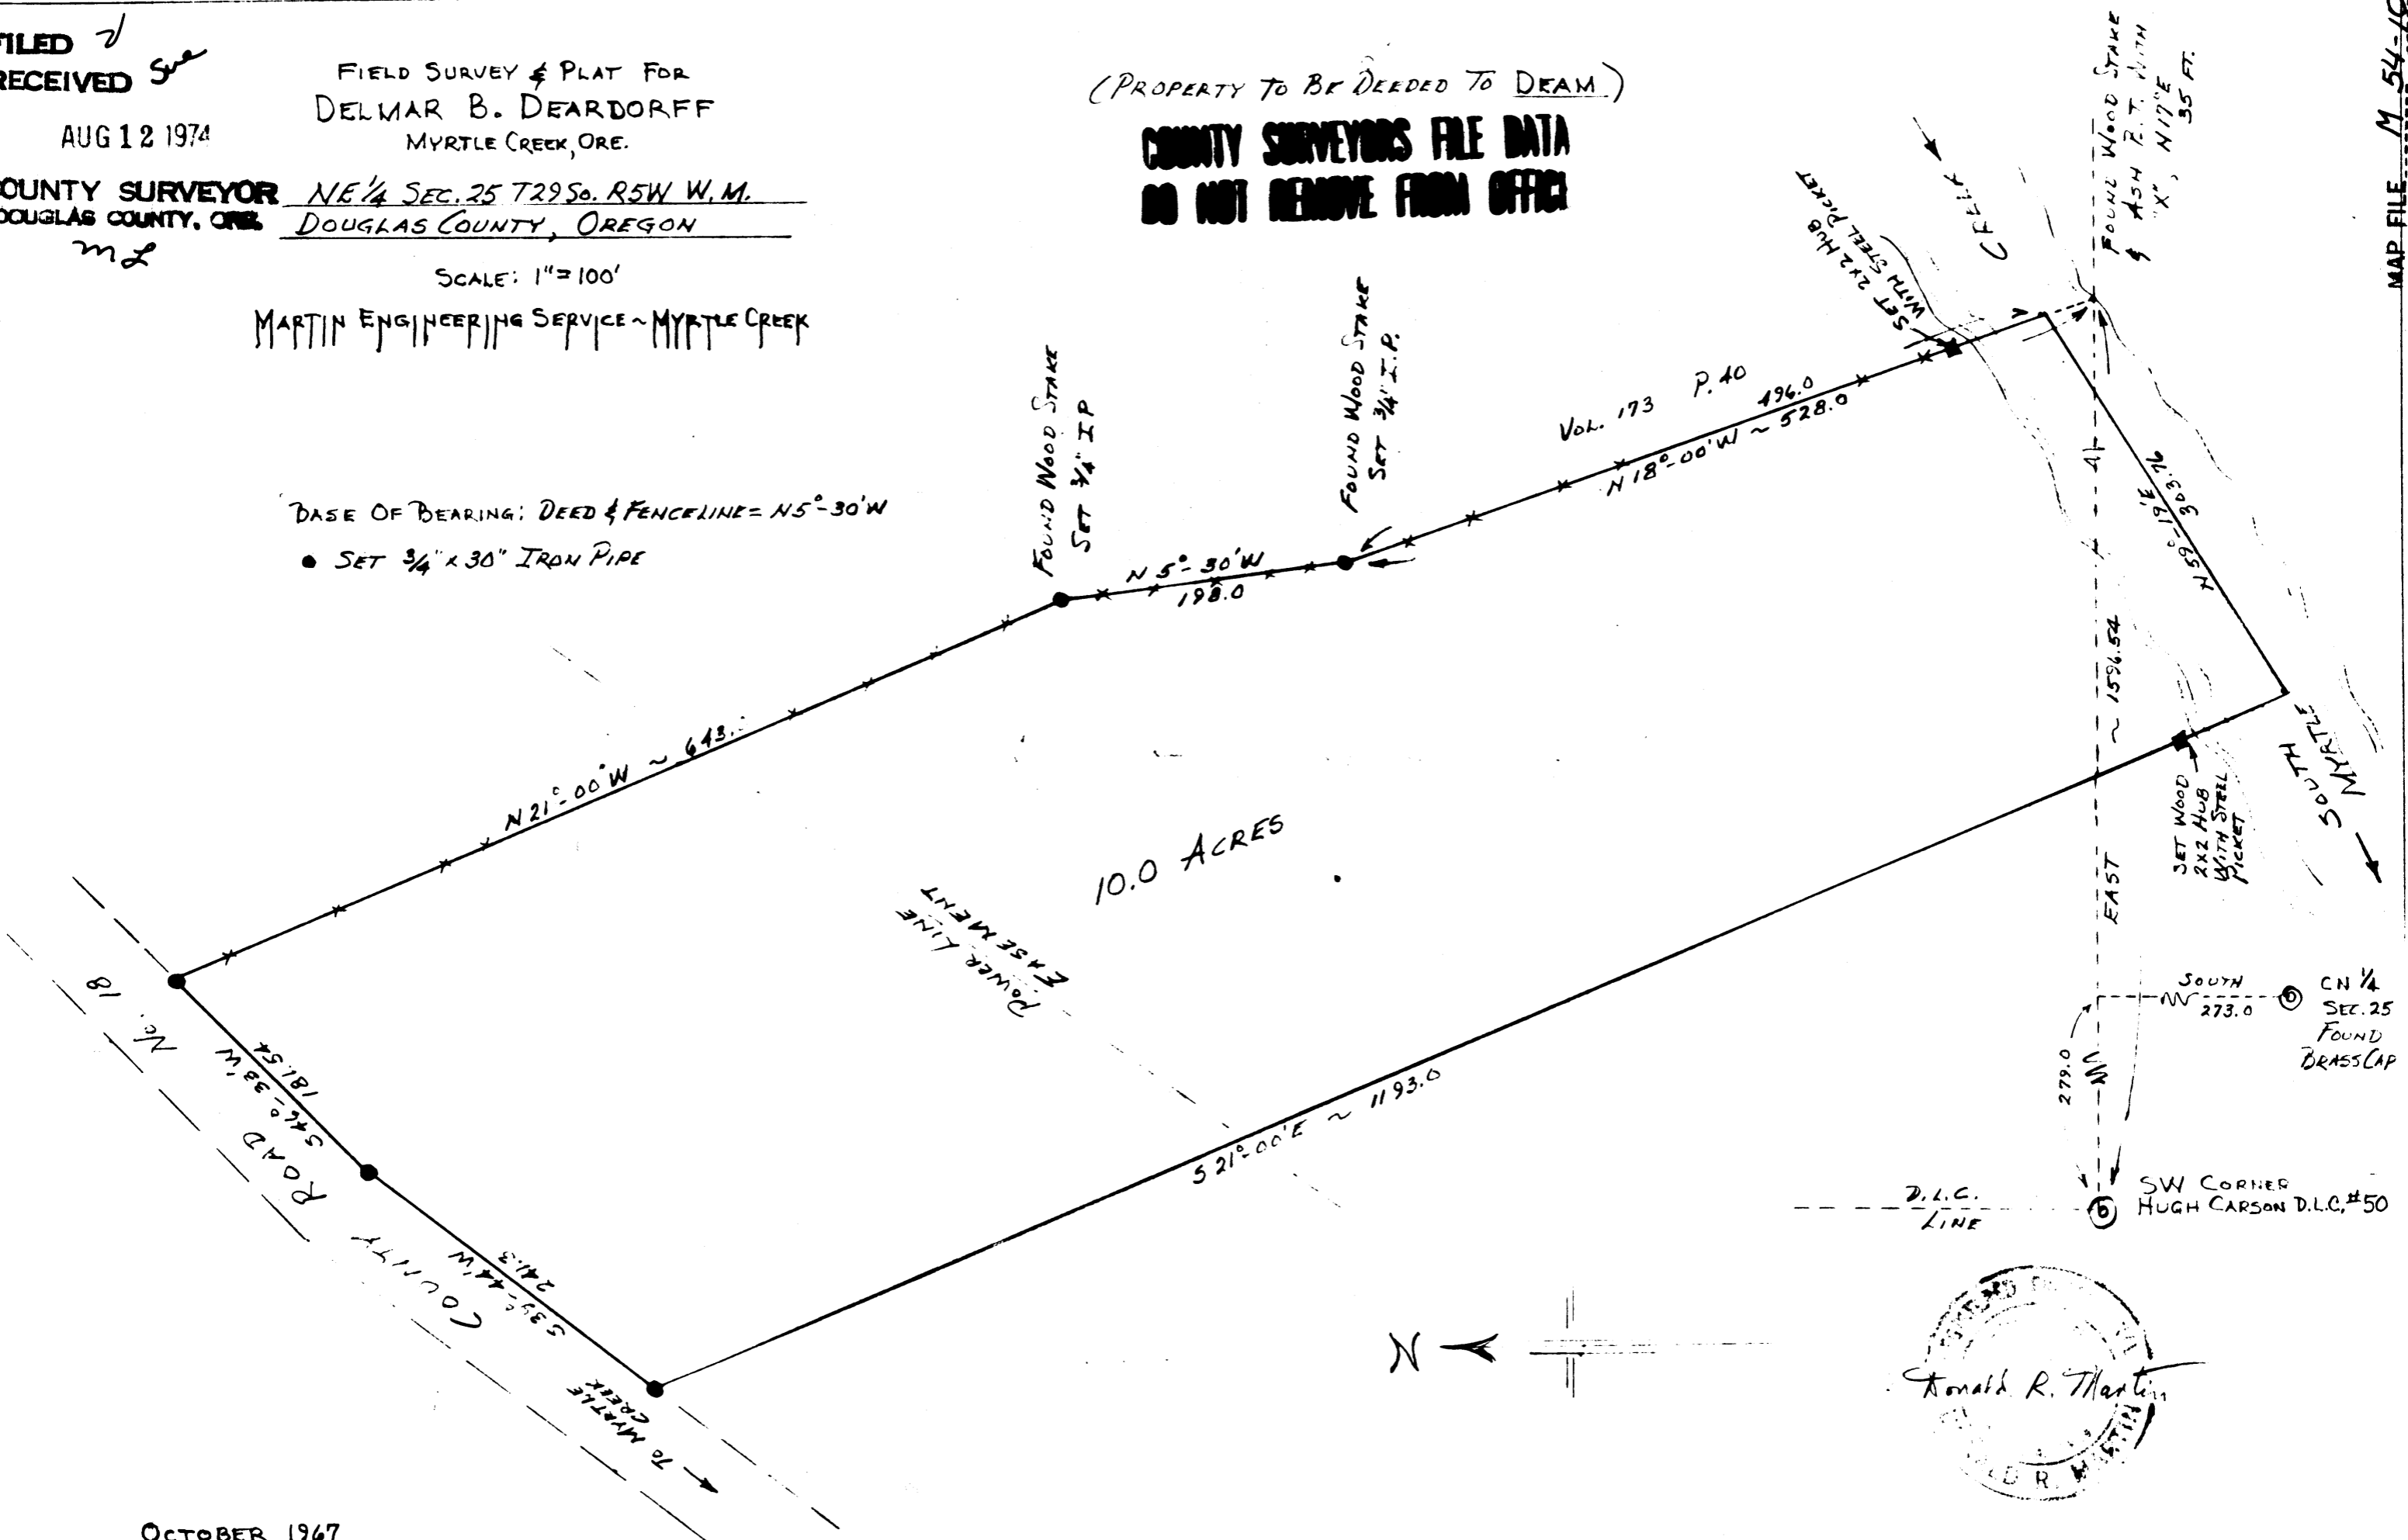

10.0 ACRES

POWER LINE
EASEMENT



OCTOBER 1967

MAP FILE M 54-10

MAP FILE M 54-10