

SURVEY TO SET PROPERTY CORNERS


LOT 35 BOGGS ORCHARD TRACTS T. 28 S., R. 6 W Sec 1

FOR: ALBERT SCHATTENKERK

BY: BAUGHMAN SURVEYING SERVICE

AUGUST 1974

COUNTY SURVEYORS FILE DATA
DO NOT REMOVE FROM OFFICE

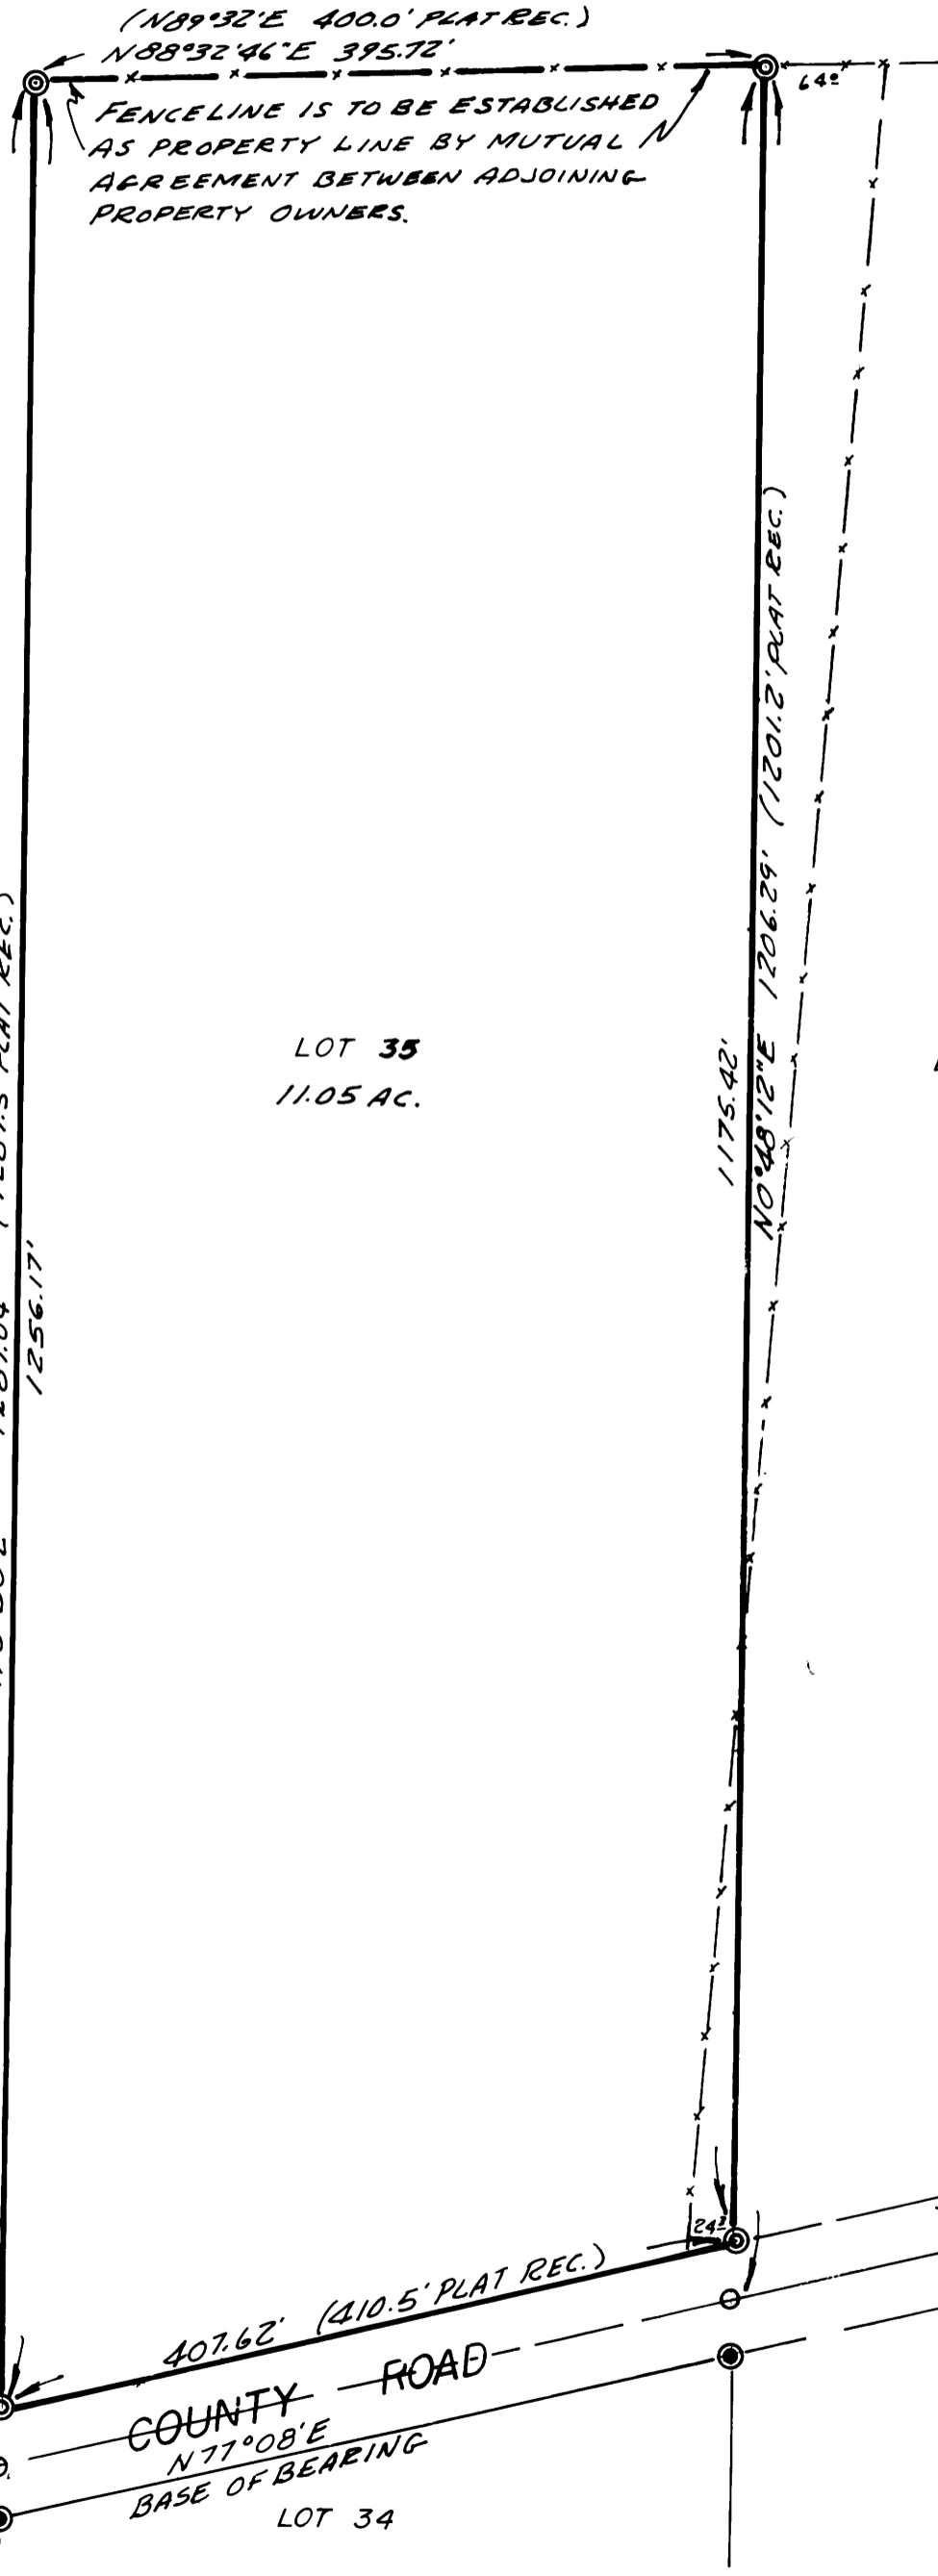


FENCELINE IS TO BE ESTABLISHED AS PROPERTY LINE BY MUTUAL AGREEMENT BETWEEN ADJOINING PROPERTY OWNERS.

LOT 33

LOT 35
11.05 AC.

LOT 37

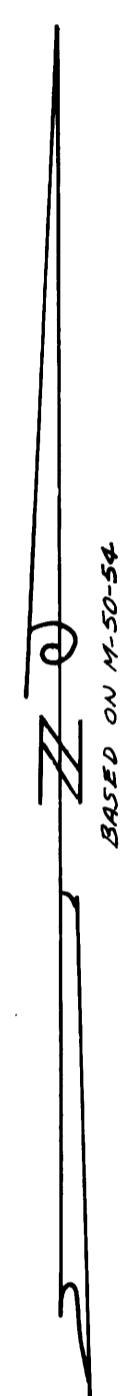

SCALE: 1"=100'

Glenn Baughman
 COUNTY SURVEYOR
 CLATSOP COUNTY, ORE.

LEGEND

- — Found 5/8" iron rod, per M-50-54
- ⊙ — Set 1/2 iron rod
- — Not set