


SURVEY FOR PROPERTY LINE IN SECTIONS 30 & 31, T.22S. R.7W.W.M. FOR: HENRY BECKLEY BY: BAUGHMAN SURVEYING SERVICE

AUGUST 1974 SCALE: 1"=200'

5/11/74
5/11/74

BAUGHMAN SURVEYING SERVICE
1000 N. 10TH ST.
ASTORIA, OREGON 97103

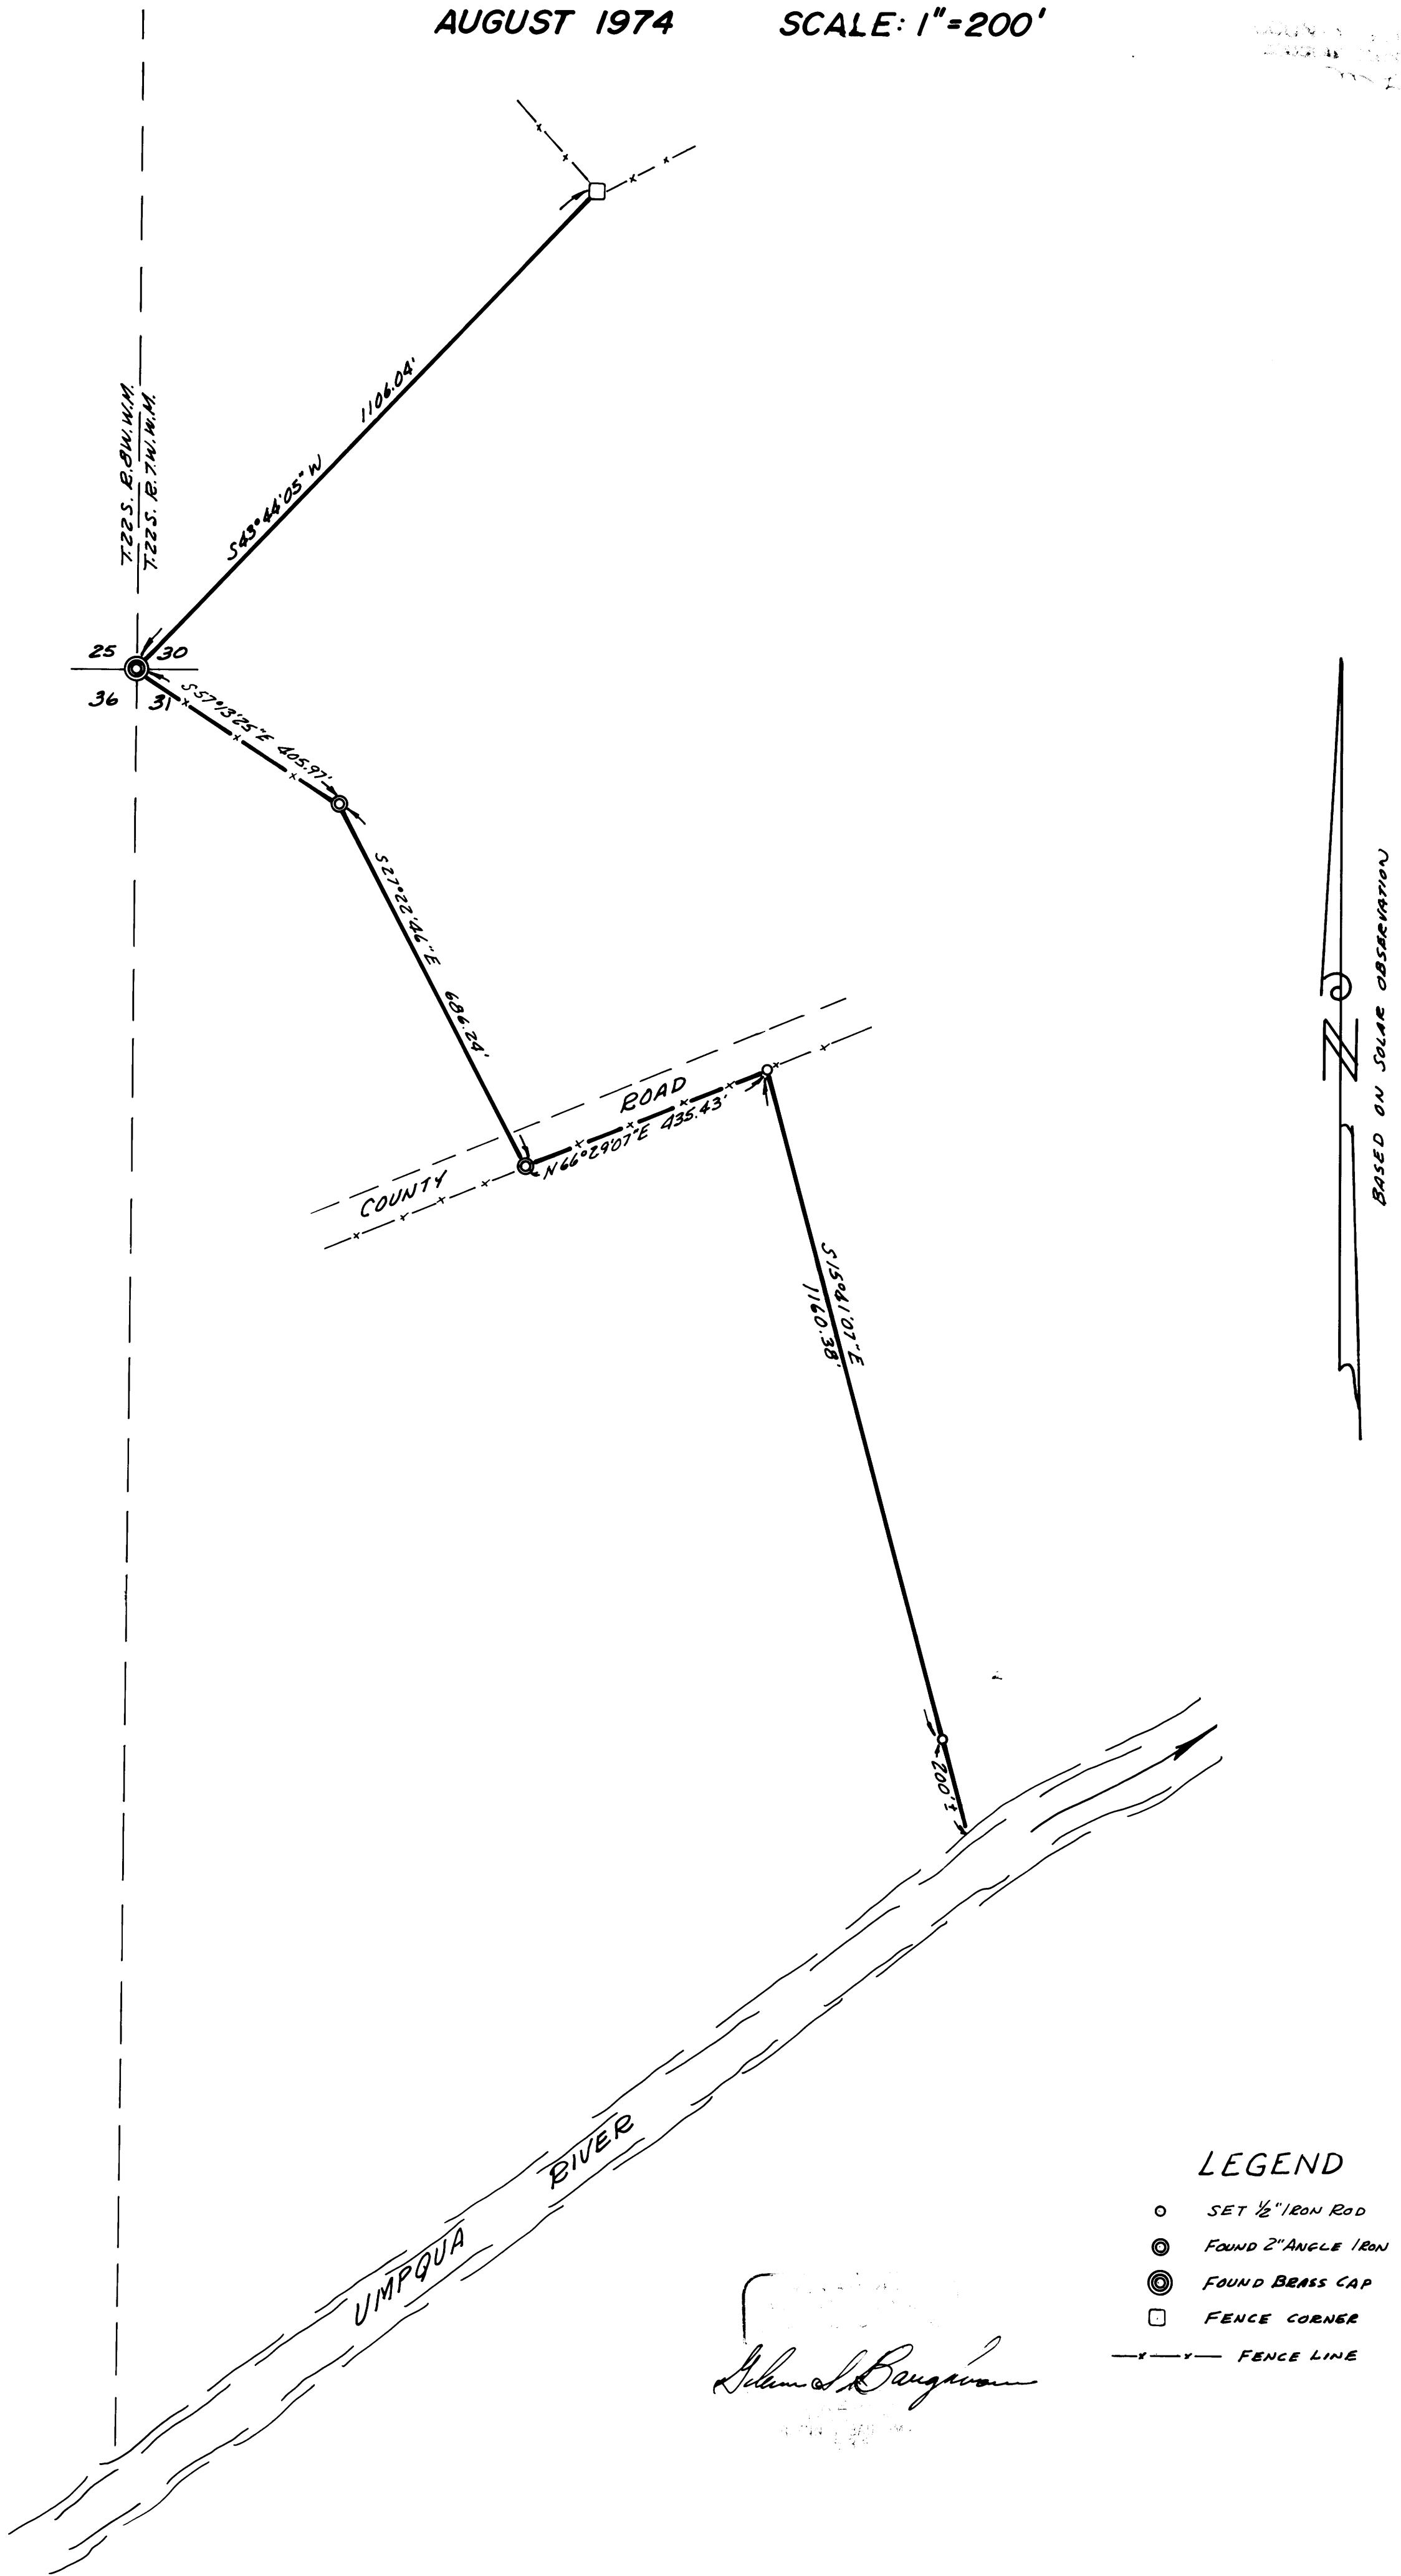

LEGEND

- SET 1/2" IRON ROD
- ⊙ FOUND 2" ANGLE IRON
- ⊕ FOUND BRASS CAP
- FENCE CORNER
- x-x- FENCE LINE

John S. Baughman