


COUNTY SURVEYORS FILE DATA
DO NOT REMOVE FROM OFFICE

SURVEY IN SEC. 18, T25S, R5 W. W. M.
SURVEYED FOR - MRS. R. W. FOSTER
ENGINEER - W. S. BARNES AUG. 1974

FILED 2/
RECEIVED 74
- 7 1974
COUNTY SURVEYOR
CLATSOP COUNTY, ORE.
m. s.

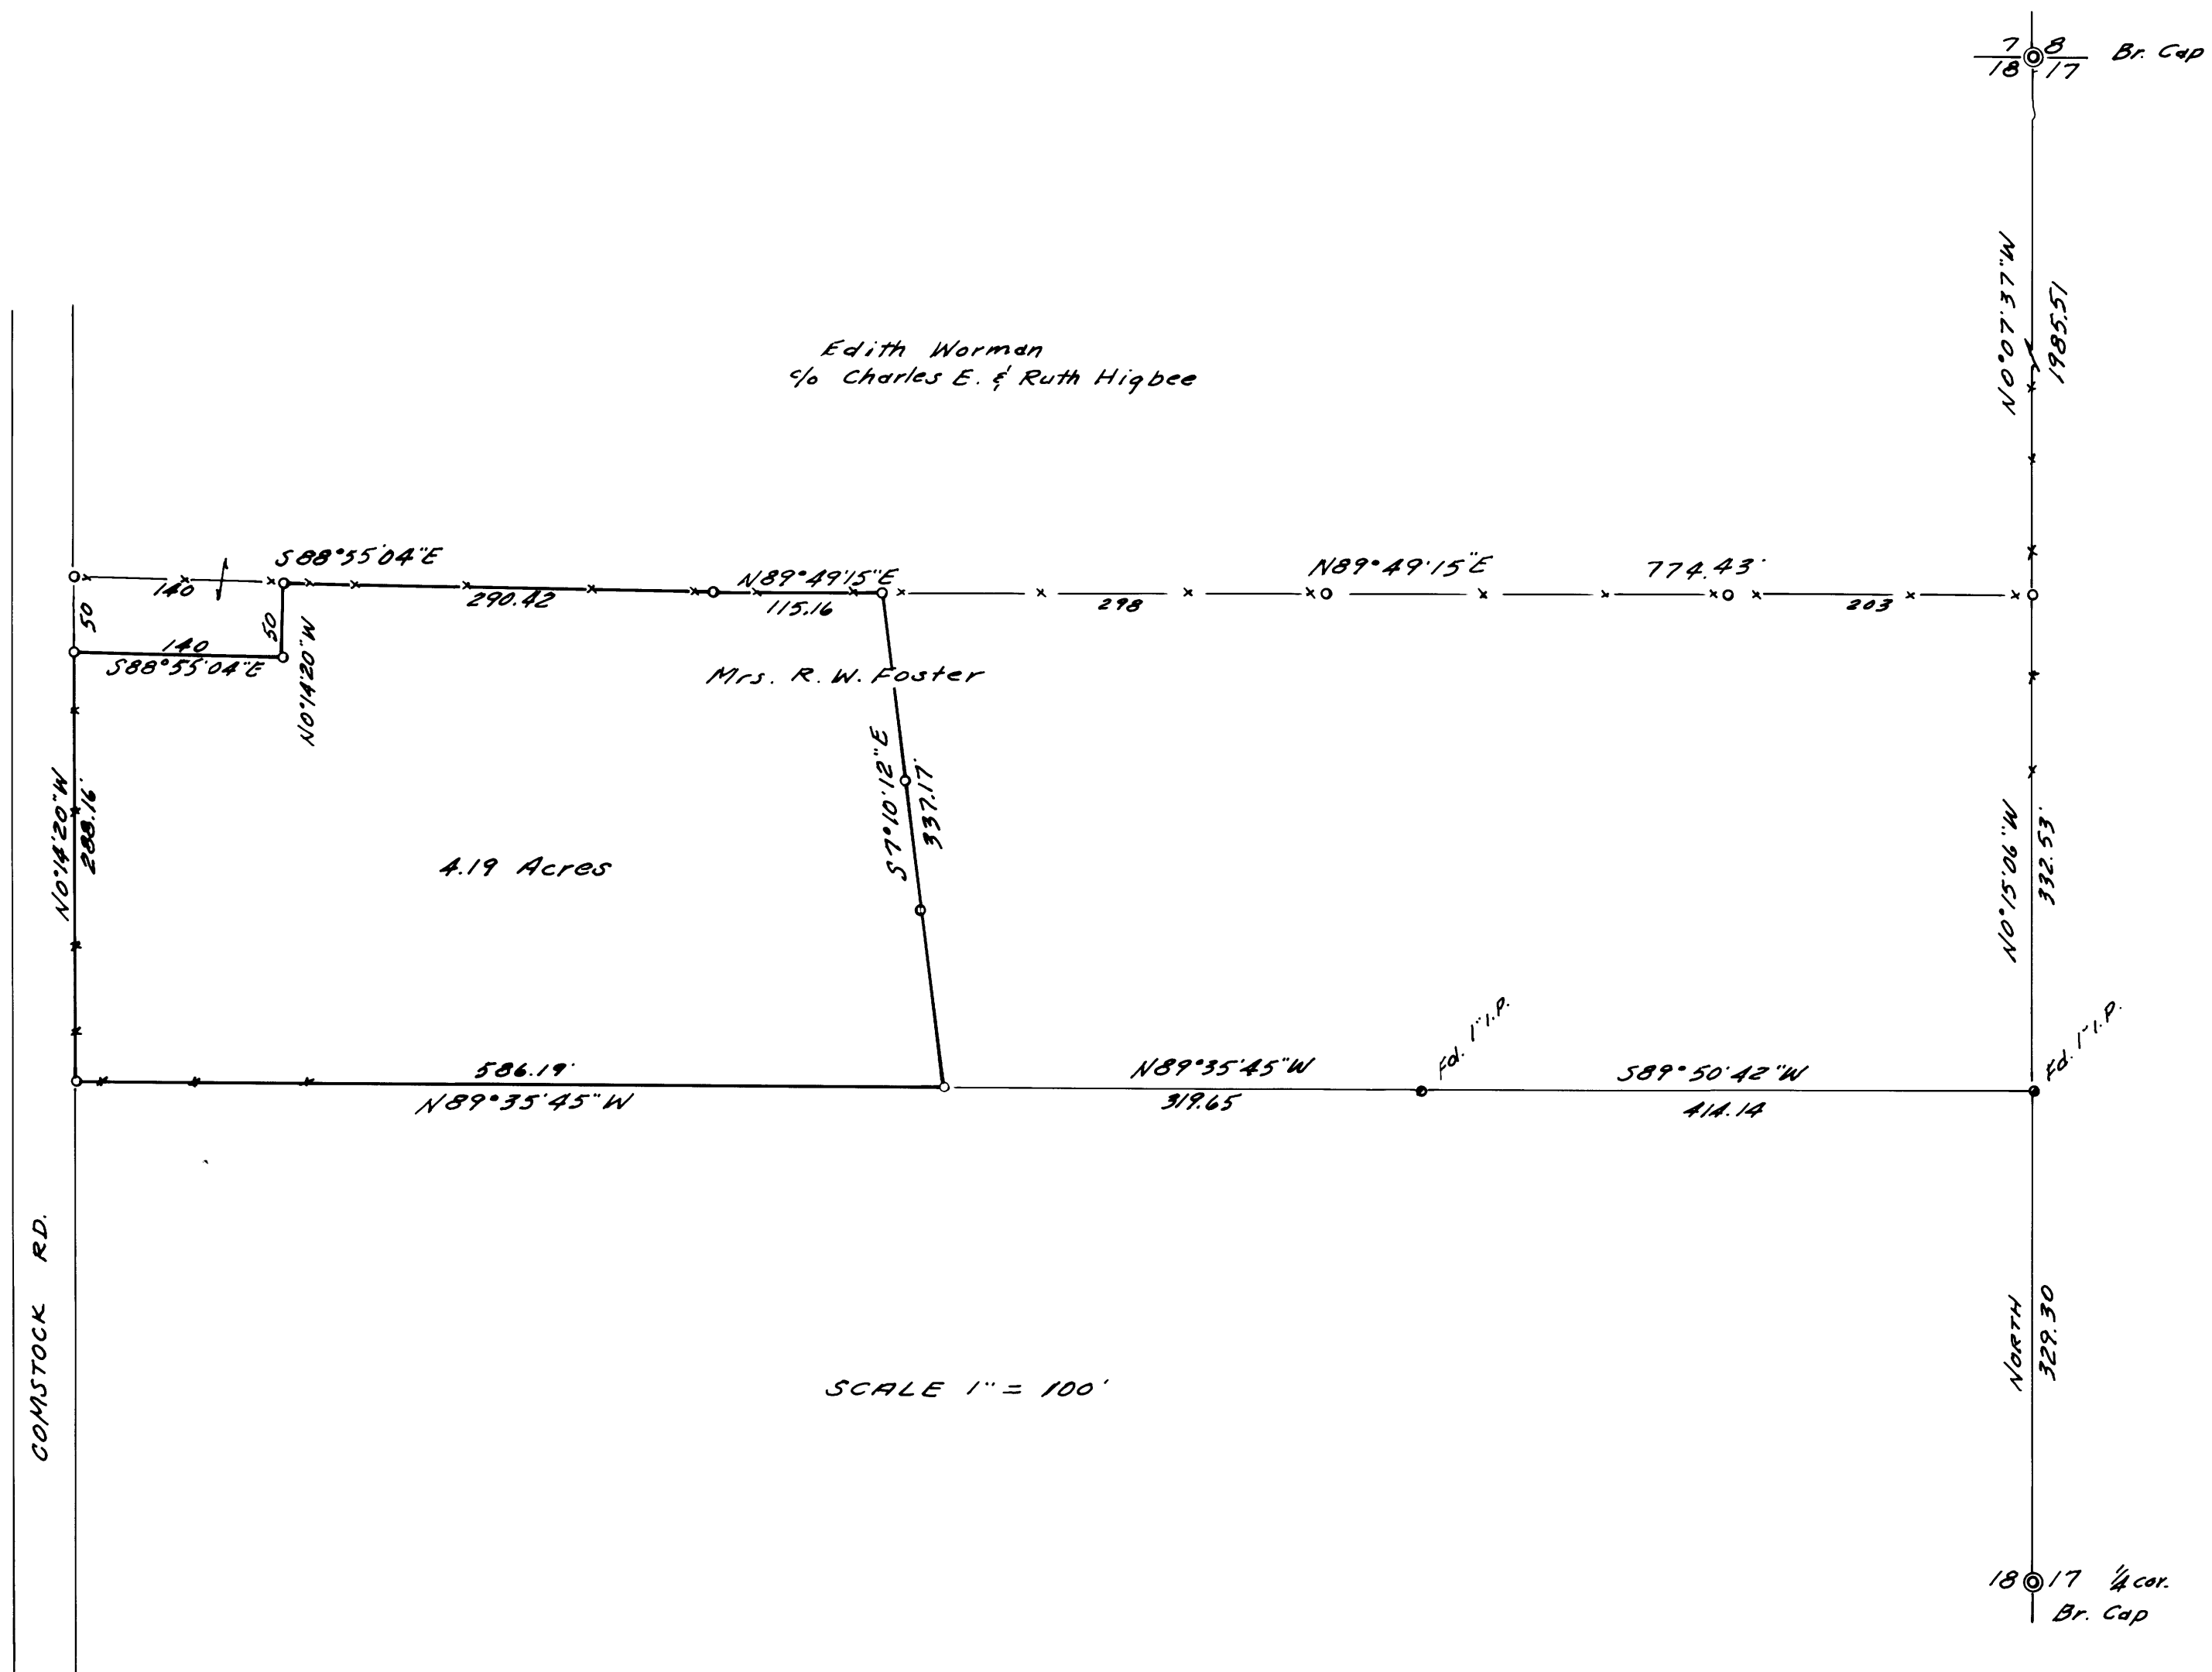

o Denotes 3/8" iron rods set
Base bearing taken from section line 18 17.

W. S. Barnes

MAP FILE M54 - 28

MAP FILE M54 - 28