

COUNTY SURVEYORS FILE DATA
DO NOT REMOVE FROM OFFICE

FILED ✓
RECEIVED 29

SEP 17 1974

COUNTY SURVEYOR
DOUGLAS COUNTY, ORE.
W.S. Barnes

SURVEY IN SEC. 16 & TRACT 37, T26S, R2W, W.M.

SURVEYED FOR - MAX LOCKWOOD
SURVEYED BY - W.S. BARNES

AUG. 1974
SCALE 1"=200'

Br. Cap.
M&M 1/4 Cor.
Sec. 17

S88°33'00"W 5137.9

1125.00'

Br. Cap.
M&M 1/4 Cor.
Sec. 15

Set 5/8" 1.rod

SOUTH 1600.00'

N 1°06'00"E
1768.70

74.73 Acres.

Set 5/8" 1.rod

Br. Cap.
N.E. Cor.
Tract 37

S54°15'54"W
807.36

N 2°37'50"W
804.76

Lockwood's access road

No. Umpqua Hwy.

N 0°02'16"W
580.00


15/22 Br. Cap

Set 5/8" 1.rod

Ed. 1" I.P.

SMITH
SPRINGS
COUNTY PARK

Note: Base bearing taken from West line of Sec. 15
G.L.O. survey records show the east and west
1/4 cor.s of Sec. 16 to be common corners with
Sec.s 15 & 17 respectively.

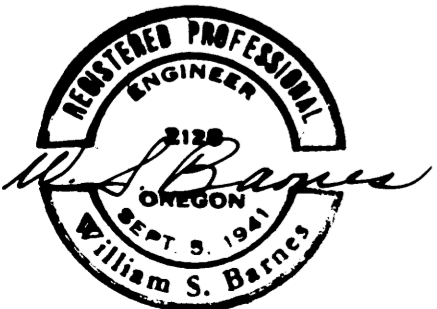

4/11/76 REVISED IN PART - SEE M56-46