

SURVEY TO SET PROPERTY CORNERS

METES & BOUNDS PARCEL IN LOT 8 GLEN D. HART TRACT

IN SEC. 21, T.28S., R.6W.W.M.

FOR TWIN CITY BUILDERS INC.
BY BAUGHMAN SURVEYING SERVICE
FEBRUARY 1975 SCALE 1" = 50'


COUNTY SURVEYORS FILE DATA
DO NOT REMOVE FROM OFFICE

FILED 27
RECEIVED 27
FEB 13 1975
COUNTY SURVEYOR
DOUGLAS COUNTY, MO.

I, GLENN S. BAUGHMAN, DEPOSE AND SAY THAT I HAVE CORRECTLY SURVEYED AND MARKED WITH PROPER MONUMENTS THE LANDS DELINEATED ON THE ANNEXED MAP.

Glenn S. Baughman

Glenn S. Baughman

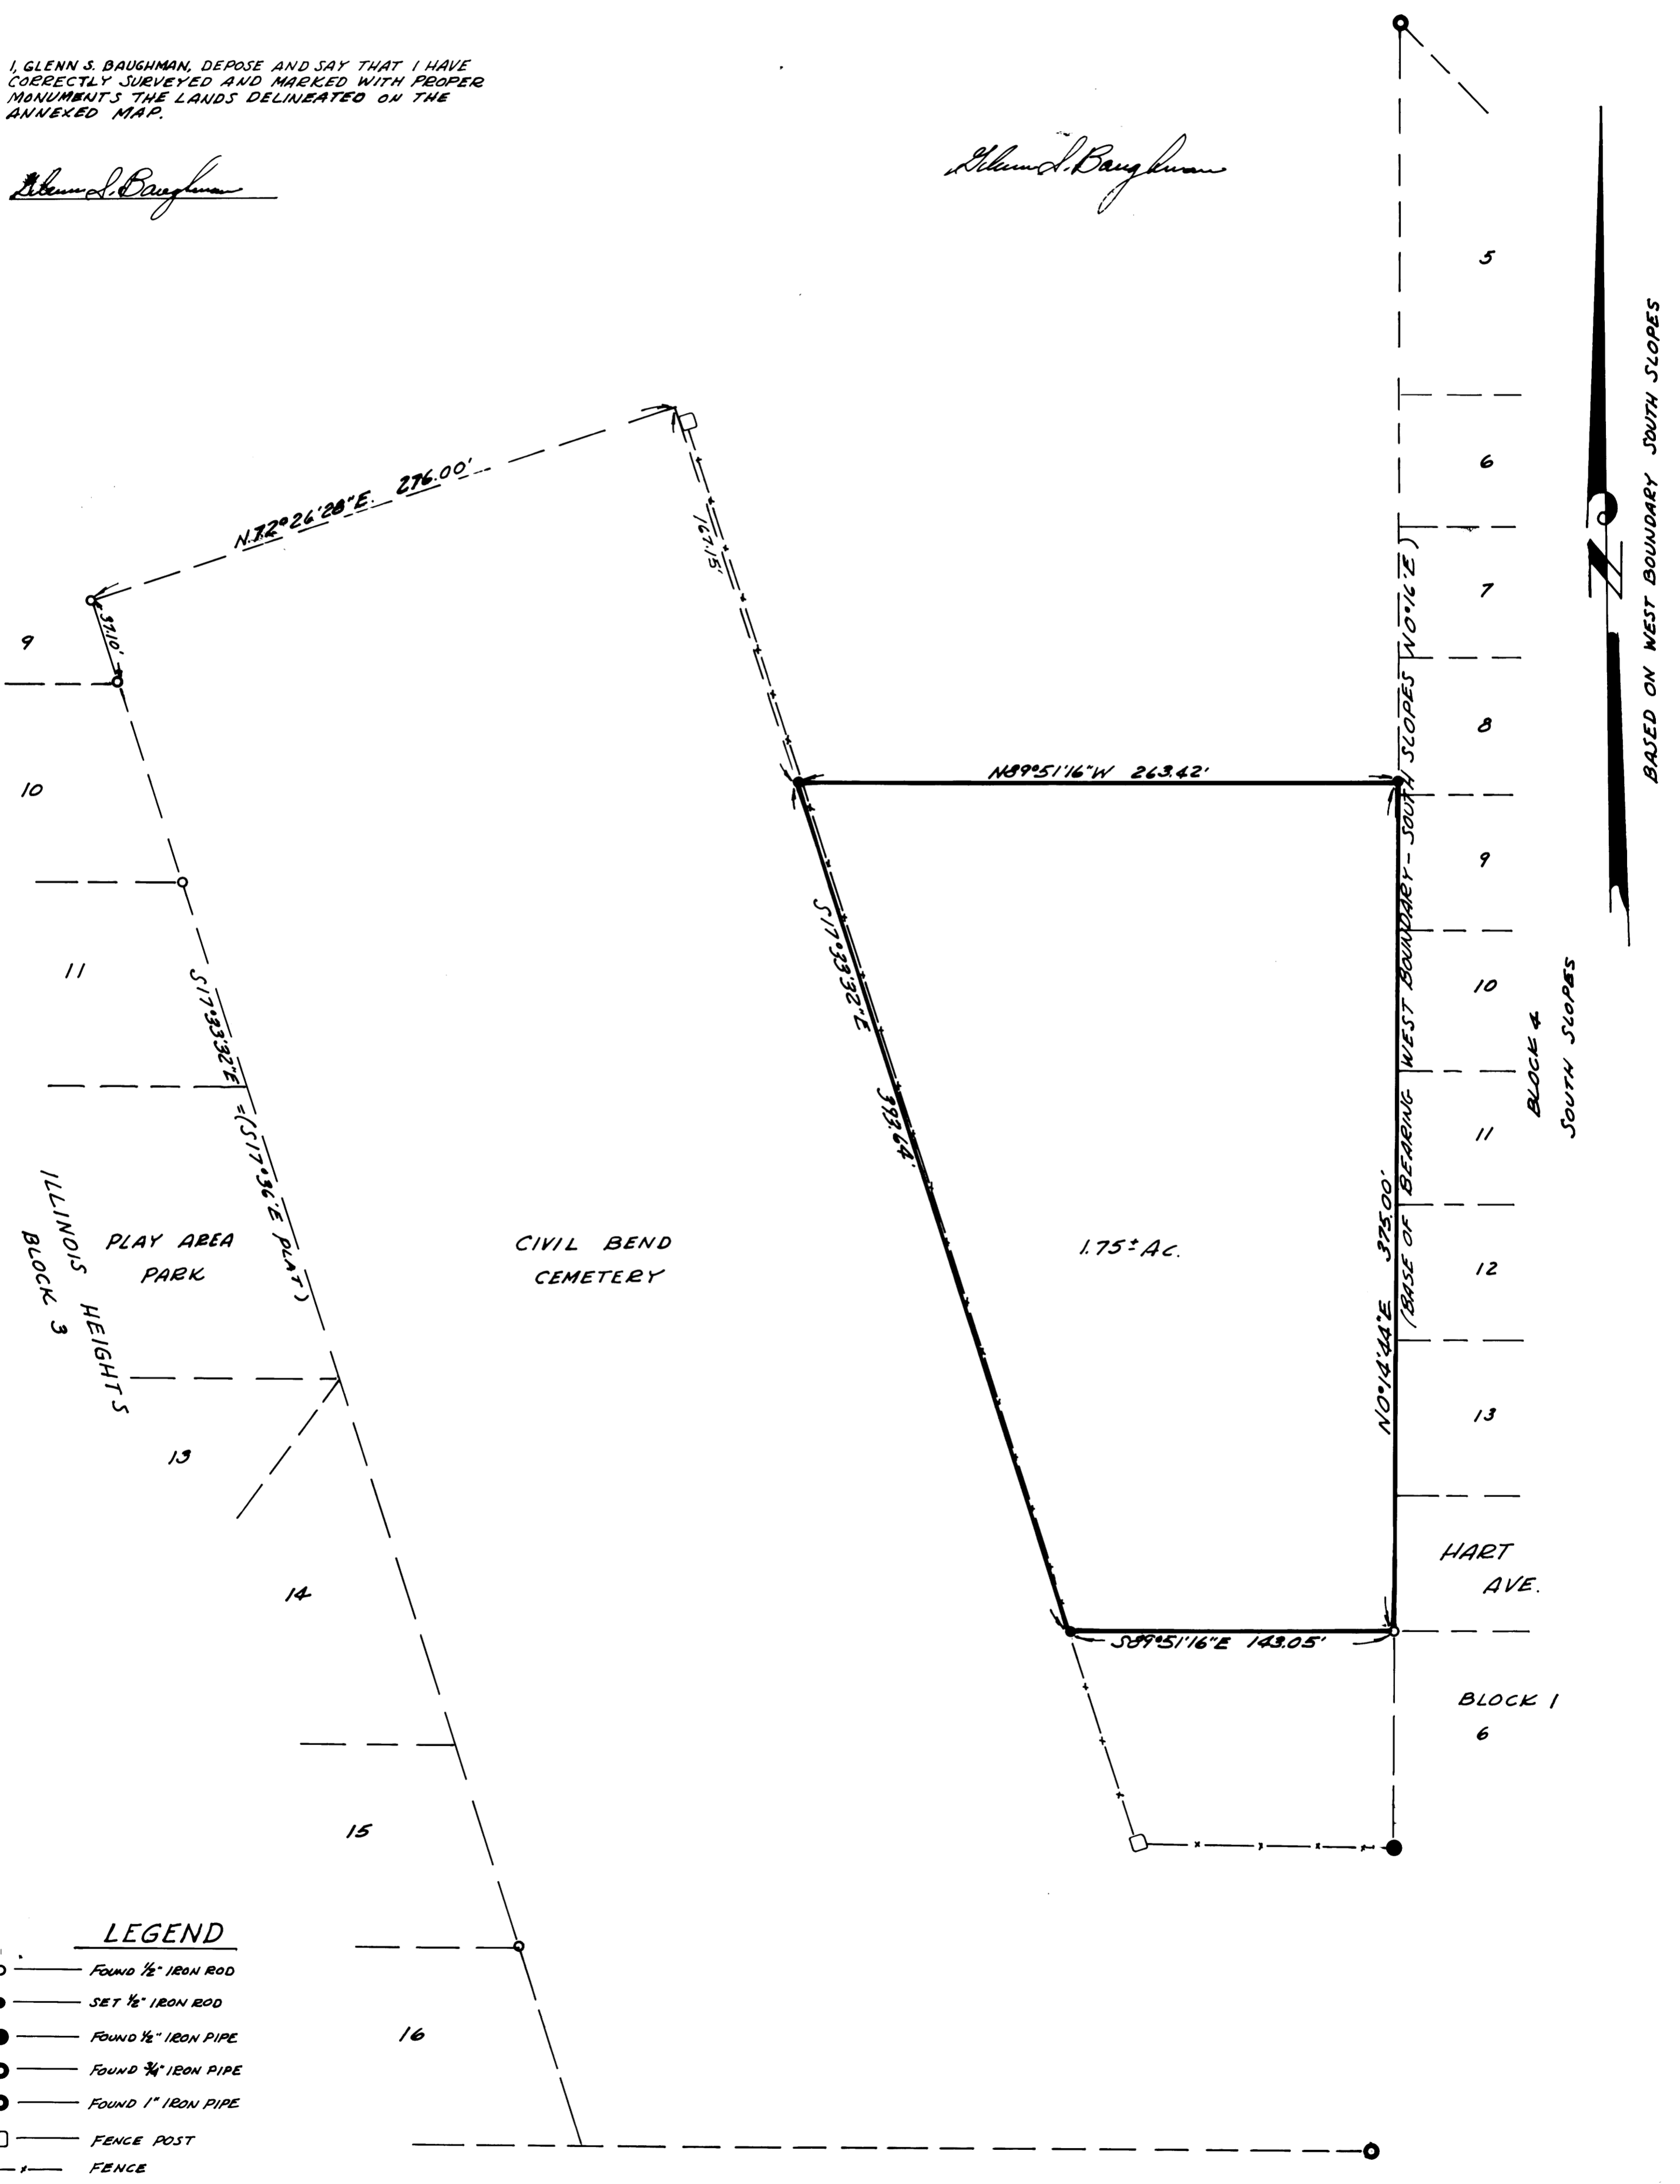

LEGEND

- \circ — FOUND 1/2" IRON ROD
- \bullet — SET 1/2" IRON ROD
- \ominus — FOUND 1/2" IRON PIPE
- \odot — FOUND 3/4" IRON PIPE
- \bullet — FOUND 1" IRON PIPE
- \square — FENCE POST
- — — — — FENCE