


SURVEY TO SET PROPERTY CORNERS
IN SECTIONS 17 & 18, T.27S., R.6 W.W.M.
FOR DR. JOHN NASH
BY BAUGHMAN SURVEYING SERVICE
FEBRUARY 1975 SCALE 1"=100'

FILED 2
RECEIVED 24
FEB 19 1975
COUNTY SURVEYOR
DOUGLAS COUNTY, ORE.

MAP FILE M.555 - 33...

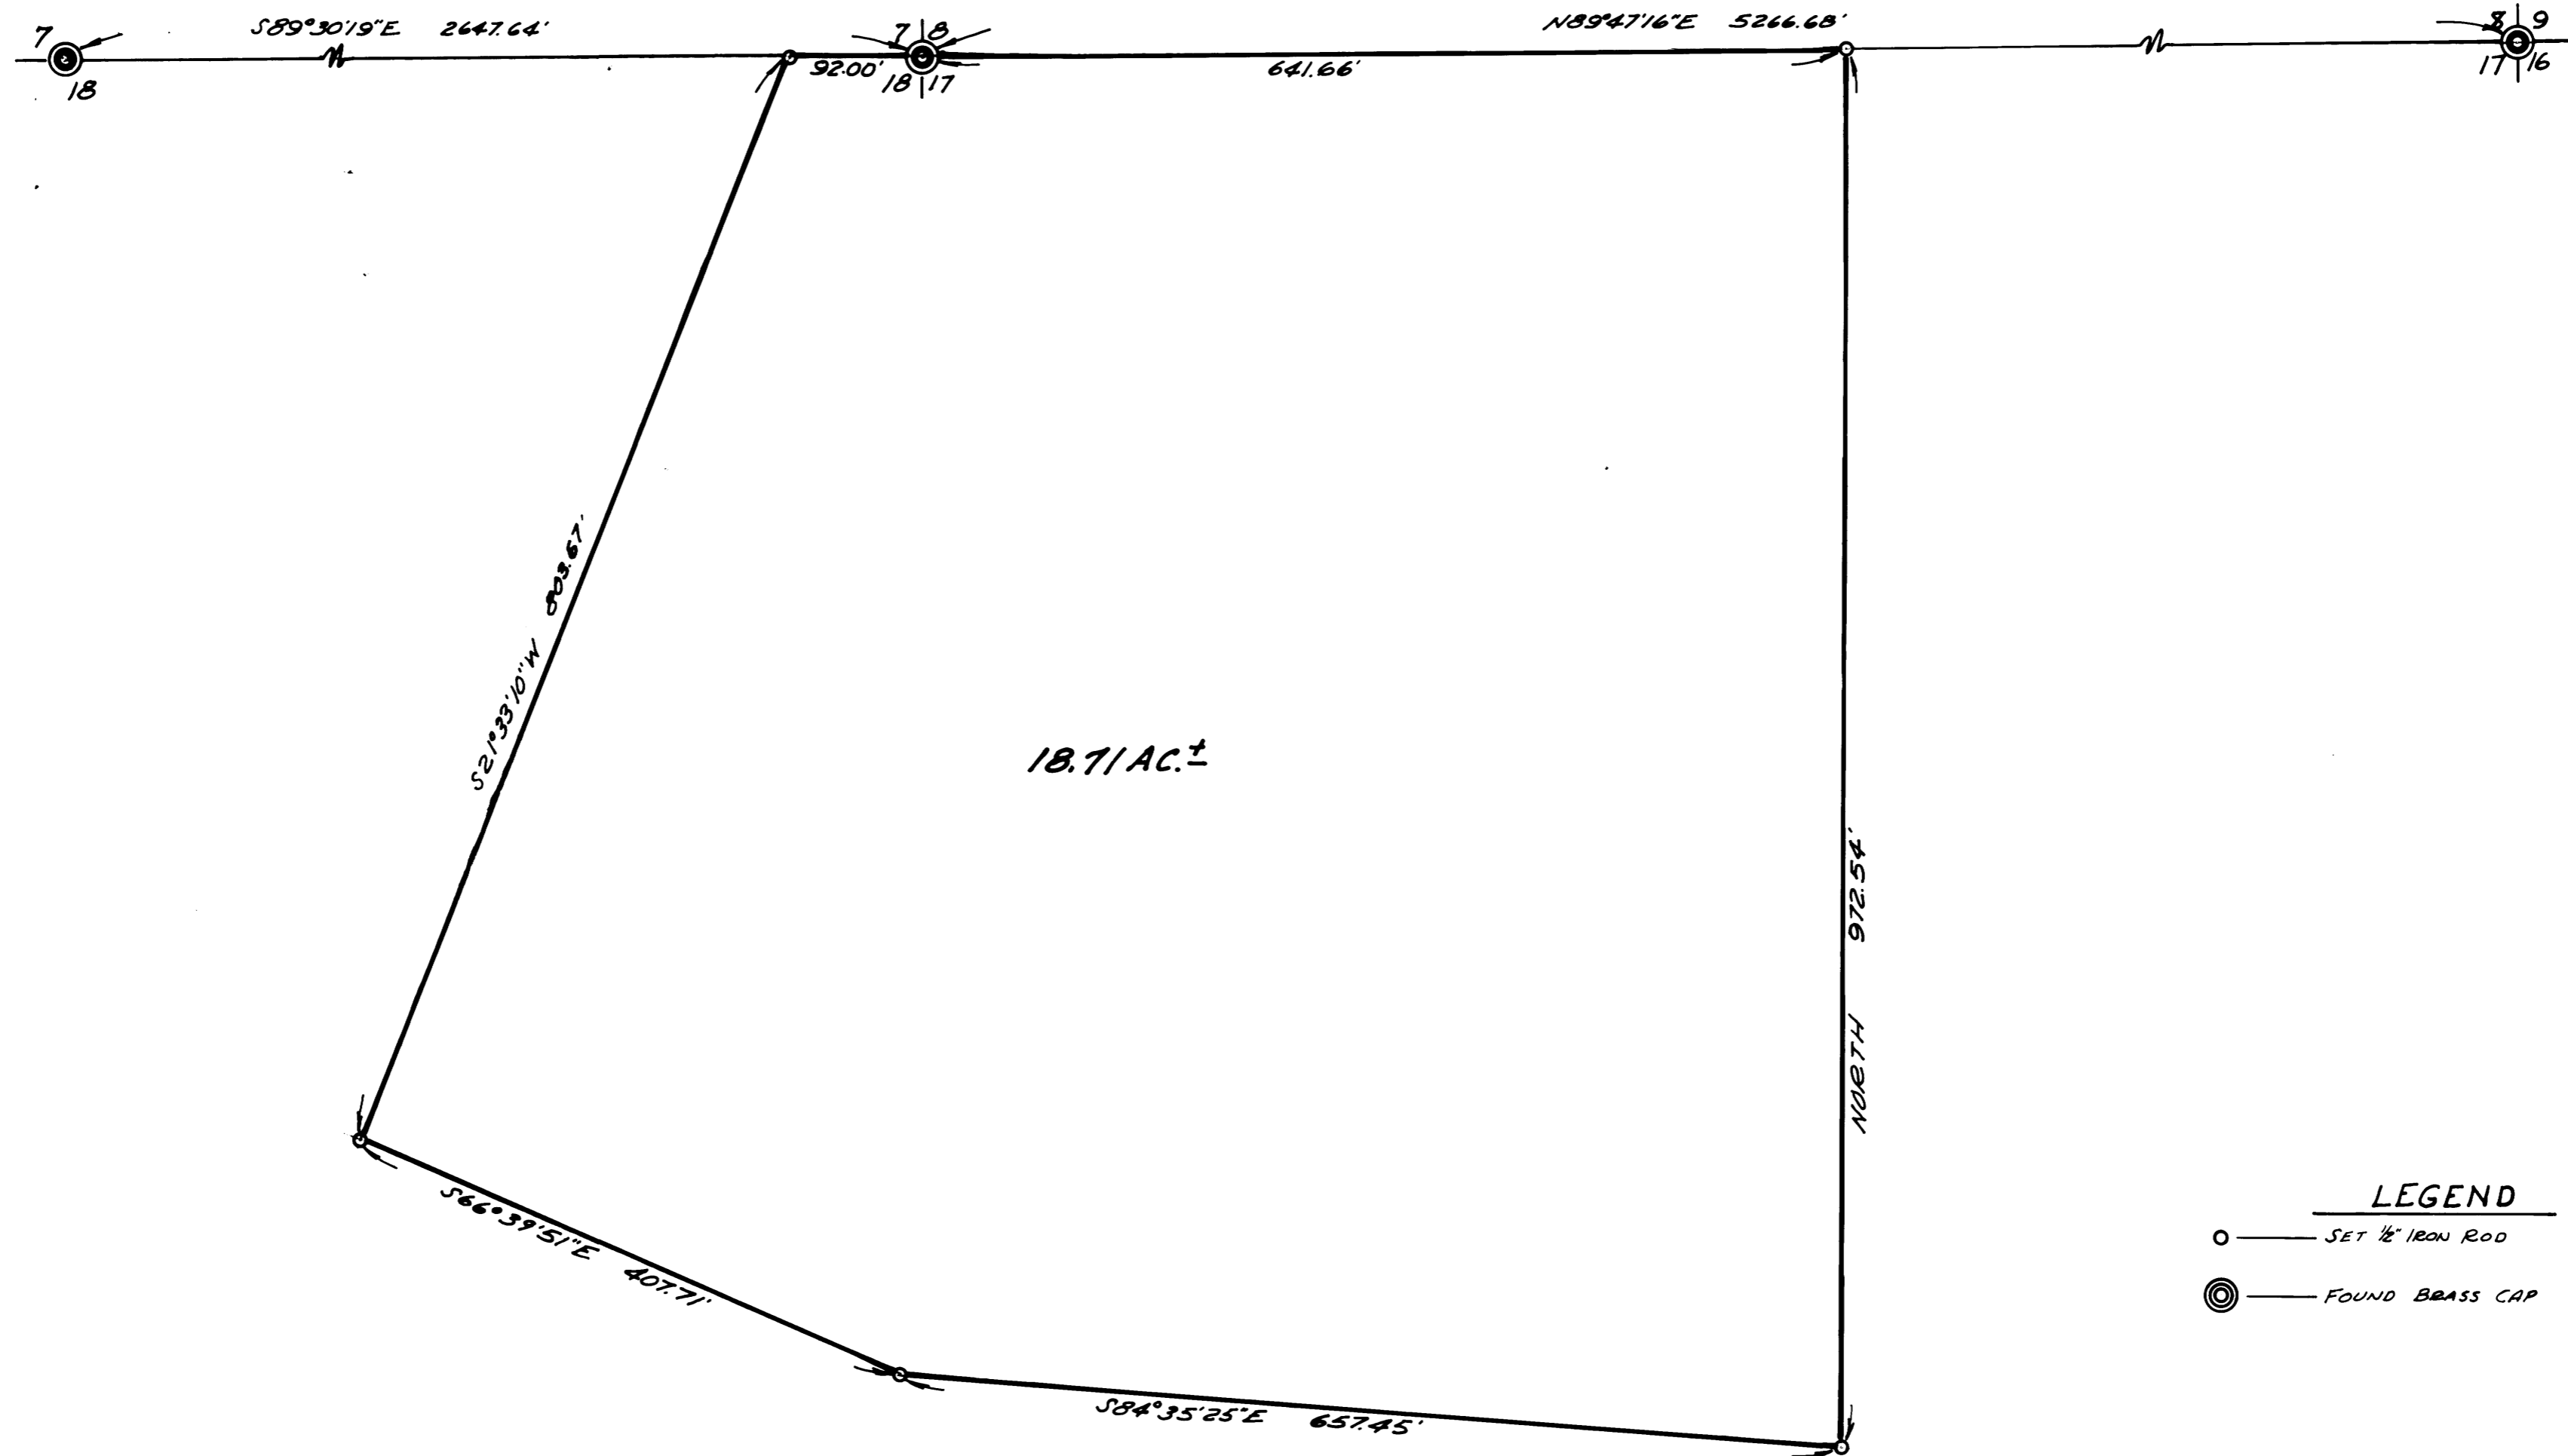

BEARINGS BASED ON OAKES OAKS SUBDIVISION

LEGEND

- — SET 1/2" IRON ROD
- ⊗ — FOUND BRASS CAP

Almond Baughman

MAP FILE M.555 - 33...