

COUNTY SURVEYORS FILE DATA  
DO NOT REMOVE FROM OFFICE

# SURVEY TO SET PROPERTY CORNERS IN SEC. 18, T. 26 S., R. 3 W. W.M.

## FOR - GUY SANDS & C. F. CHRISTENSON BY - BAUGHMAN SURVEYING SERVICE

APRIL, 1975 SCALE 1" = 100'

FILED 2  
RECEIVED 24  
APR 30 1975  
COUNTY SURVEYOR  
DOUGLAS COUNTY, ORE.  
2


REGISTERED  
PROFESSIONAL  
LAND SURVEYOR

*Glenn S. Baughman*

OREGON  
JULY 14, 1967  
GLENN S. BAUGHMAN  
536

### LEGEND

- SET 1/2" I.R.
- FD. 5/8" I.R.
- FD. 1" I.P.
- ⊙ FD. BRASS CAP ON 1" I.P.

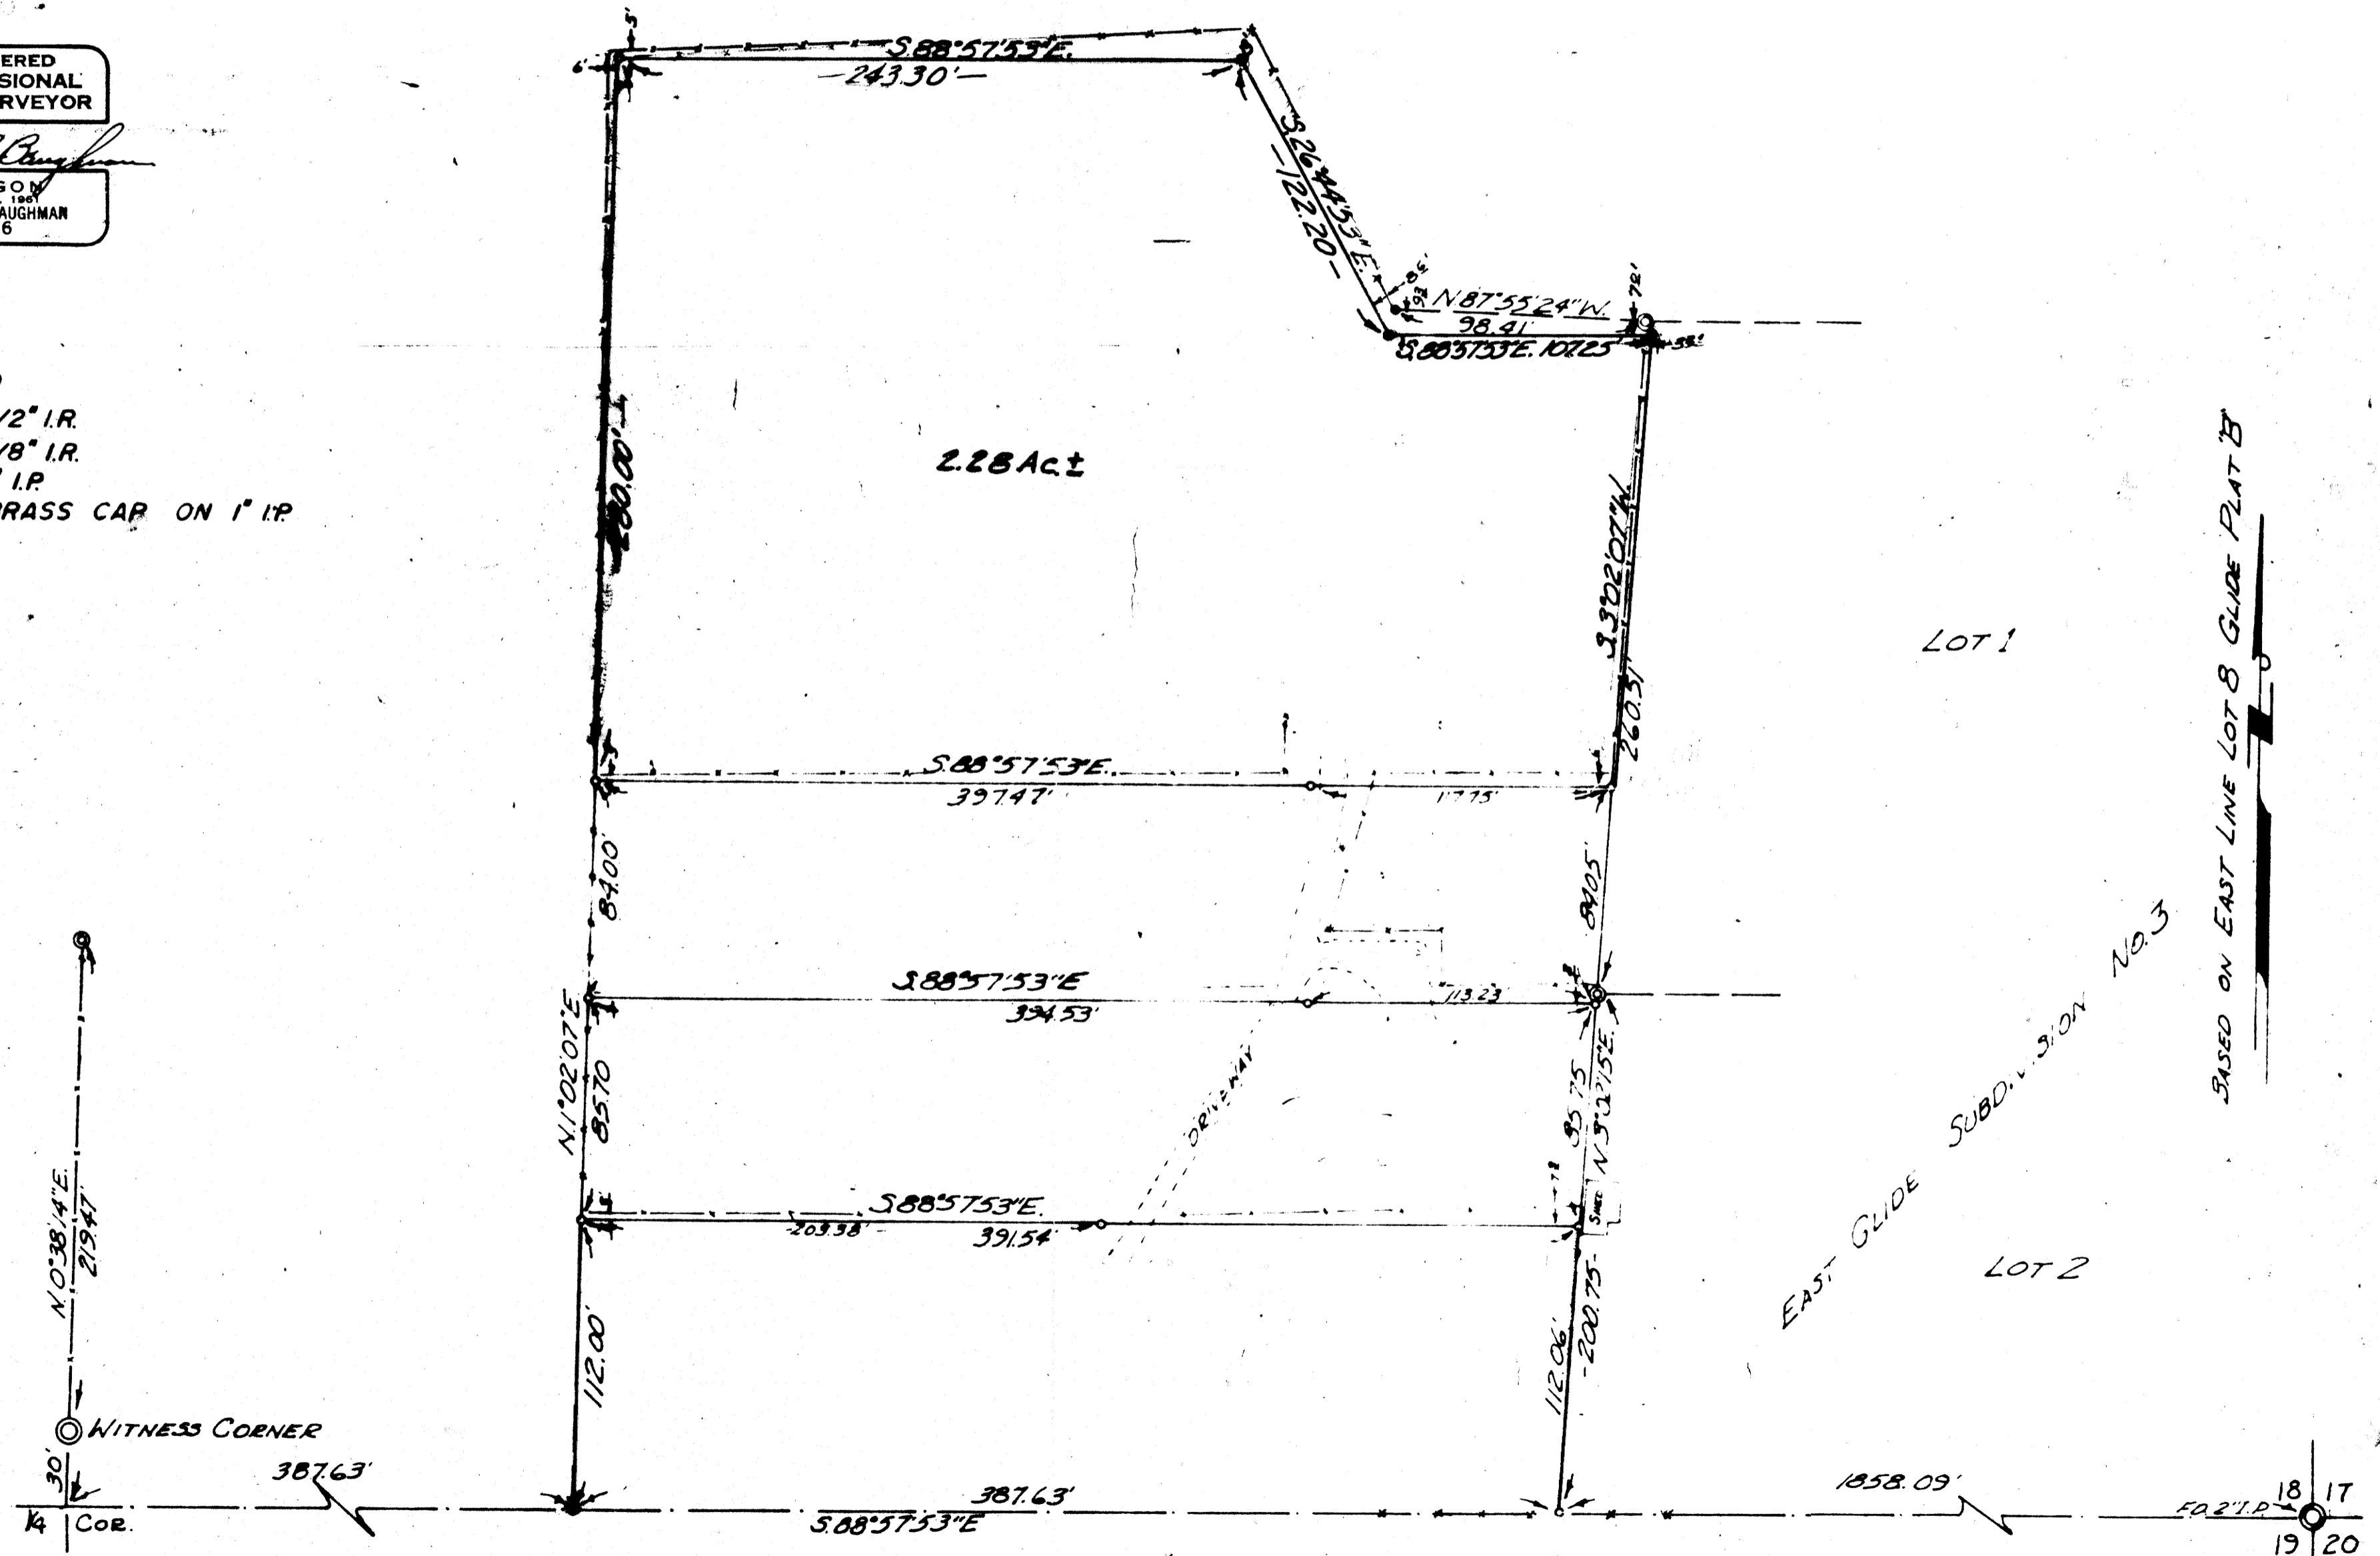

MAP FILE M-55 - 22