

FILED  
RECEIVED  
AUG 21 1975  
COUNTY SURVEYOR  
DOUGLAS COUNTY, OREG.


SURVEY FOR DEED DESCRIPTION  
IN MELROSE ORCHARDS  
SEC. 36, T. 26 S., R. 7 W. W. M.  
FOR JACK RUSSELL  
BY BRUCE ROGERS  
AUG., 1975  
1" = 50'

Bruce C. Rogers

RUSSELL, JACK & MARY JANE  
73-6679

FARRELL, MARSHALL & CATHERINE  
66-1874

AMIS, WALTER  
TARRANTS CERTIFICATE  
6547  
75-2964

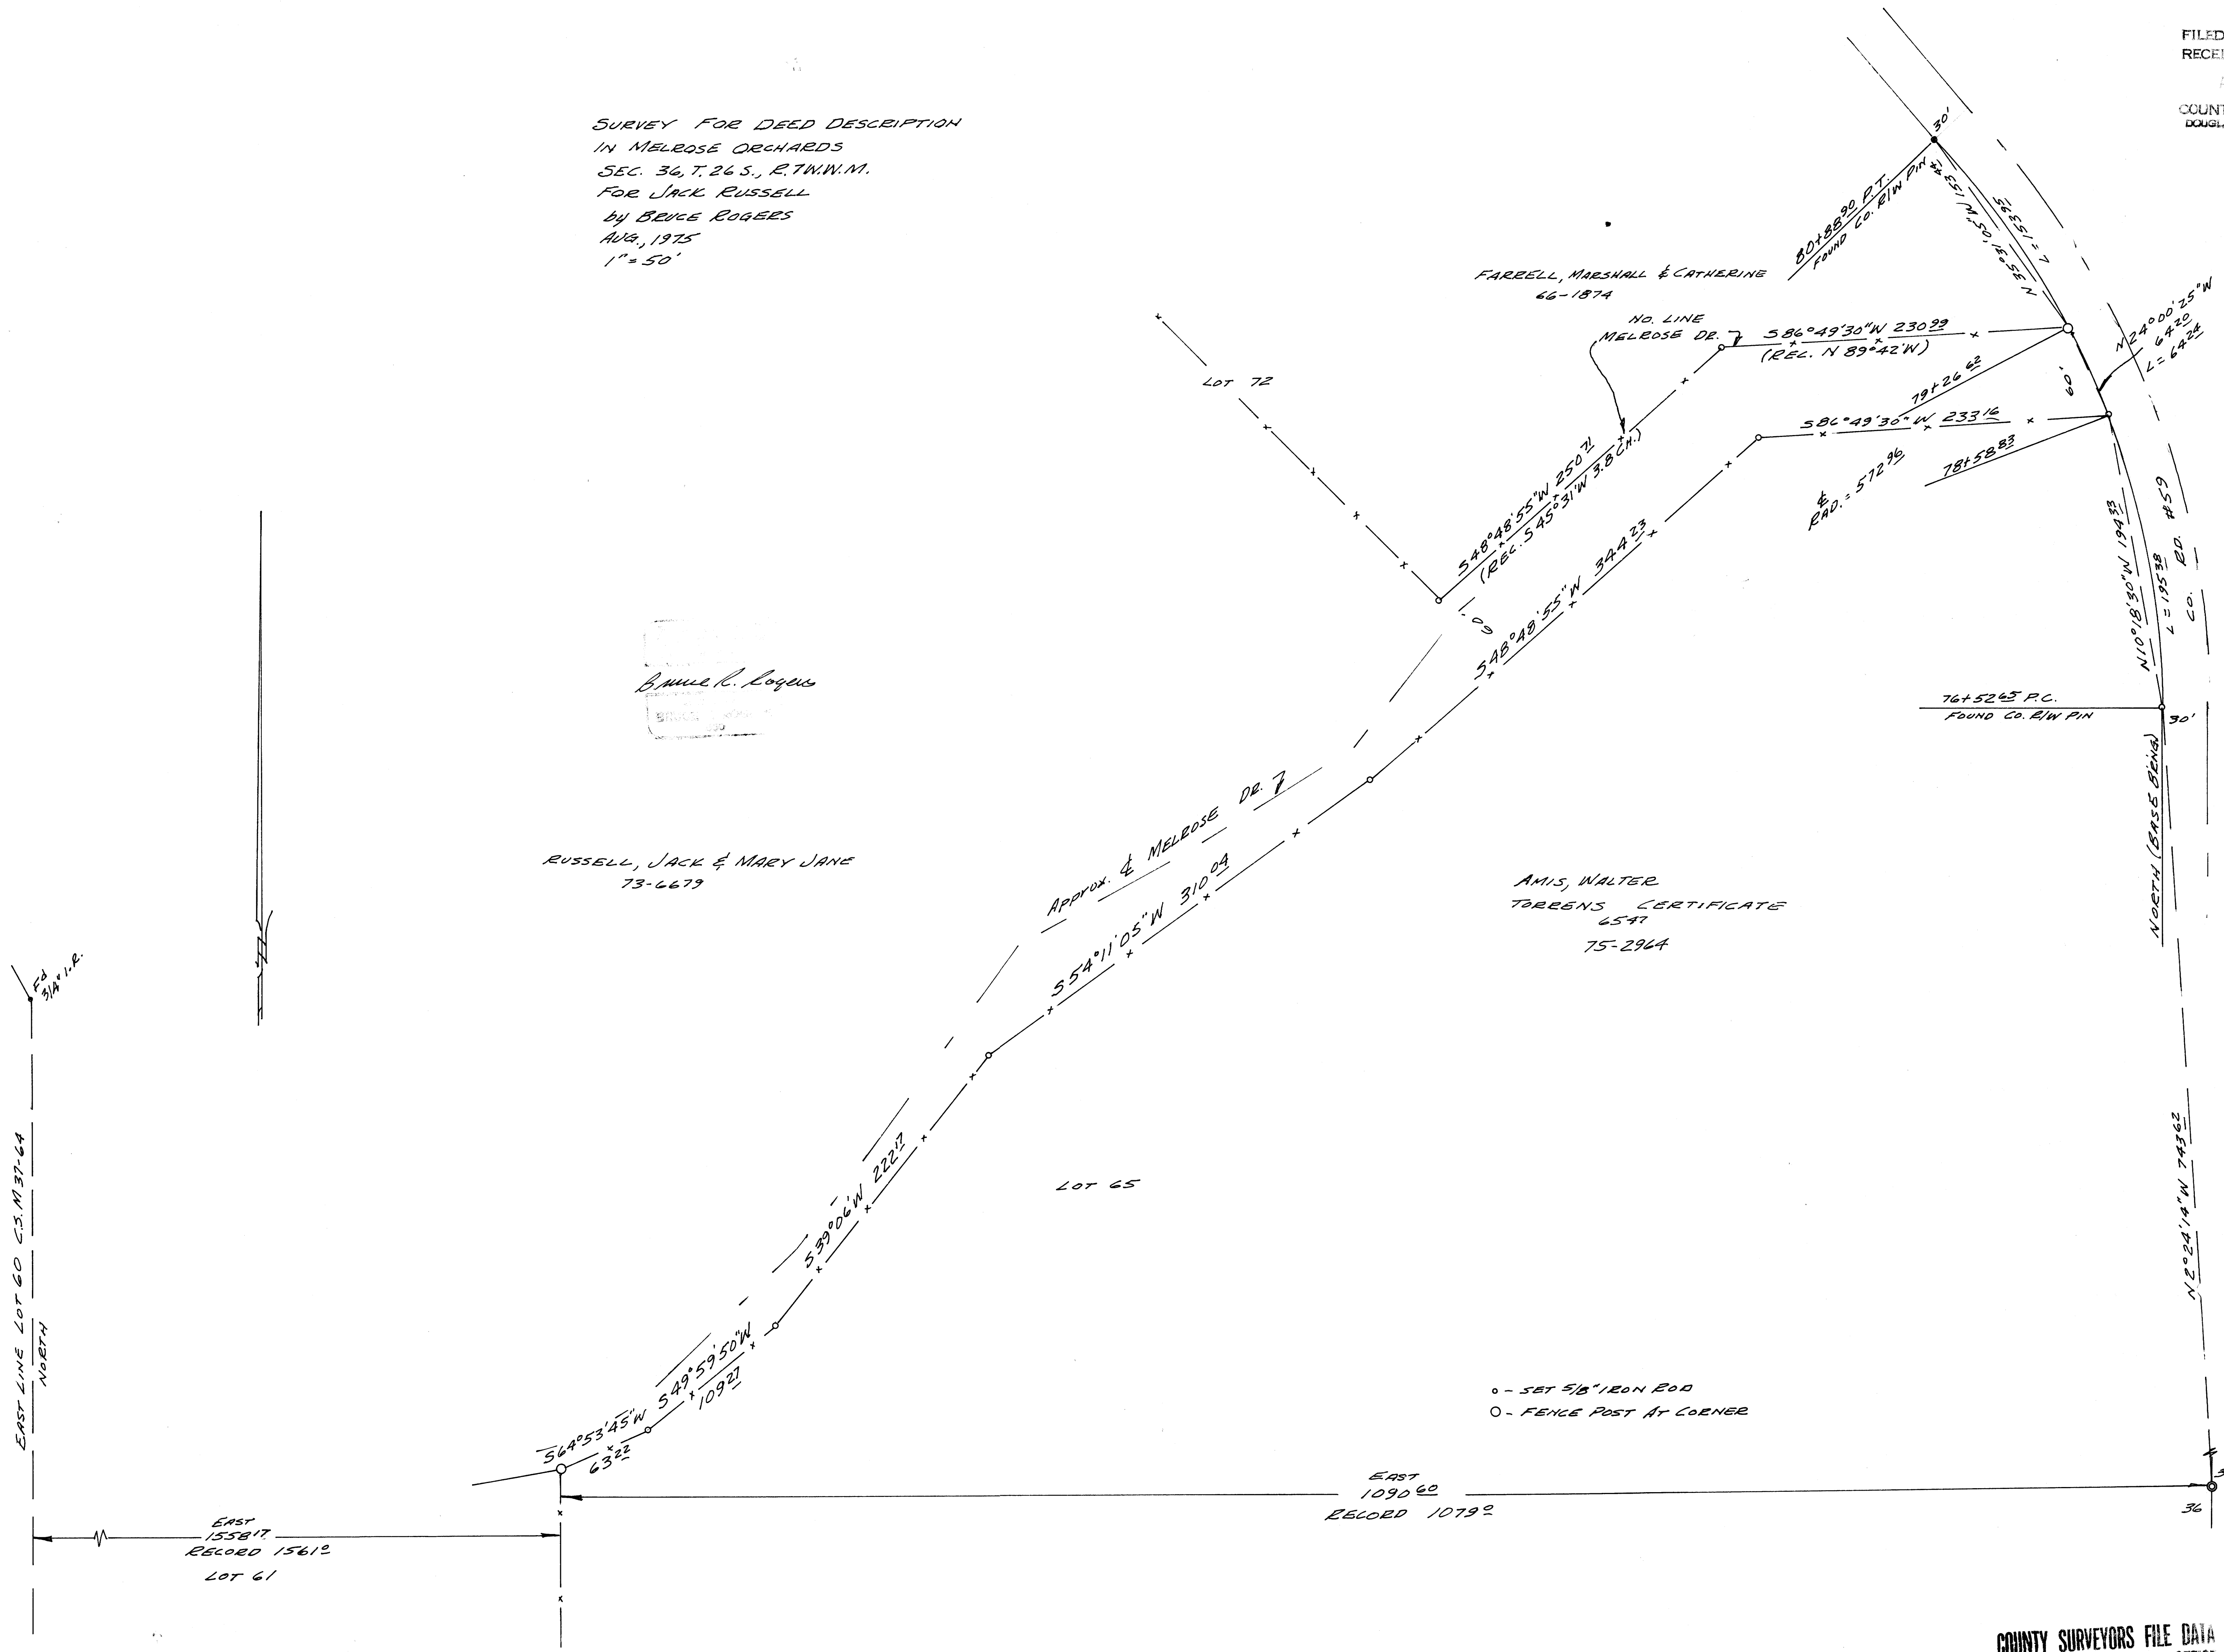

- o - SET 5/8" IRON ROD
- o - FENCE POST AT CORNER