

COUNTY SURVEYORS FILE DATA
DO NOT REMOVE FROM OFFICE

SECTION 9


9 | 10
16 | 15

FILED
RECEIVED

OCT 4 1976


FIELD SURVEY
for
ORAL JONES

SECTION 16
T.30 S., R.4 W., W.M.

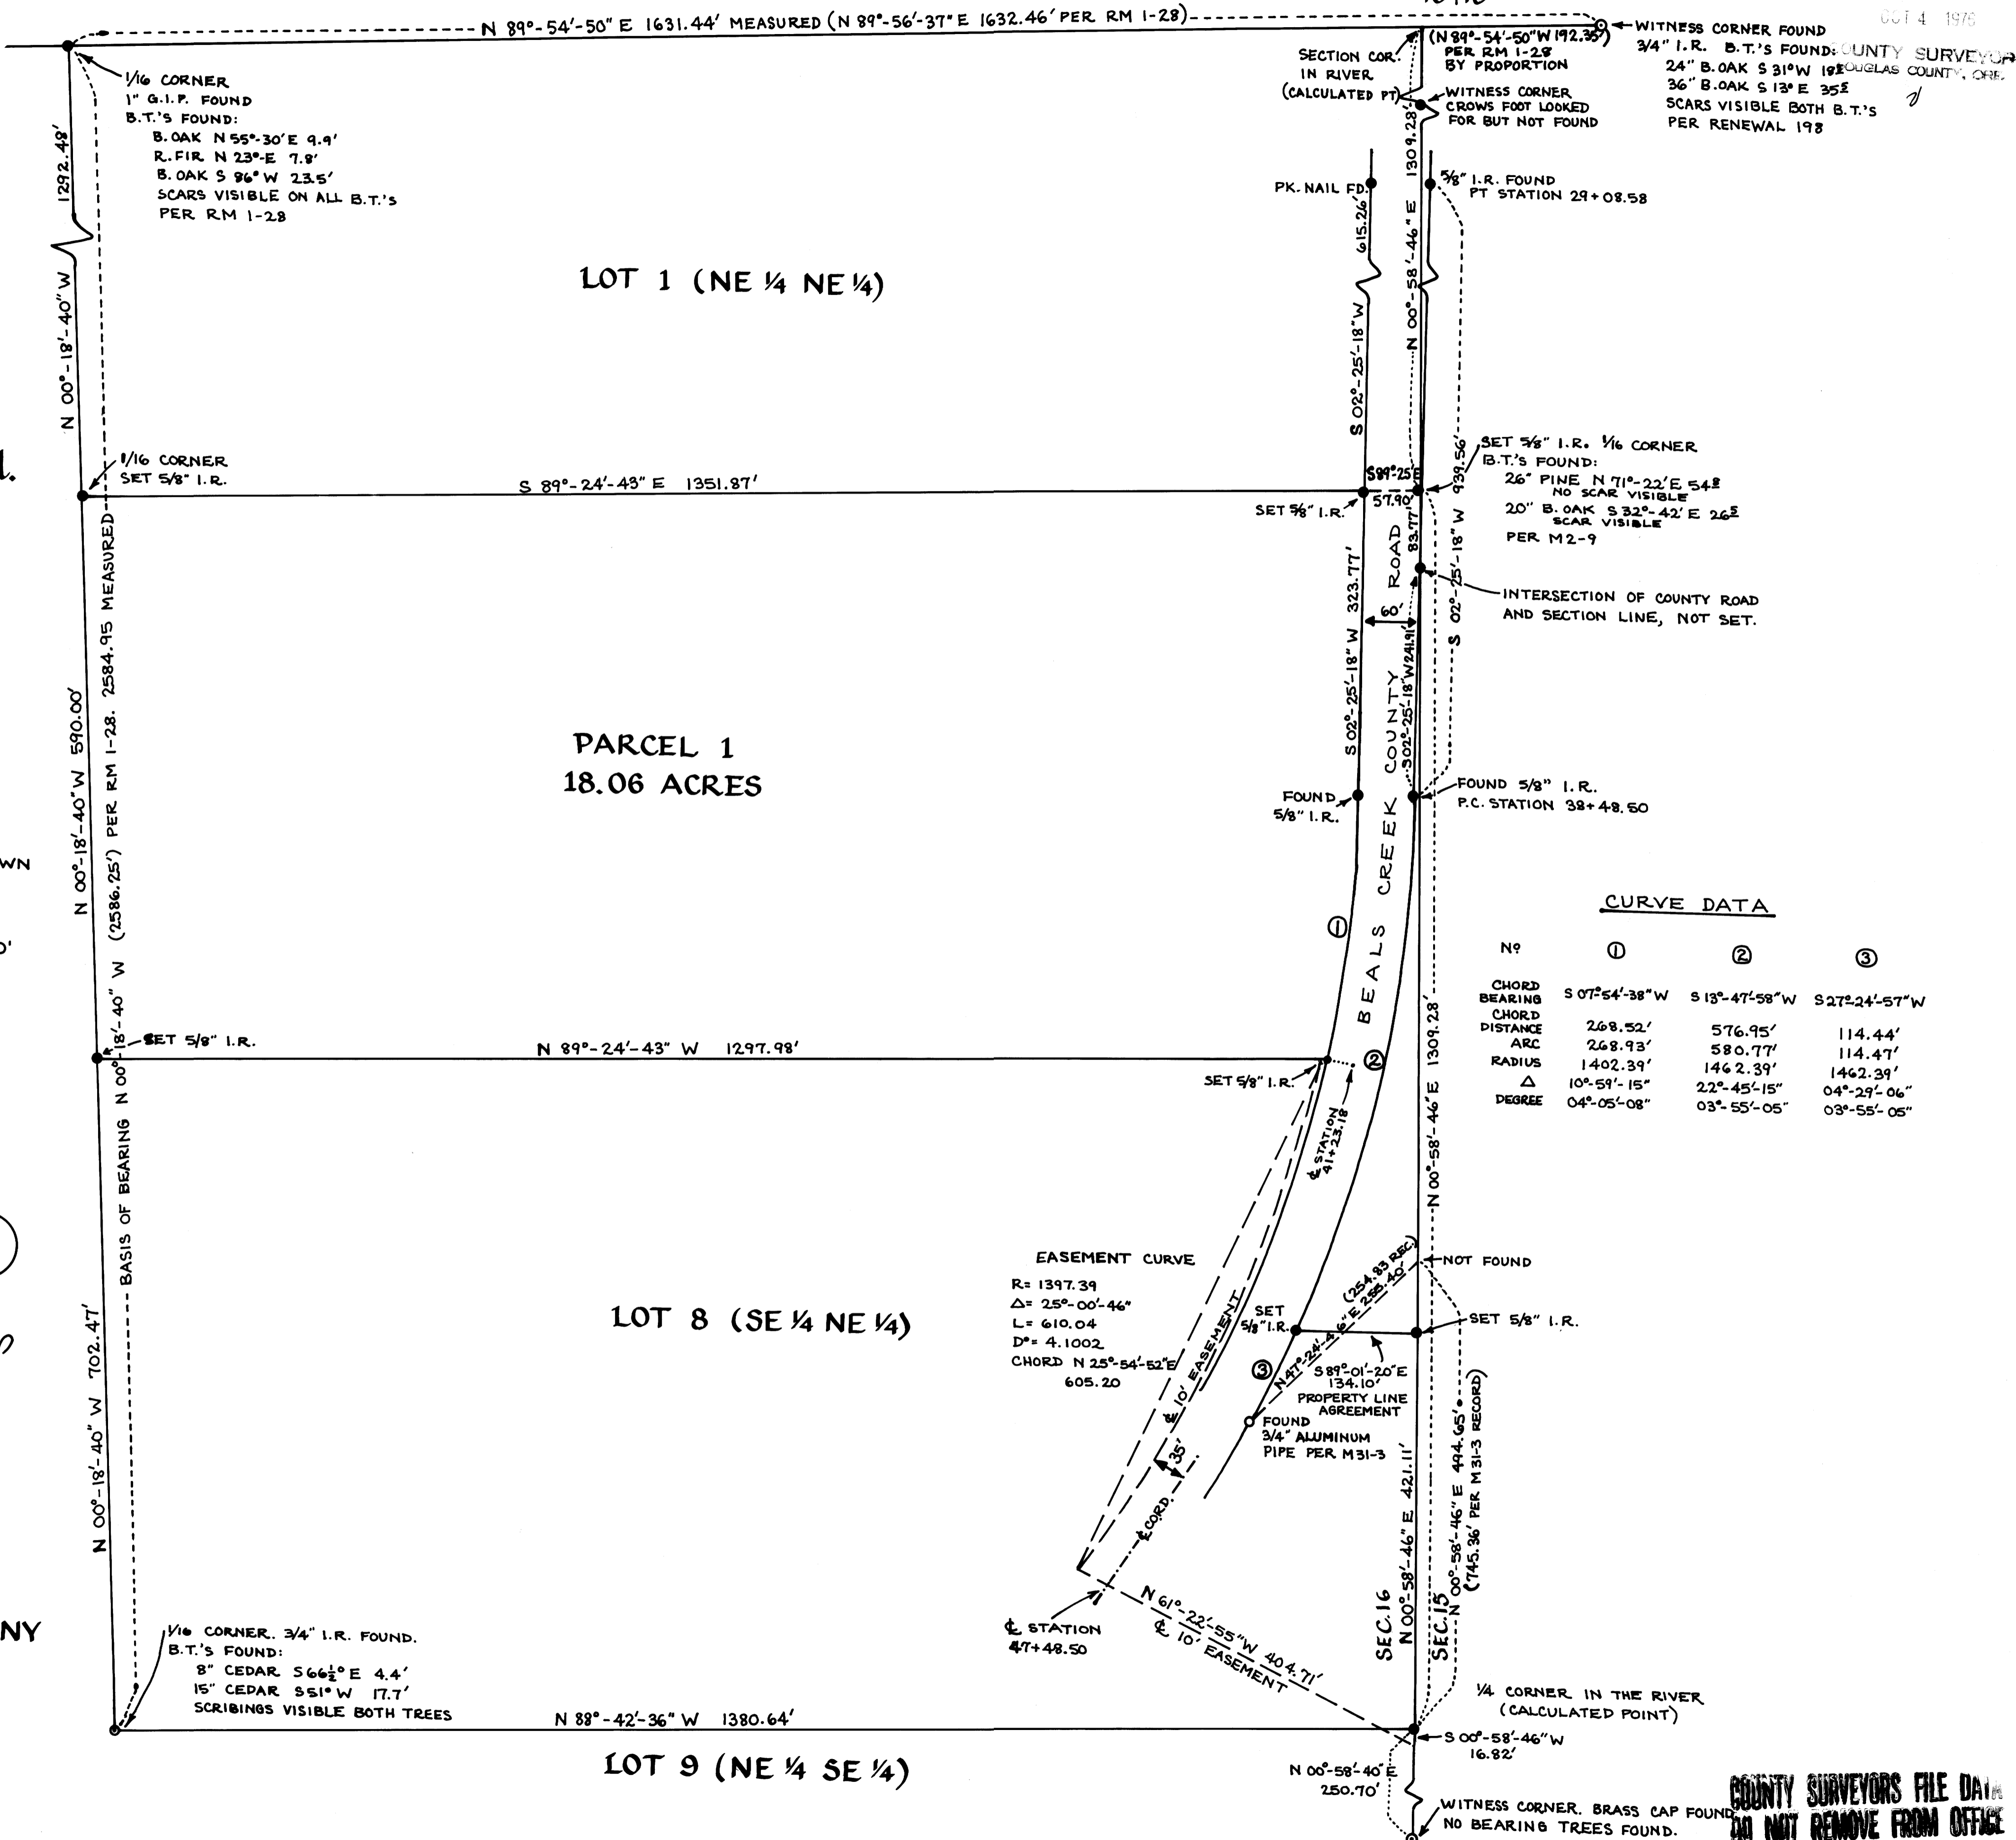

LEGEND:
AS SHOWN

SCALE:
1" = 100'

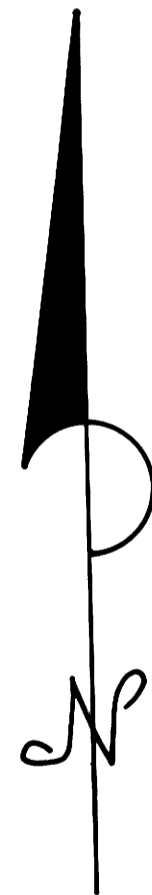

CURVE DATA

Nº	①	②	③
CHORD BEARING	S 07°-54'-38" W	S 13°-47'-58" W	S 27°-24'-57" W
CHORD DISTANCE	268.52'	576.95'	114.44'
ARC	268.93'	580.77'	114.47'
RADIUS	1402.39'	1462.39'	1462.39'
Δ	10°-59'-15"	22°-45'-15"	04°-29'-06"
DEGREE	04°-05'-08"	03°-55'-05"	03°-55'-05"

EASEMENT CURVE
R= 1397.39
Δ= 25°-00'-46"
L= 610.04
D°= 4.1002
CHORD N 25°-54'-52" E
605.20

REGISTERED
OREGON
LAND SURVEYOR
William J. Ruppert
JULY 12, 1968
WILLIAM J. RUPPERT
866

UMPQUA RESEARCH COMPANY
MYRTLE CREEK, OREGON
September 1976

COUNTY SURVEYORS FILE DATA
DO NOT REMOVE FROM OFFICE