


SURVEY FOR U.S. FOREST SERVICE IN SECTION 19, T.32S. R.1W.W.M., DOUGLAS & JACKSON COUNTY, OREGON BY: C & G ENGINEERING INC.

DECEMBER 1976


SCALE: 1" = 400'

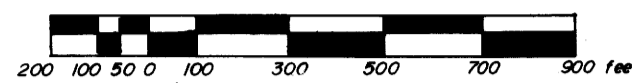

FILED 2
RECEIVED 025

JAN 21 1977

COUNTY SURVEYOR
DOUGLAS COUNTY, ORE.


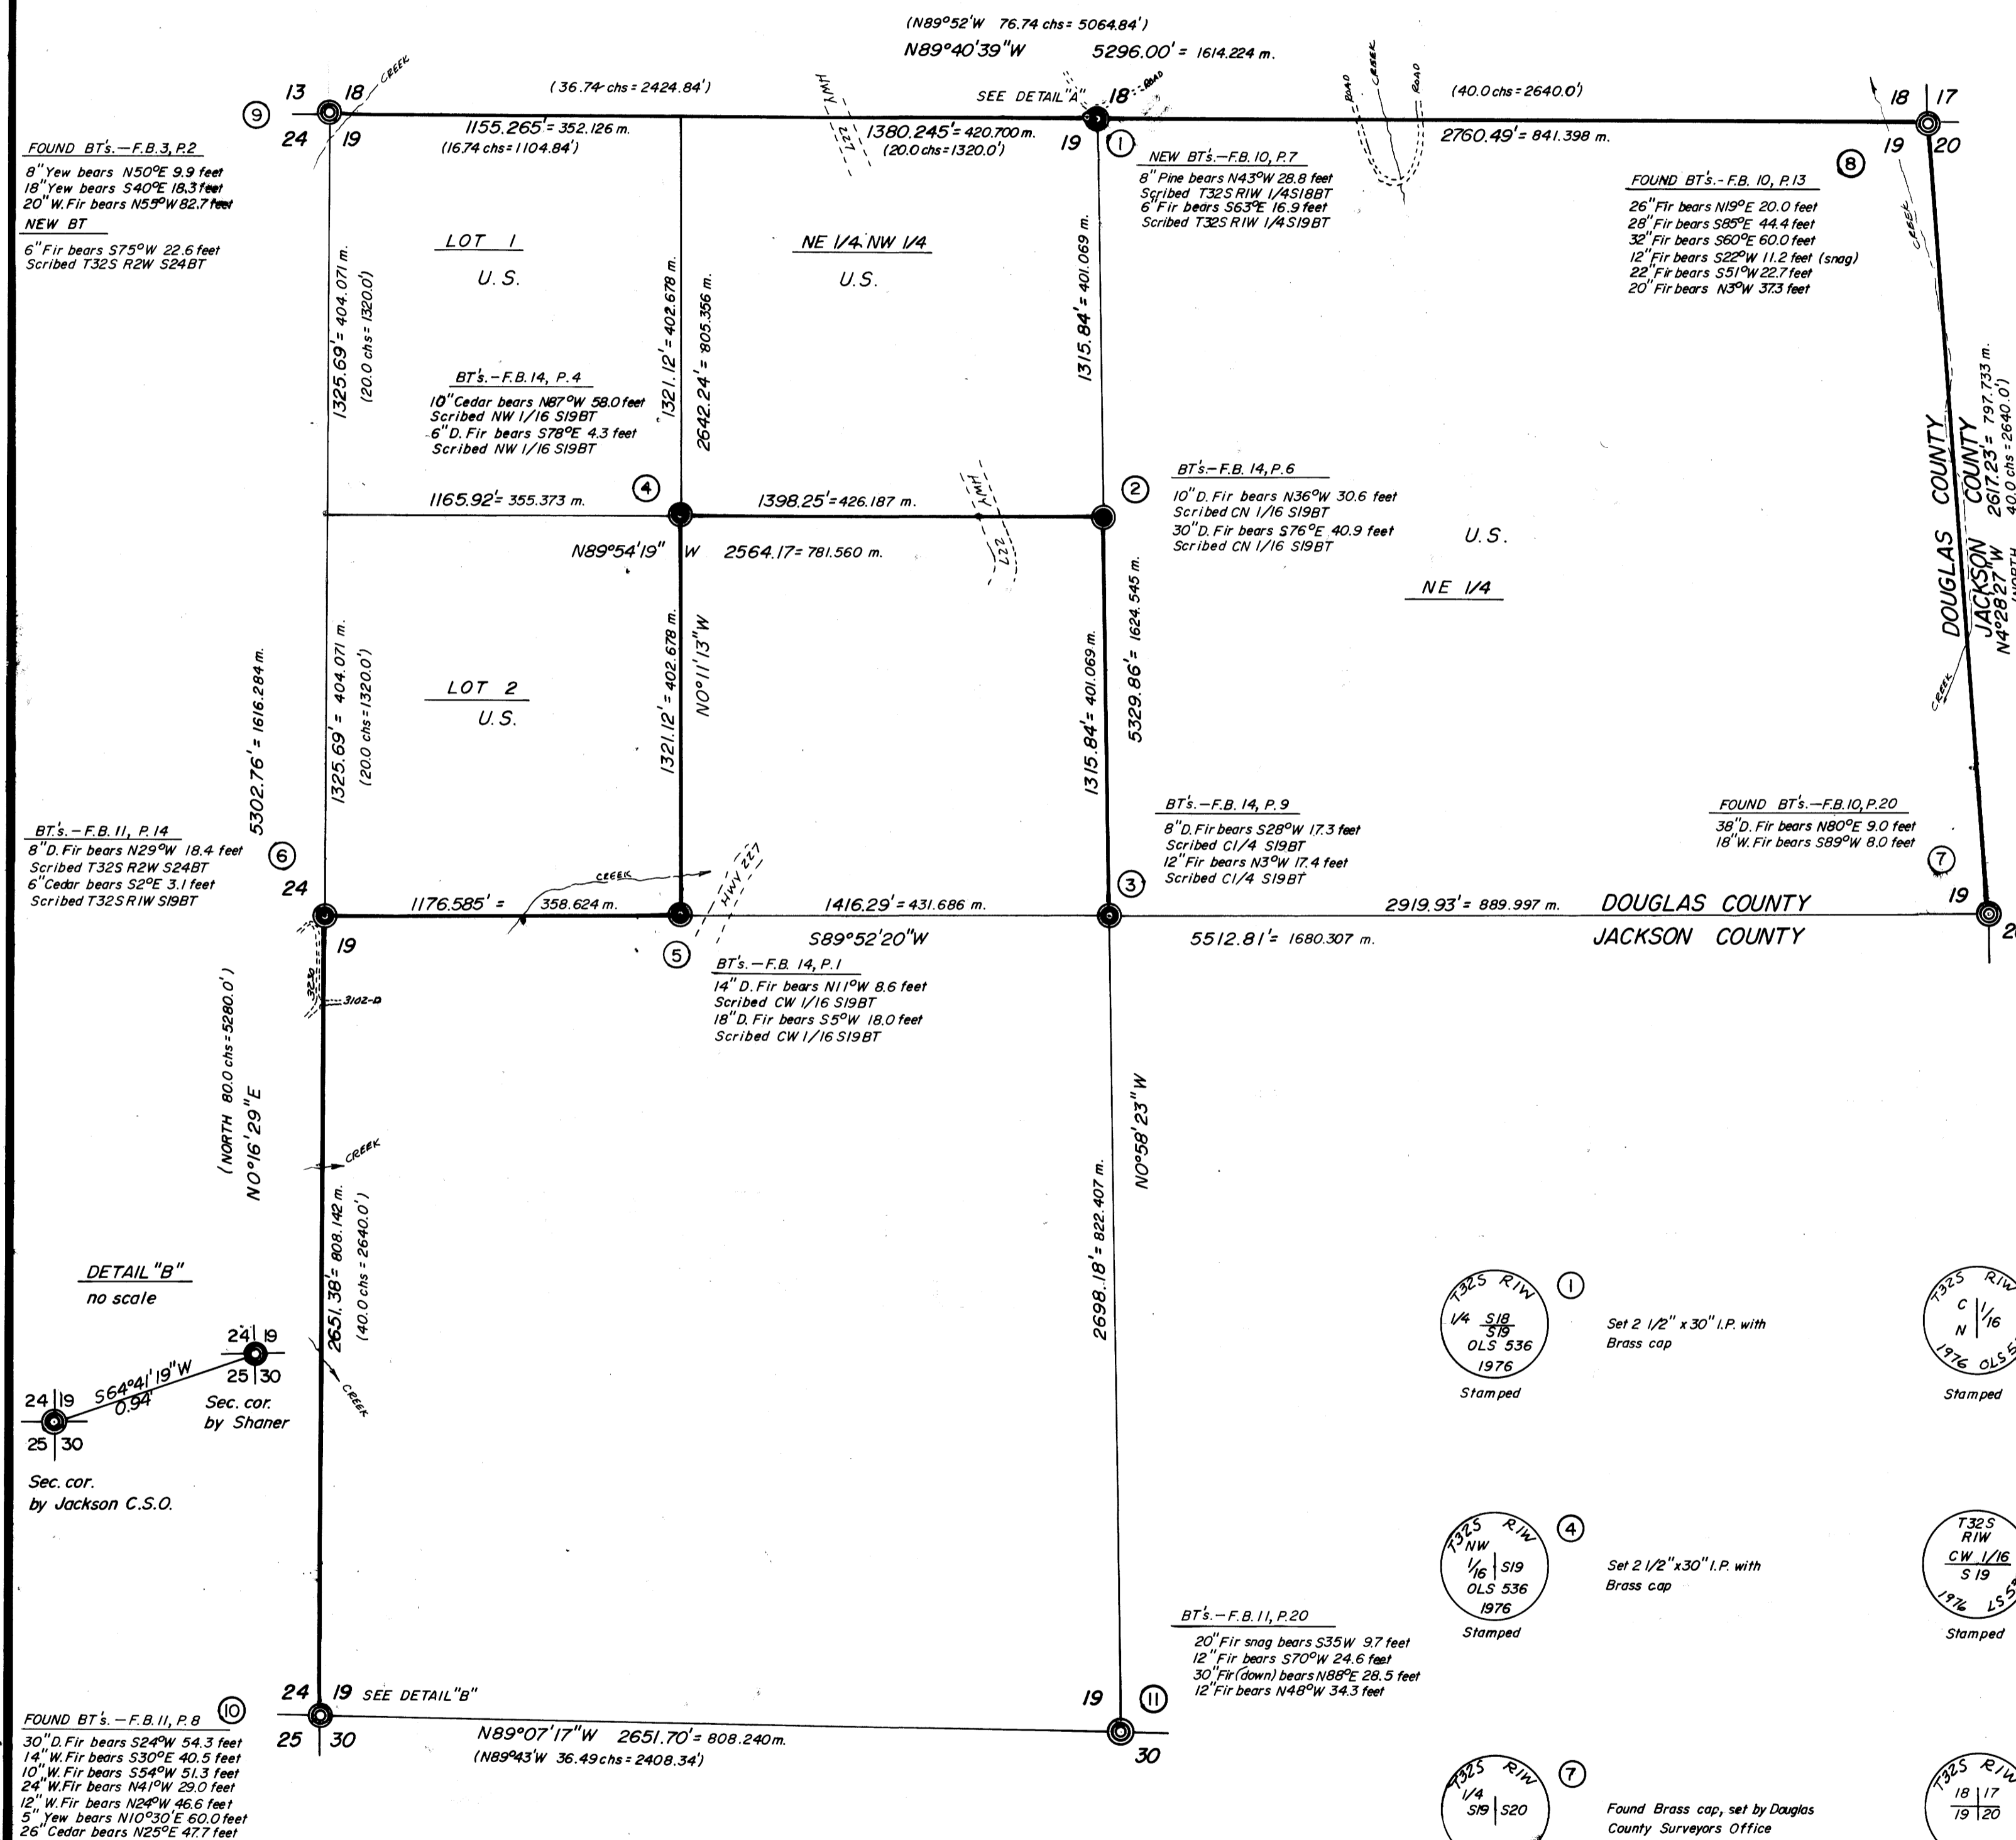


"I, GLENN S. BAUGHMAN, a registered professional land surveyor in the State of Oregon, hereby certify that this plot and the notes hereon, or attached, are a correct representation of a survey I performed during July-December 1976, for the U.S. Forest Service, in accordance with the statutes of the State of Oregon and with the Articles of my contract."



Glenn S. Baughman
GLENN S. BAUGHMAN
Registered Professional Land Surveyor
Oregon License 536



DETAIL "A"
no scale

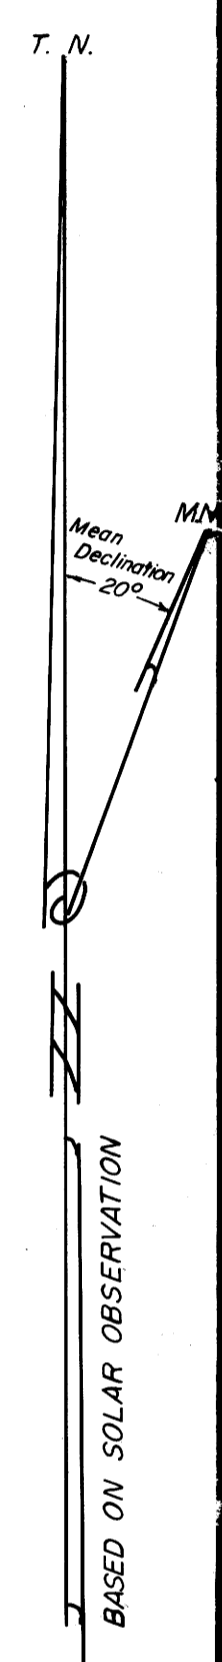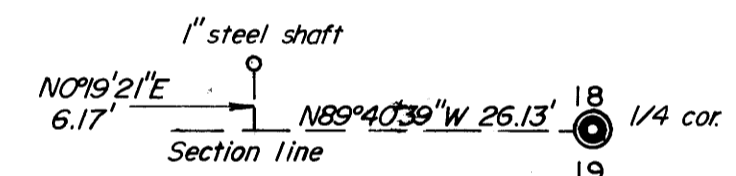

DETAIL "B"
no scale

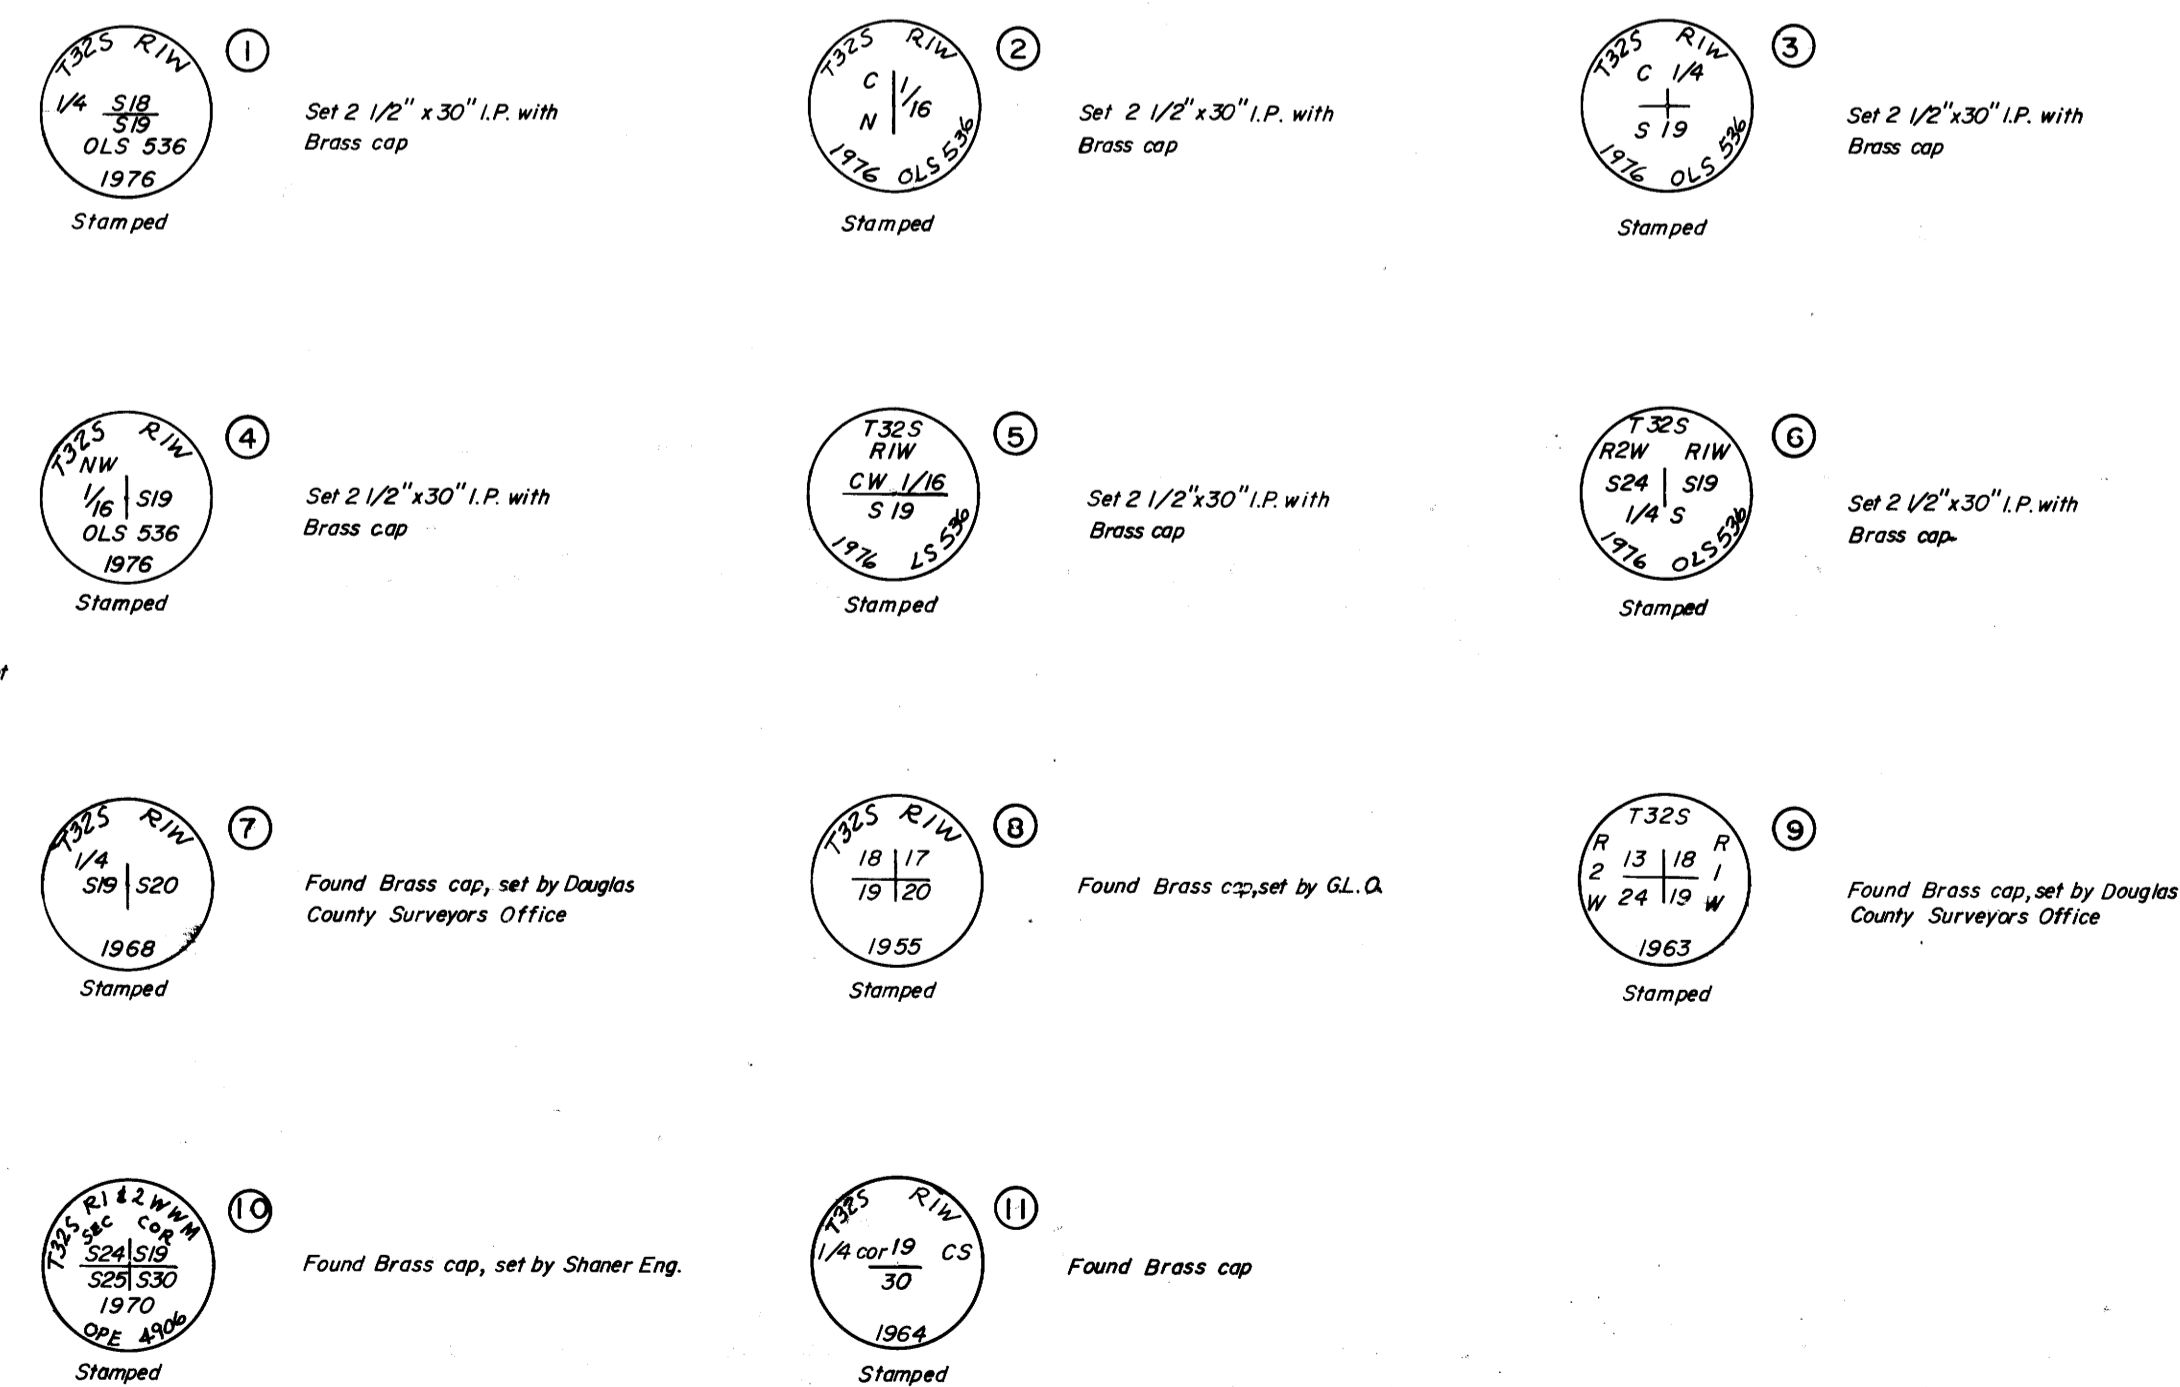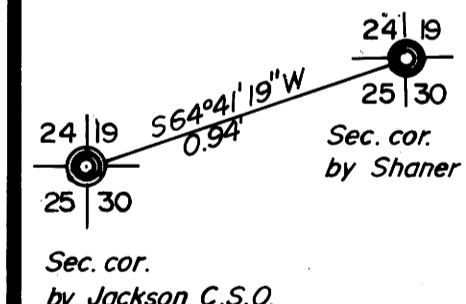

LEGEND

- Found Brass cap
- Set Brass cap
- Found 1" steel shaft
- () Record calls
- True lines posted with steel fence posts and government property signs