


FILED 7  
RECEIVED 77  
FEB 16 1977  
COUNTY SURVEYOR  
DOUGLAS COUNTY, ORE.  
7

# KLINE STREET EXTENSION & MOOREA DRIVE

LOCATED IN SECTIONS 2 & 11, T27S, R6 W, W.M.  
ENGINEERED FOR CASEY MORGAN  
BY BHVY ENGINEERING & SURVEYING, INC.

REGISTERED  
PROFESSIONAL  
LAND SURVEYOR  
*Romano E. Ware*  
OREGON  
ROMANO E. WARE  
1977

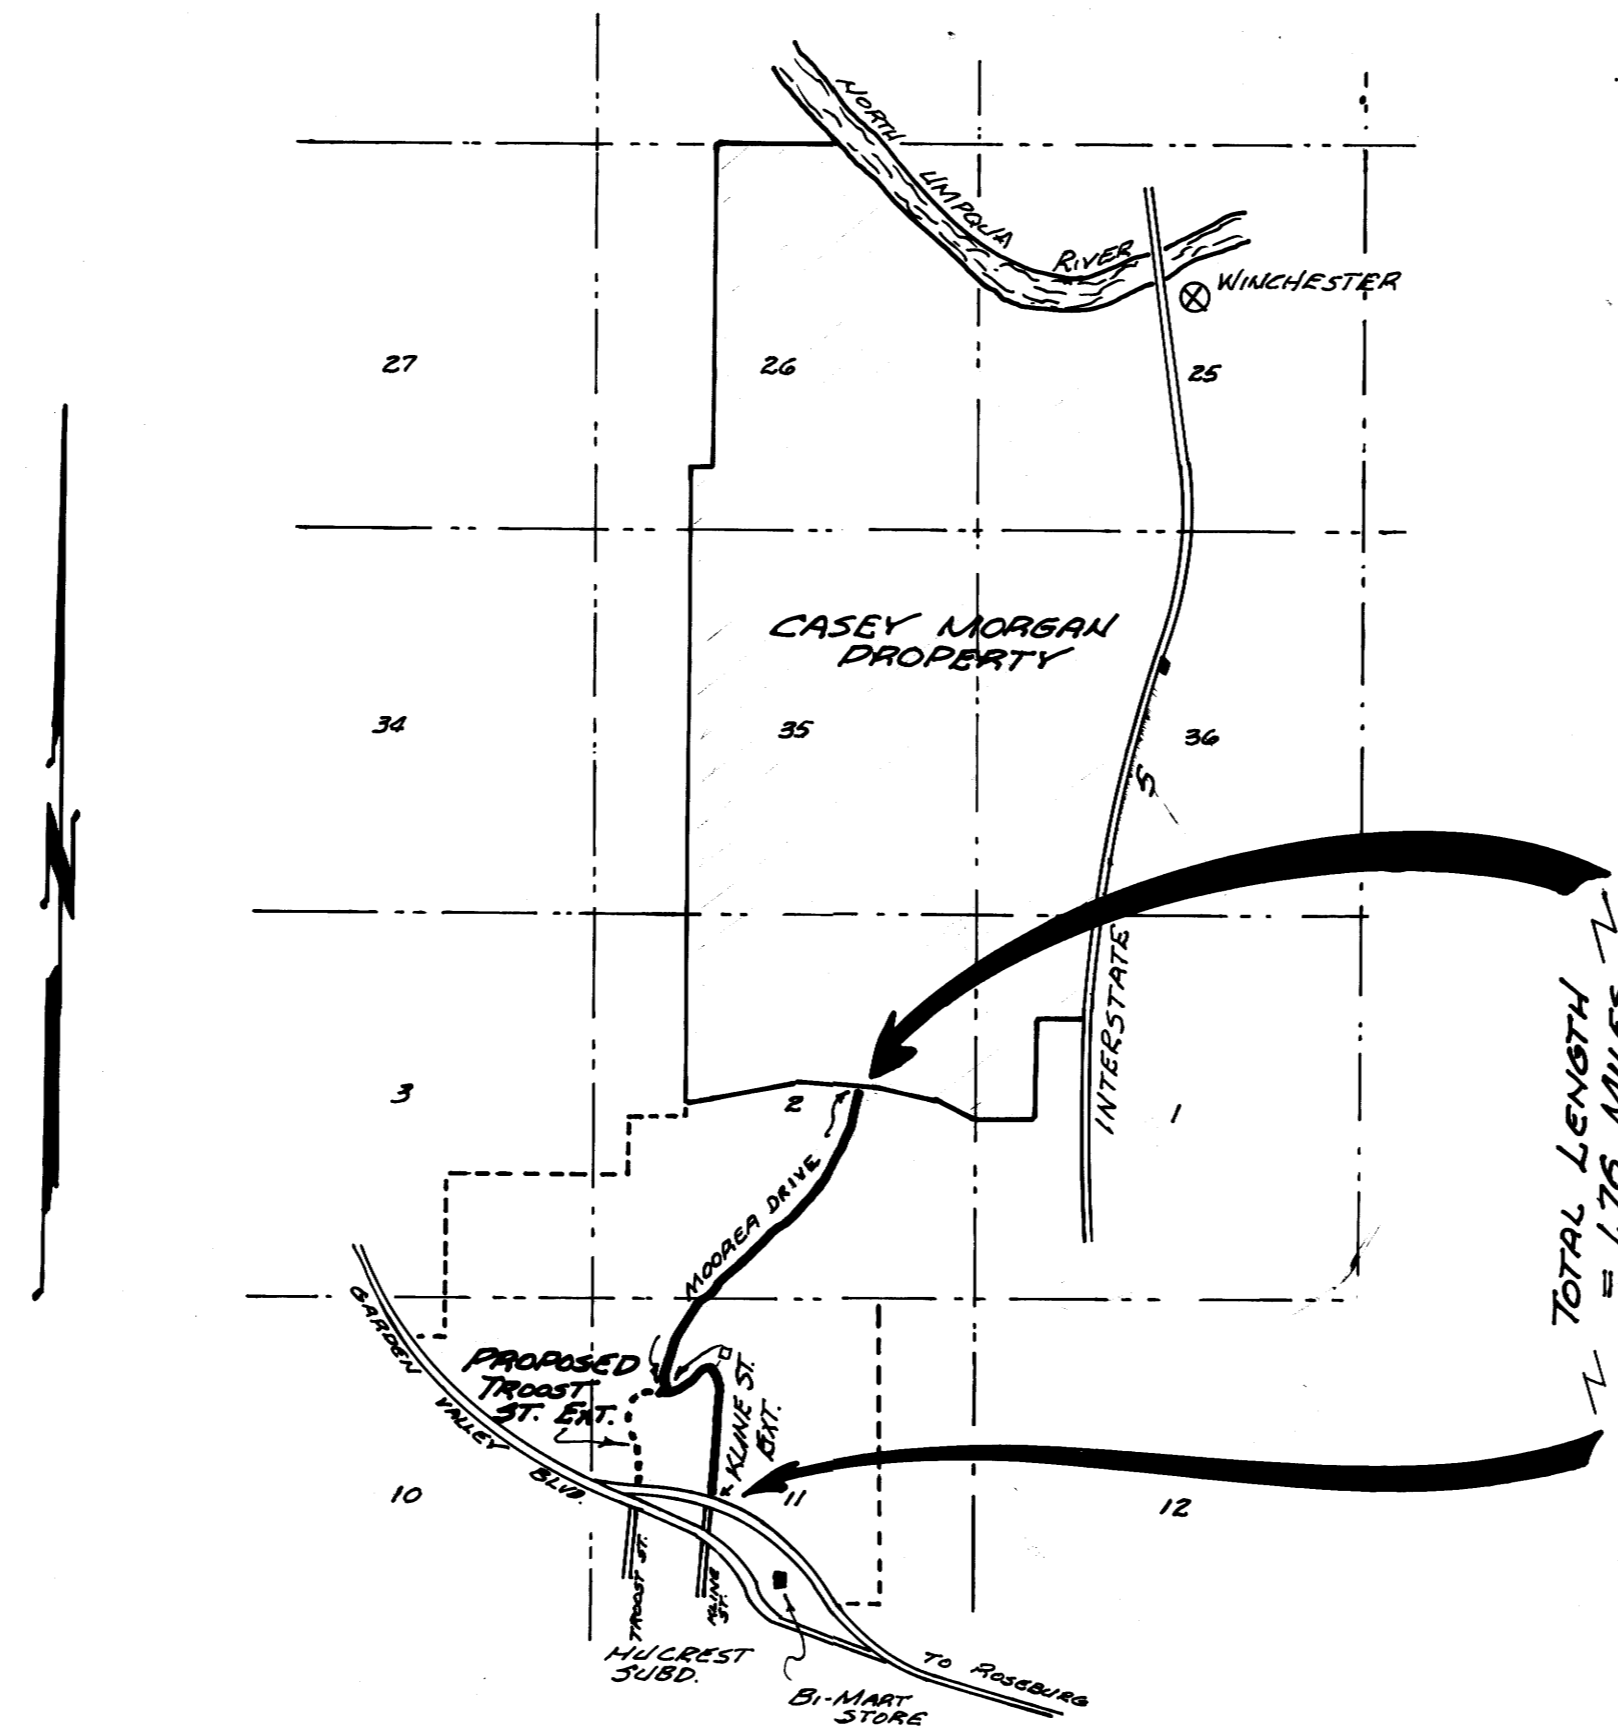

NOTE: ENGINEERING BY R. HENSON & D. SCROSSIN'S  
SURVEYING & MONUMENTATION BY R. WARE &  
COMPLETED JAN., 1977.

- — DESIGNATES SET 5/8" I. ROD
- — DESIGNATES FD. MONUMENT

BEARINGS BASED ON EDENBORNE-MILLWOOD COUNTY  
ROAD No. 6.

END OF PROJECT  
STA. "L" 102+57.31

BEGINNING OF PROJECT  
STA. "L" 9+41.33

VICINITY MAP  
SCALE: 1" = 1/2 MILE



COUNTY SURVEYORS FILE NO. 1153-25A  
DO NOT REMOVE FROM OFFICE



COUNTY SURVEYORS FILE DATA  
DO NOT REMOVE FROM OFFICE

FILED ✓  
RECEIVED 1977  
FEB 16 1977  
COUNTY SURVEYOR  
DOUGLAS COUNTY, ORE.  
✓

DATE	
BY	
REVISIONS	
NO.	DESCRIPTION
1	AS SHOWN
2	AS SHOWN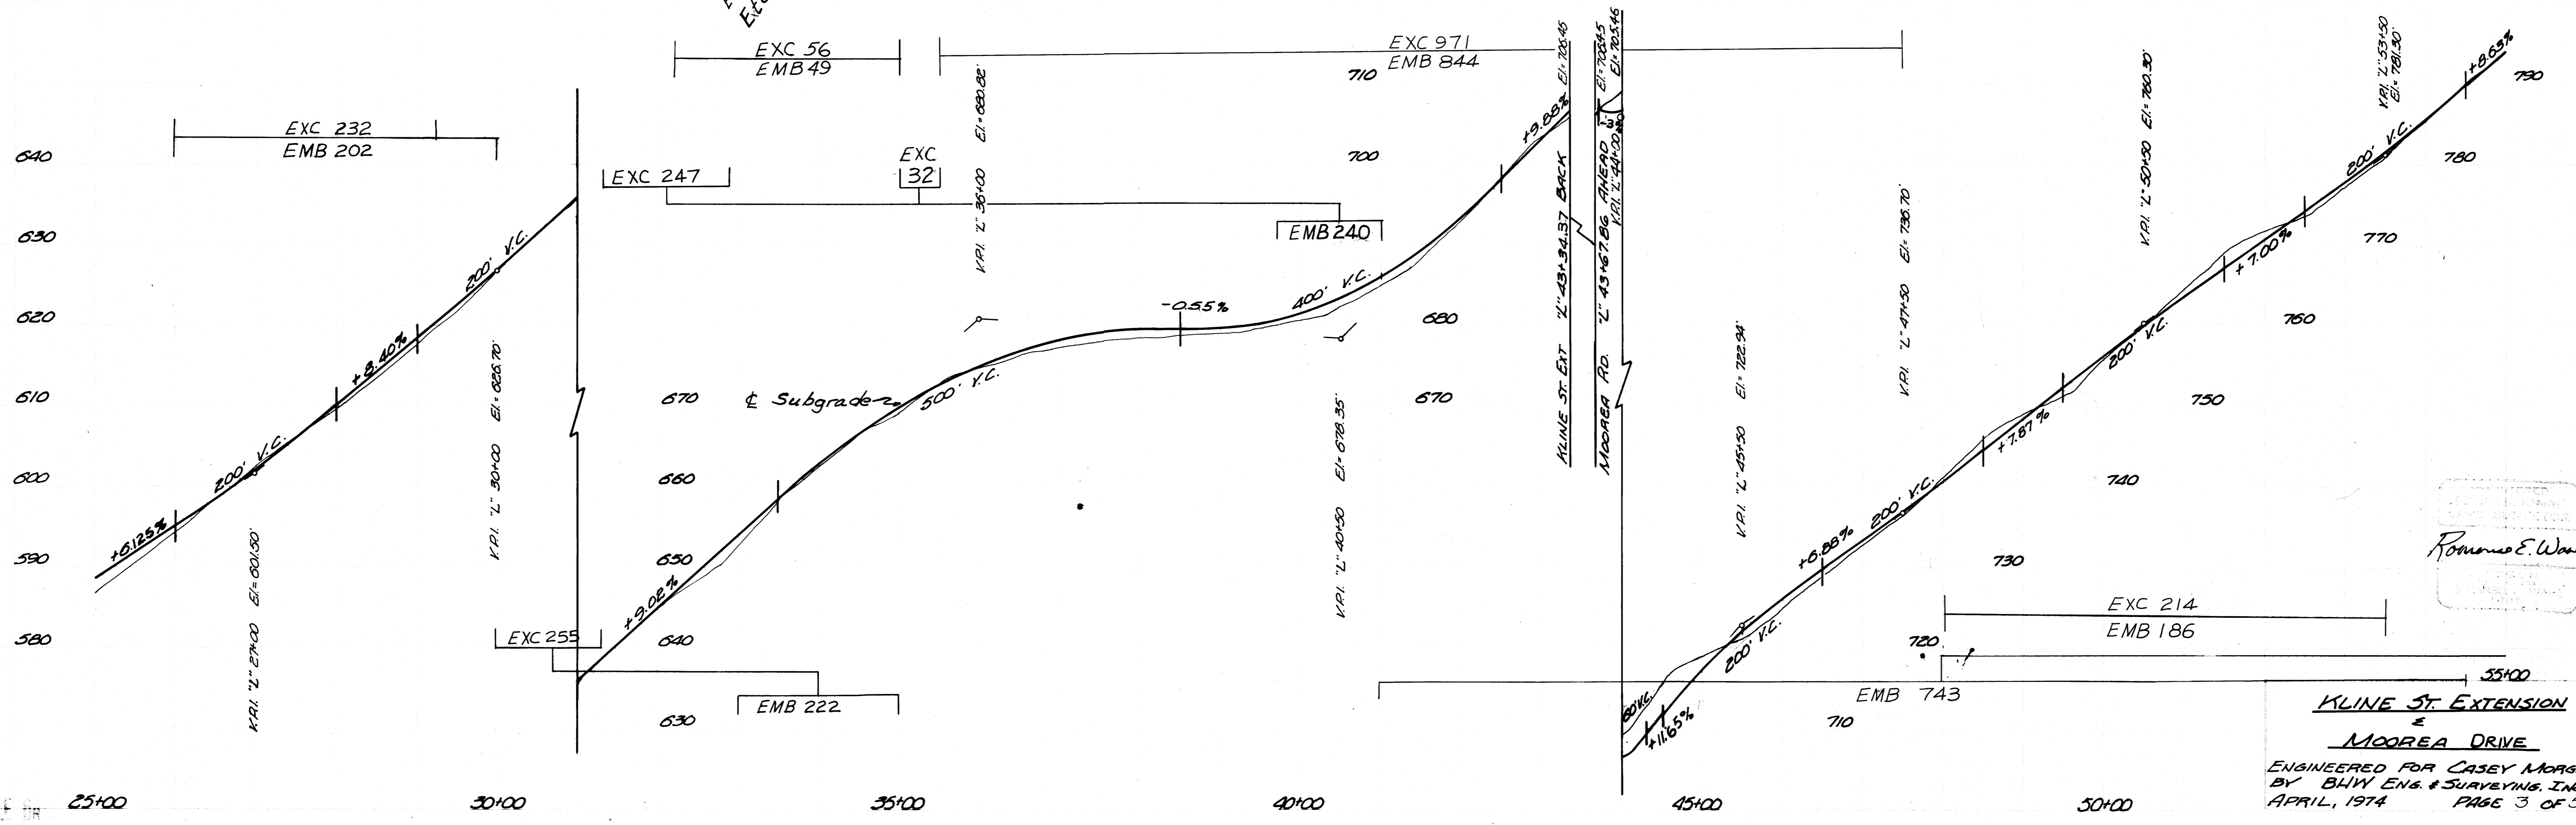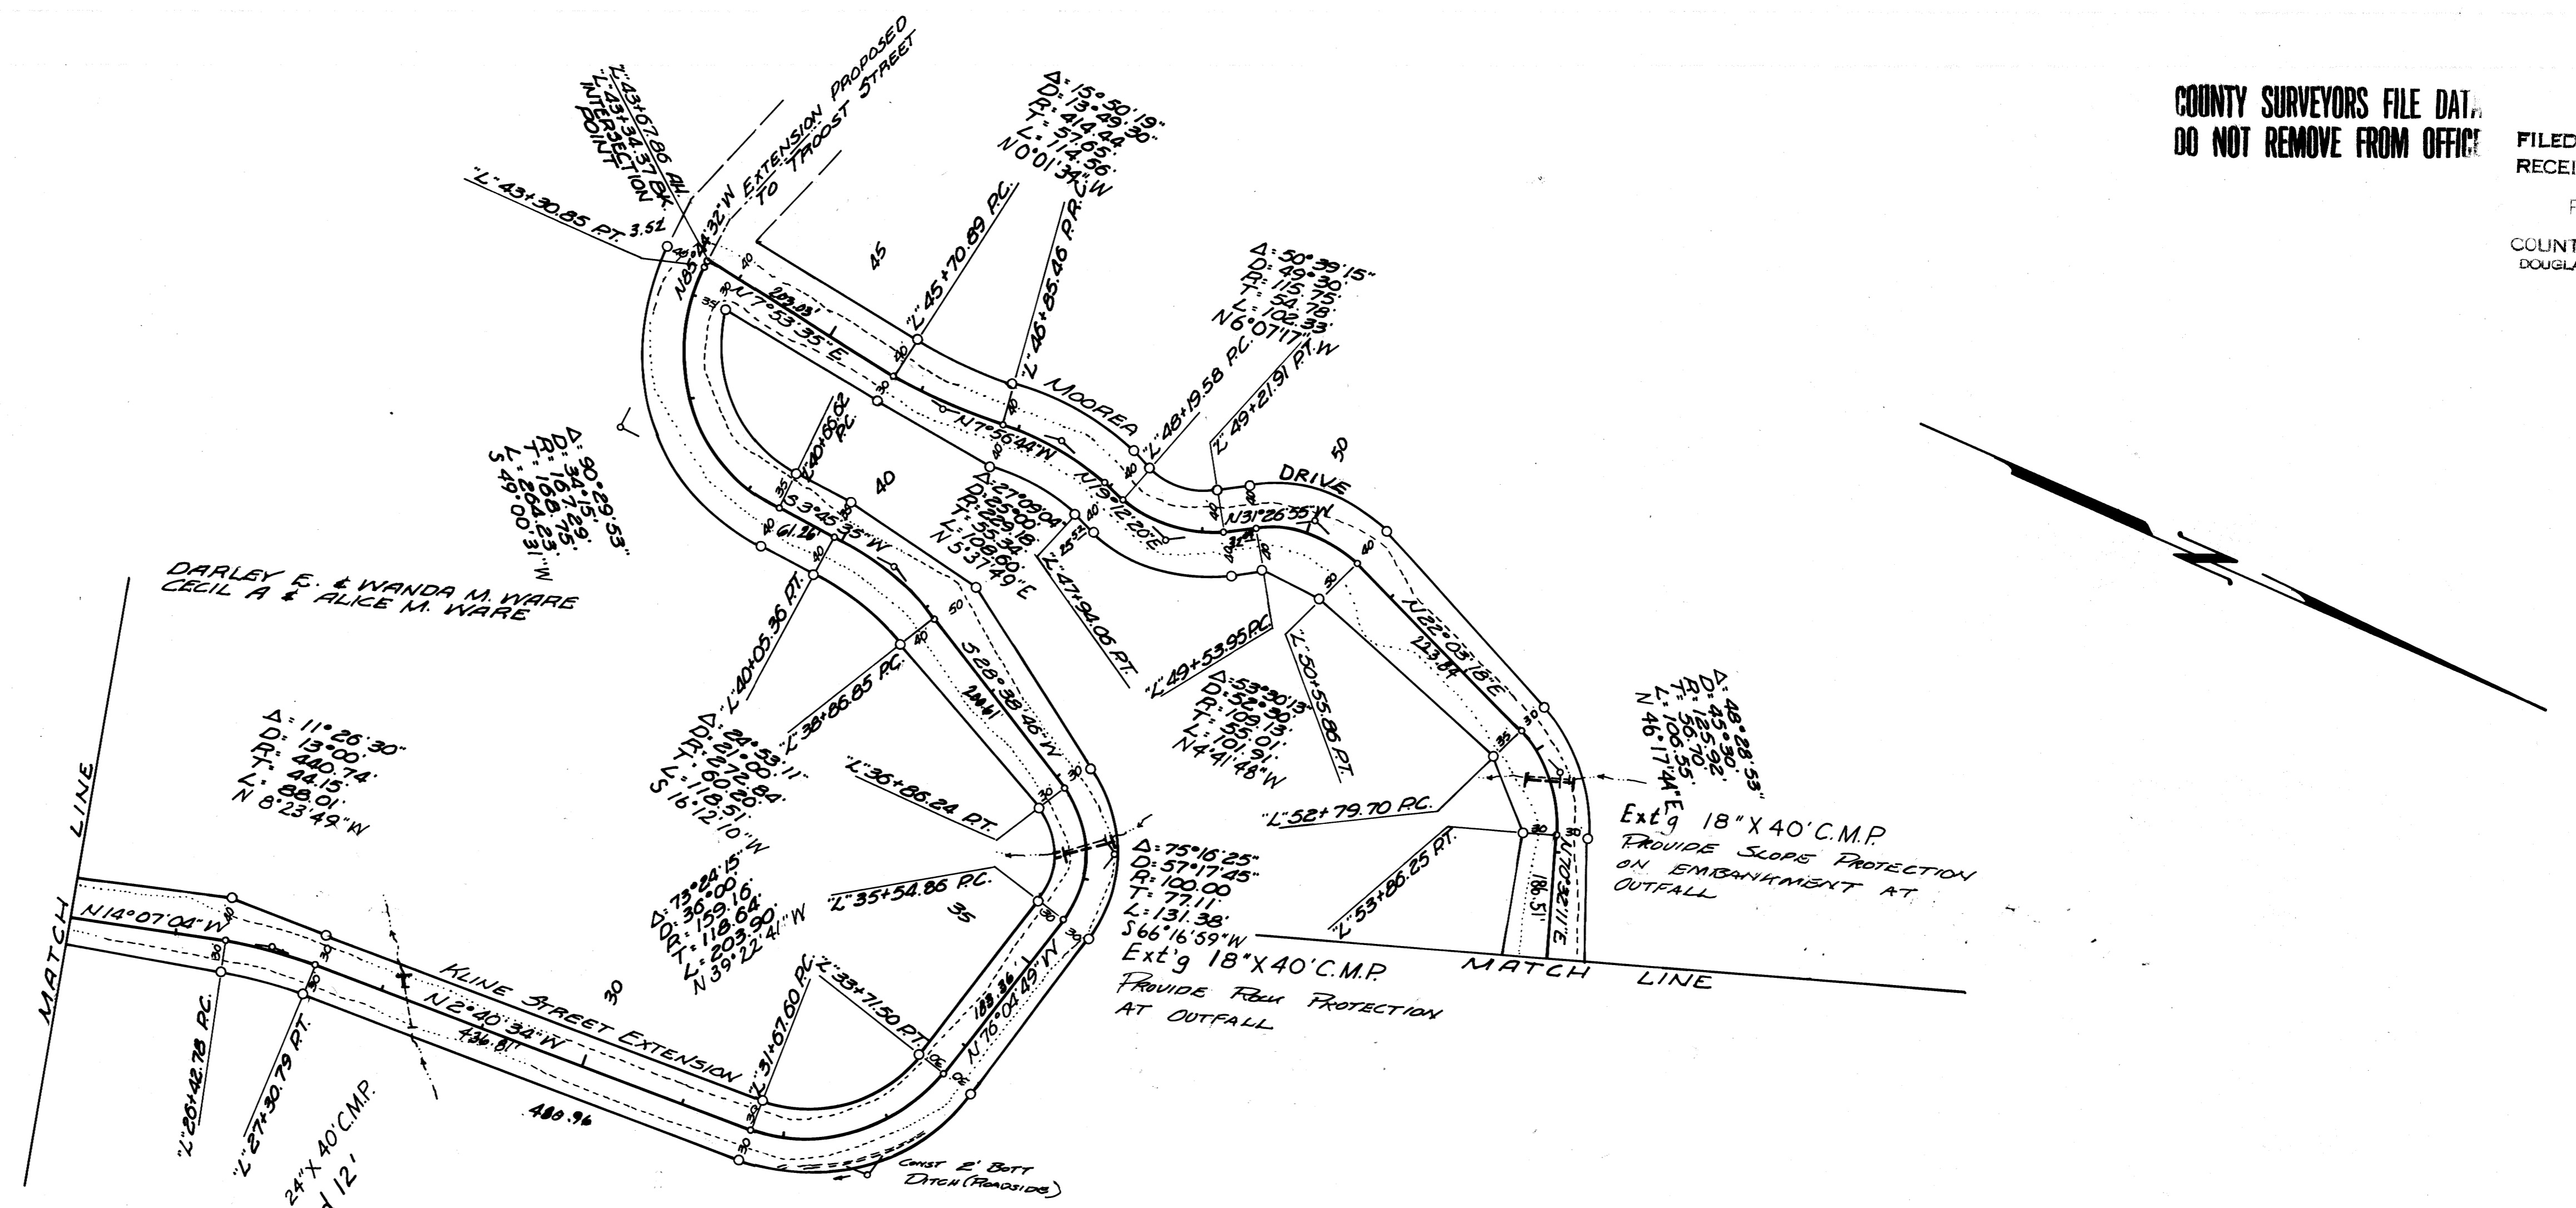
**KLINE ST. EXTENSION  
&  
MOOREA DRIVE**  
ENGINEERED FOR CASEY MORGAN  
BY BHW ENG. & SURVEYING, INC.  
APRIL, 1974 PAGE 3 OF 5

Romanus E. Ware

COUNTY SURVEYORS FILE DATA  
DO NOT REMOVE FROM OFFICE

FILED  
RECEIVED 1/8  
FEB 16 1974  
COUNTY SURVEYOR  
DOUGLAS COUNTY, ORE

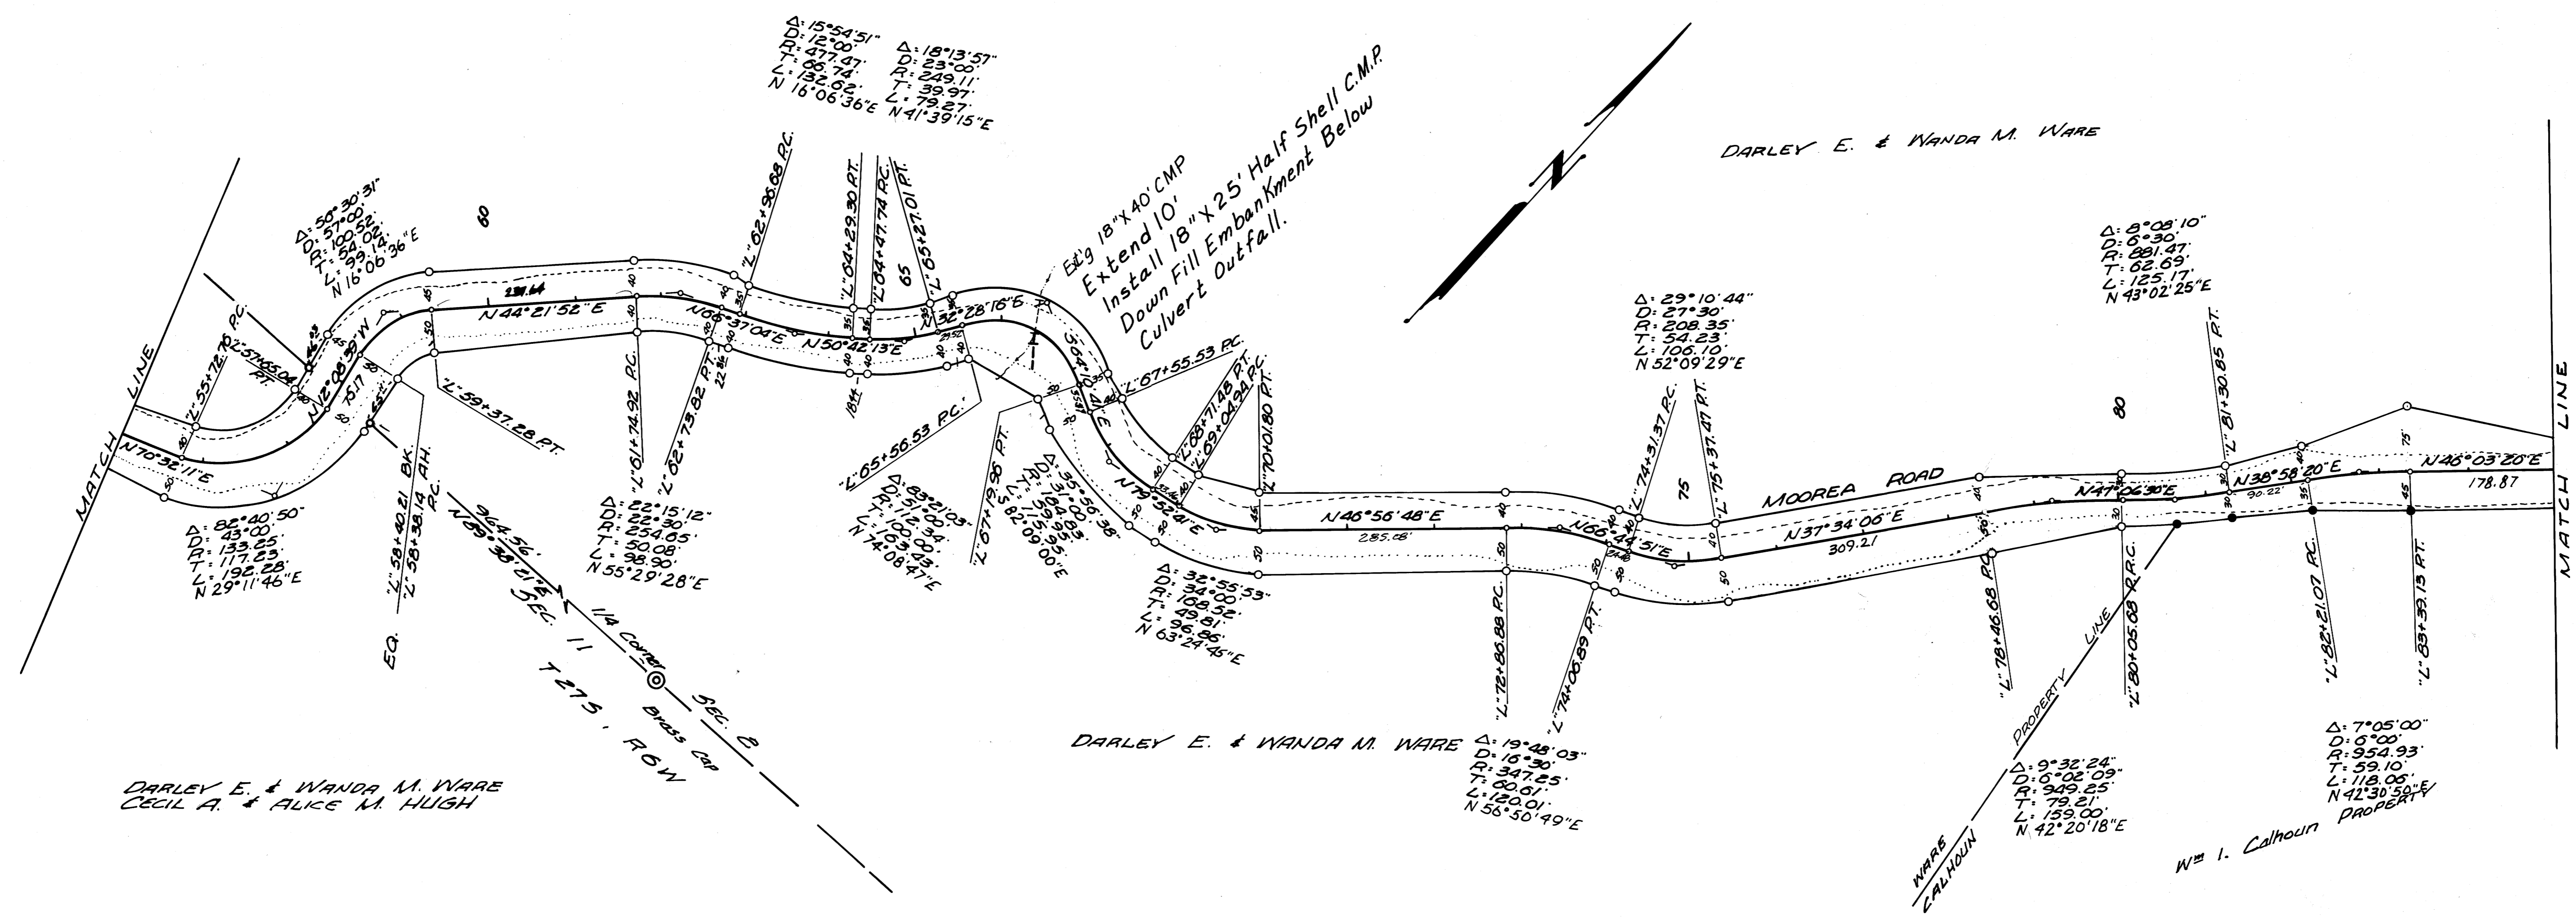


PLAN  
SURVEYOR  
REGISTERED  
PROFESSIONAL  
LAND SURVEYOR  
ROMANSO E. WARE  
10-13-73

DARLEY E. & WANDA M. WARE  
CECIL A. & ALICE M. HUGH

DARLEY E. & WANDA M. WARE

Wm I. Calhoun PROPERTY

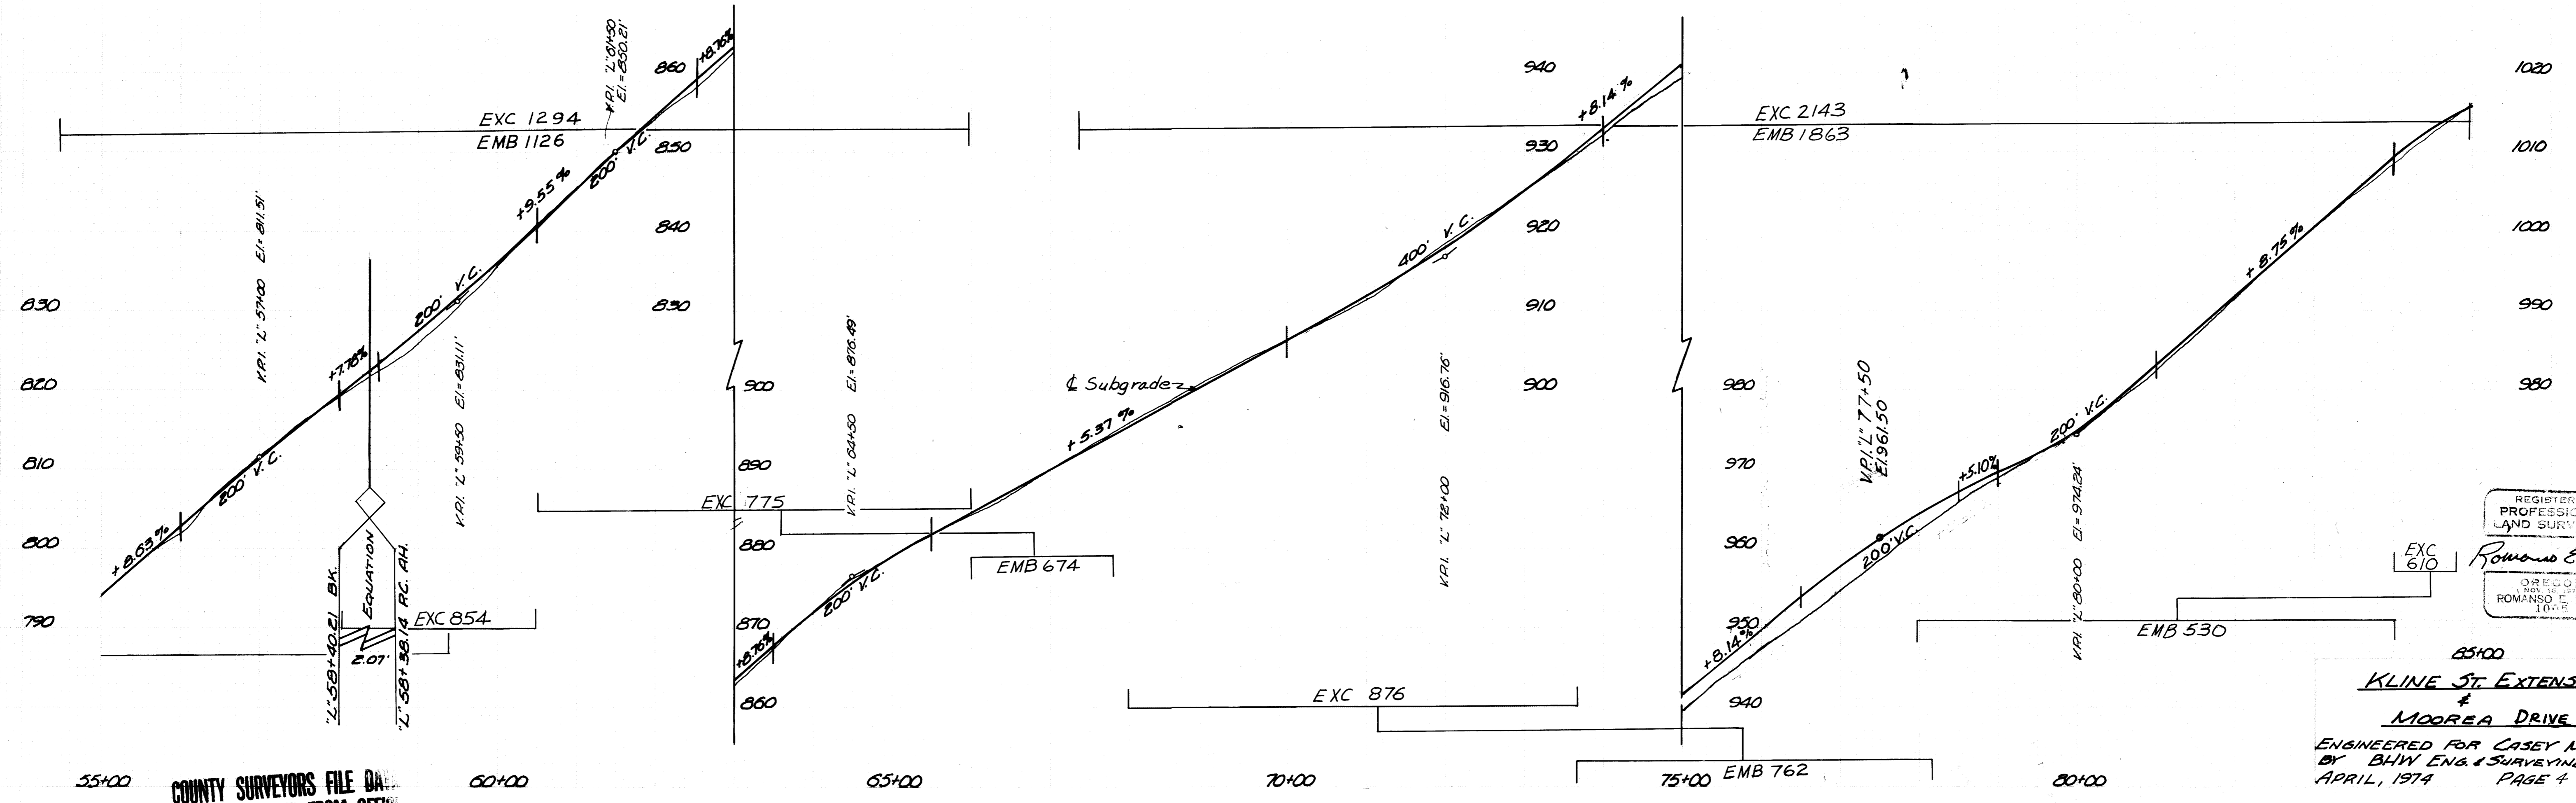


PROFILE  
SURVEYOR  
REGISTERED  
PROFESSIONAL  
LAND SURVEYOR  
ROMANSO E. WARE  
10-13-73

COUNTY SURVEYORS FILE DATA  
DO NOT REMOVE FROM OFFICE


REGISTERED  
PROFESSIONAL  
LAND SURVEYOR  
ROMANSO E. WARE  
10-13-73  
KLINE ST. EXTENSION  
&  
MOOREA DRIVE  
ENGINEERED FOR CASEY MORGAN  
BY BHW ENG. & SURVEYING, INC.  
APRIL, 1974 PAGE 4 OF 5

COUNTY SURVEYORS FILE DAY  
DO NOT REMOVE FROM OFFICE  
FILED ✓  
RECEIVED 24  
FEB 16 1977  
COUNTY SURVEYOR  
DOUGLAS COUNTY, ORE.  
1

PLAN	SURVEYED	DATE
	ADJUSTED	
	NOTED	
	BY	
	DATE	

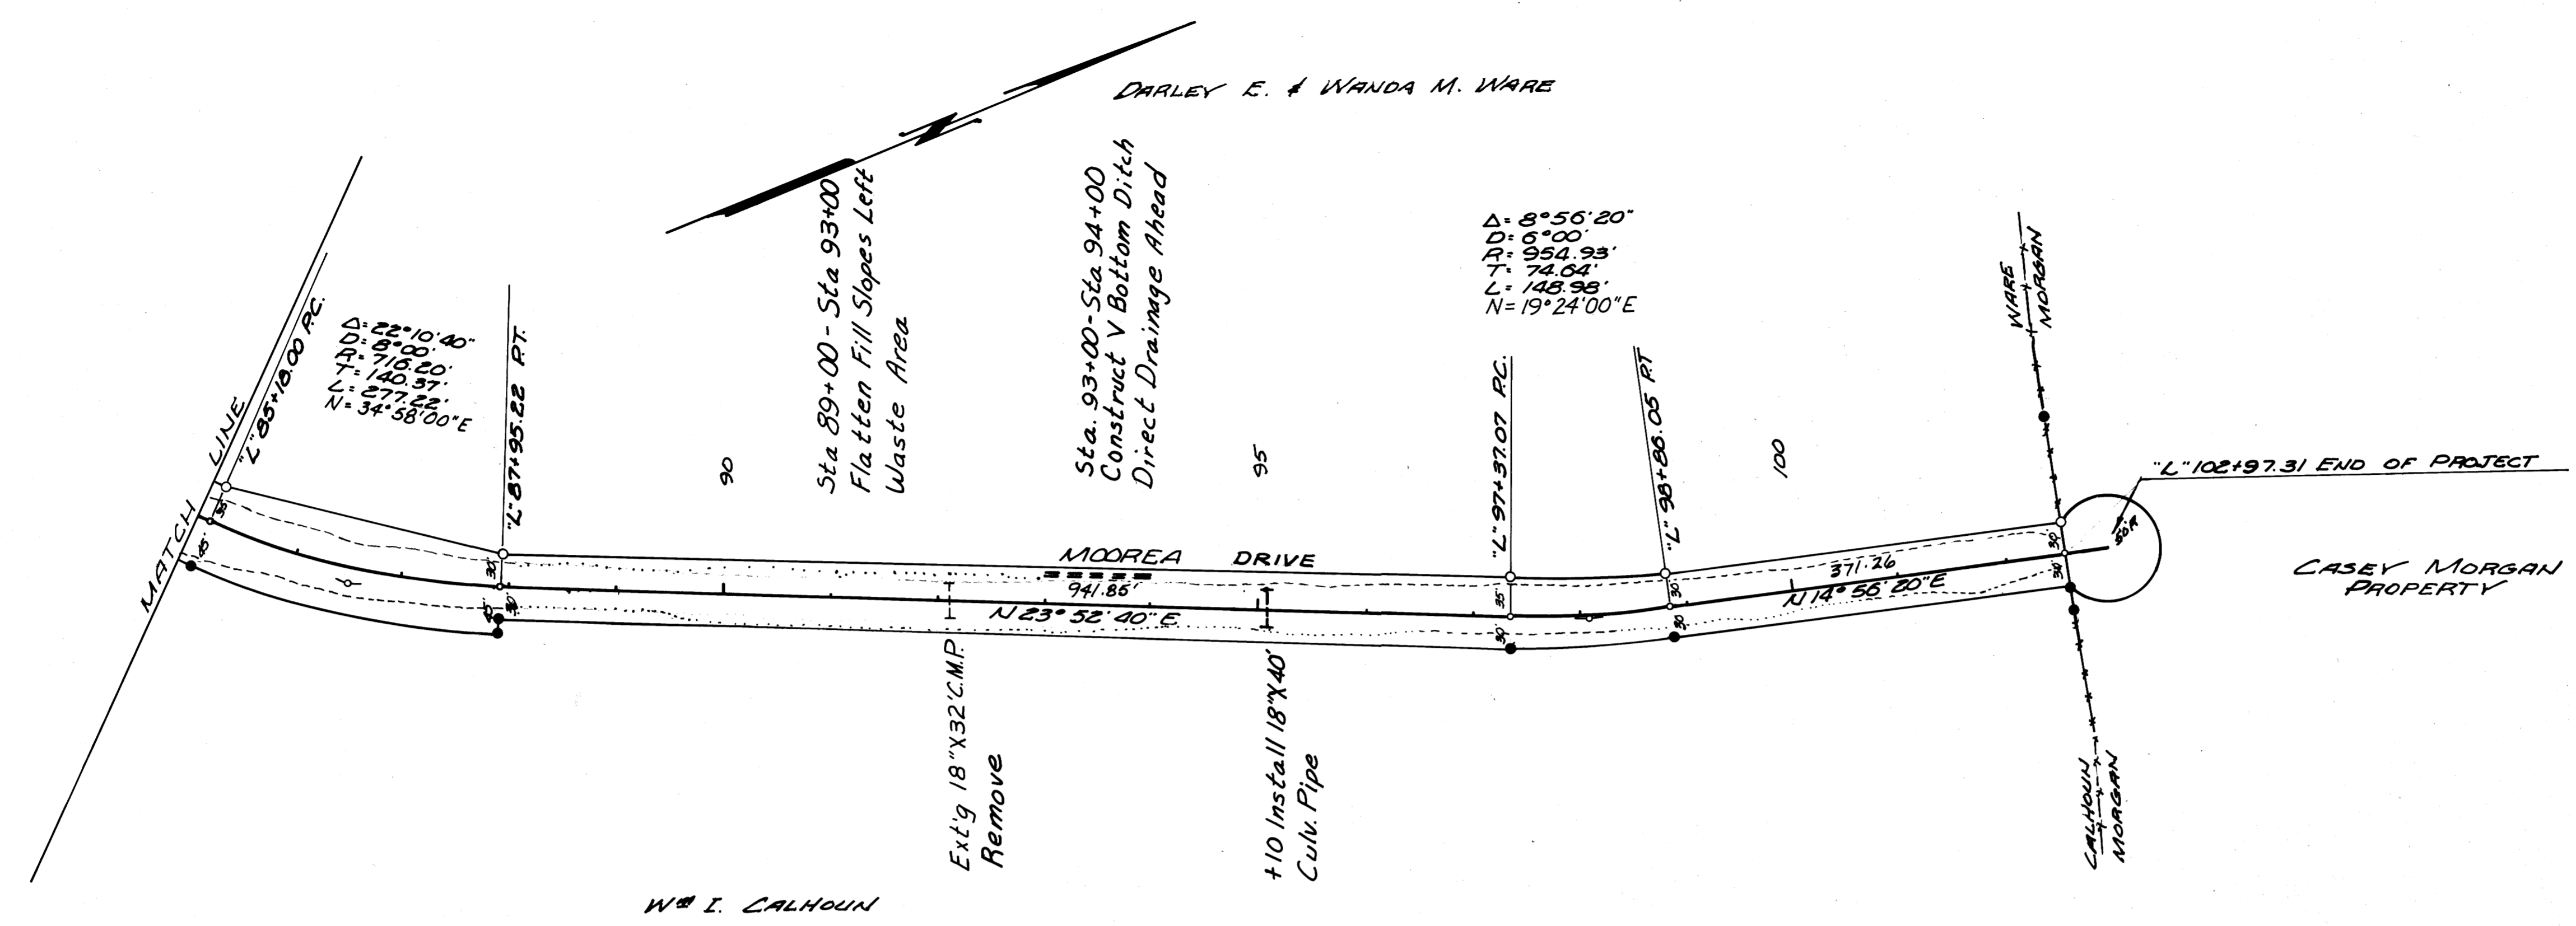

PROFILE	SURVEYED	DATE
	ADJUSTED	
	NOTED	
	BY	
	DATE	

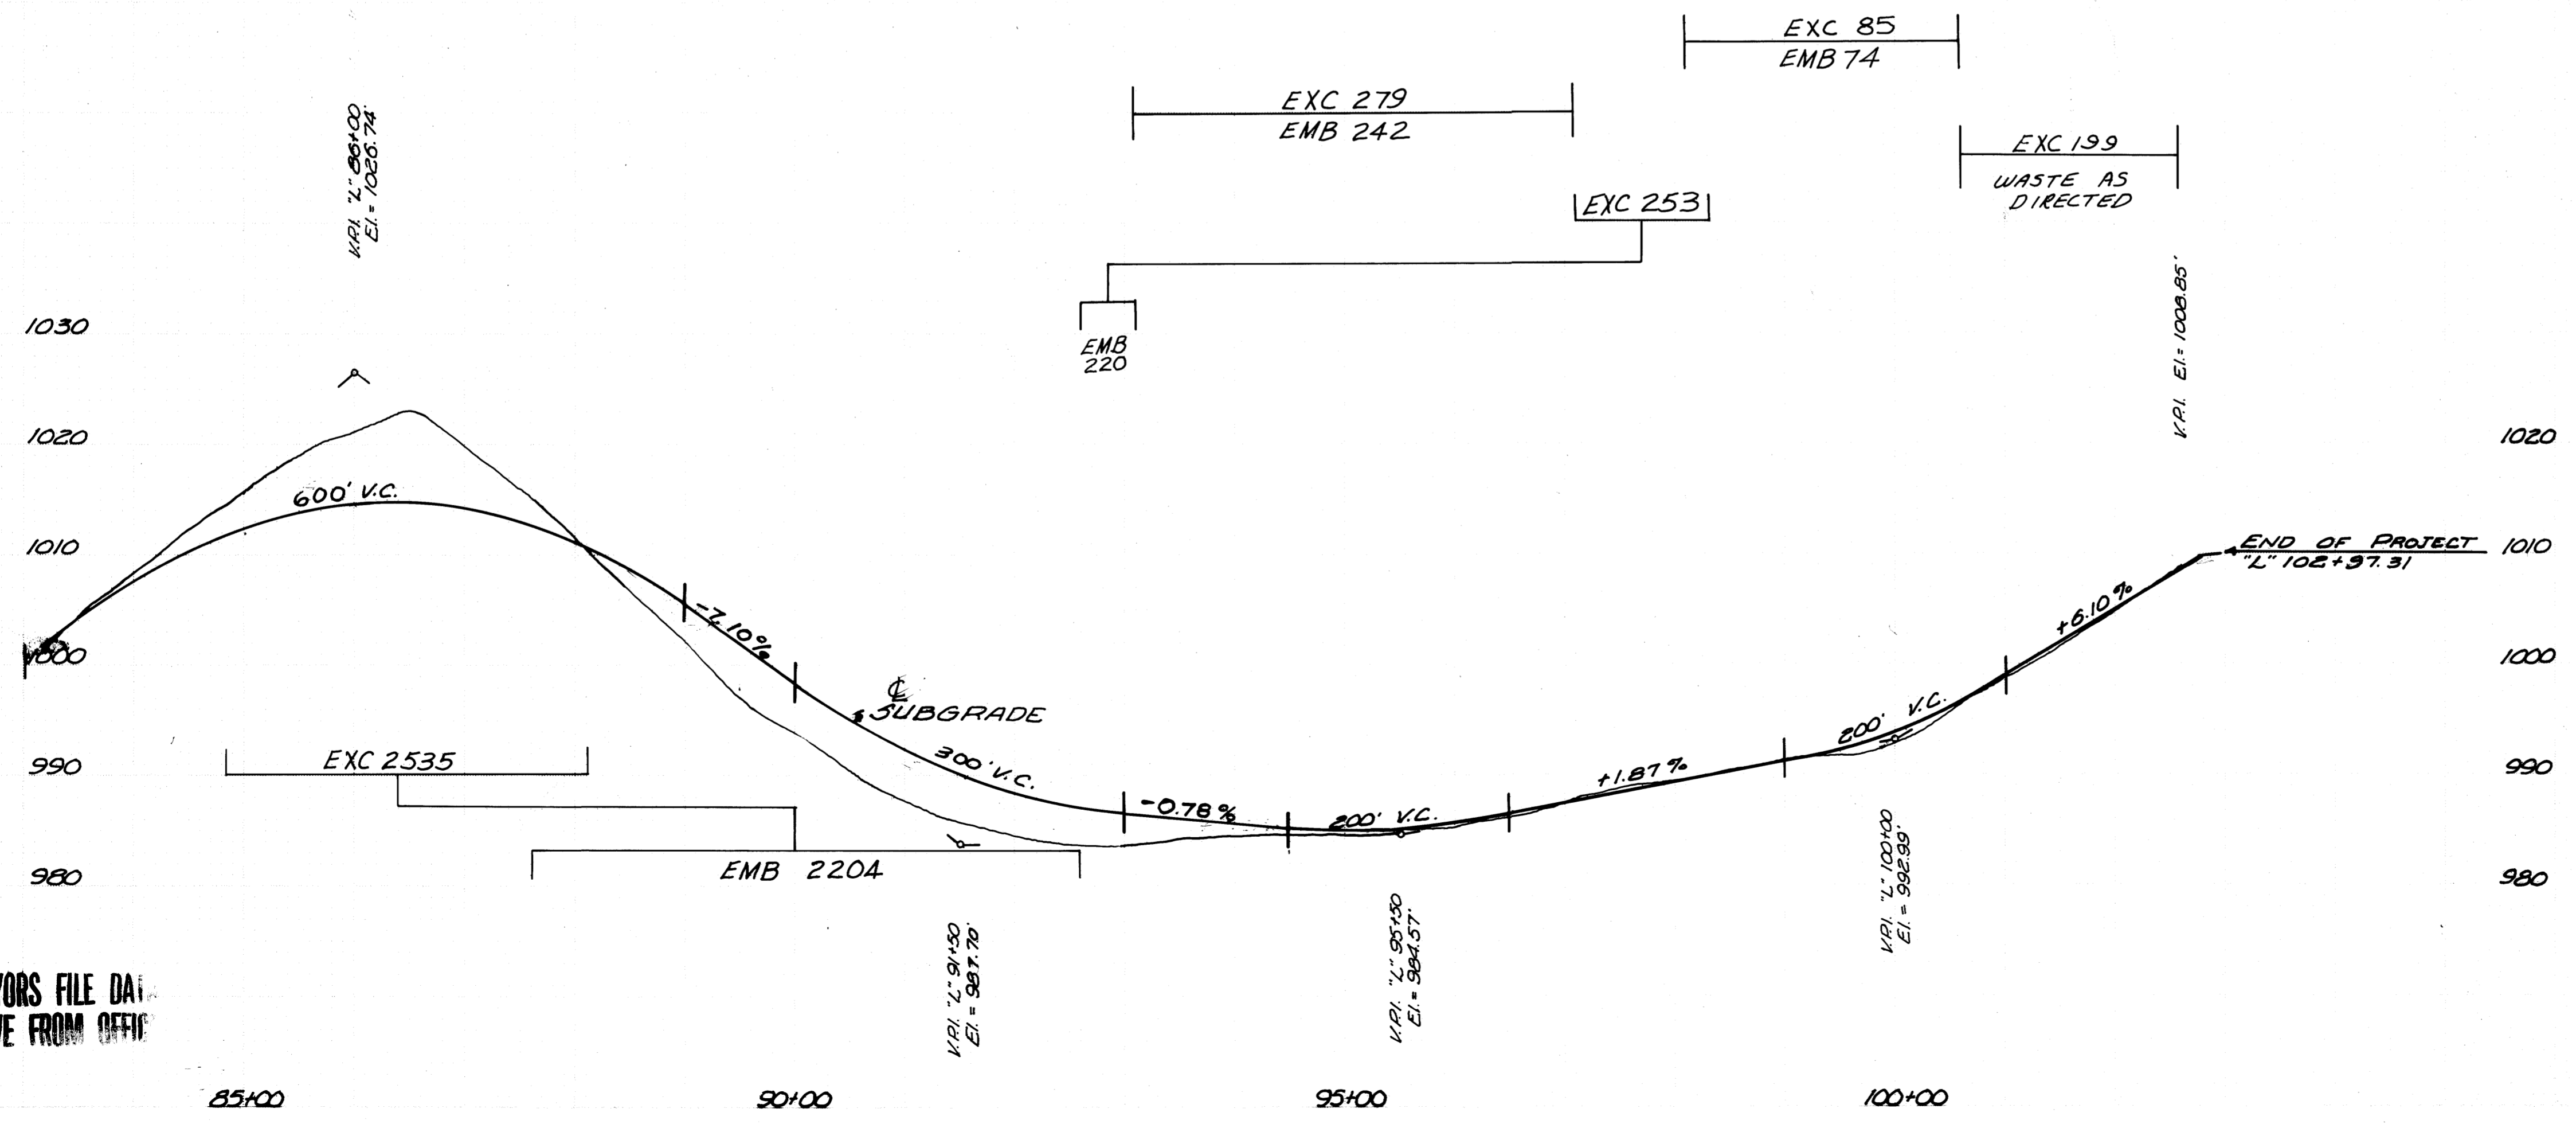

COUNTY SURVEYORS FILE DAY  
DO NOT REMOVE FROM OFFICE

REGISTERED  
PROFESSIONAL  
LAND SURVEYOR  
*Romano E. Ware*  
OREGON  
ROMANEO E. WARE  
1965

**KLINE ST. EXTENSION**  
**MOOREA DRIVE**  
ENGINEERED FOR CASEY MORGAN  
BY BHW ENG & SURVEYING, INC.  
APRIL, 1974 PAGE 5 OF 5