

FILED 2
RECEIVED

MAY 6 1975

COUNTY SURVEYOR
DEER CREEK MEADOWS

Survey to Set Lot Corners

Lots 1, 2, & 3, Block 3

Deer Creek Meadows

Section 20, T27S, R5W, W.M.

Survey for:

Survey by:

Robert Barry

B.H.W. Eng. & Surveying, Inc.

May 1975

Scale 1" = 30'


○ — Set 3/4" Iron pipe

COUNTY SURVEYORS FILE DATA
DO NOT REMOVE FROM OFFICE

Co. Rd. # 4 100' R/W

(REC S 89° 59' 30" E 160.0)

SLOPE EASEMENT FOR ROAD IMPROVEMENT
10' ACQUIRED FOR COUNTY RD. R/W REVISED 5/6/77 RAB

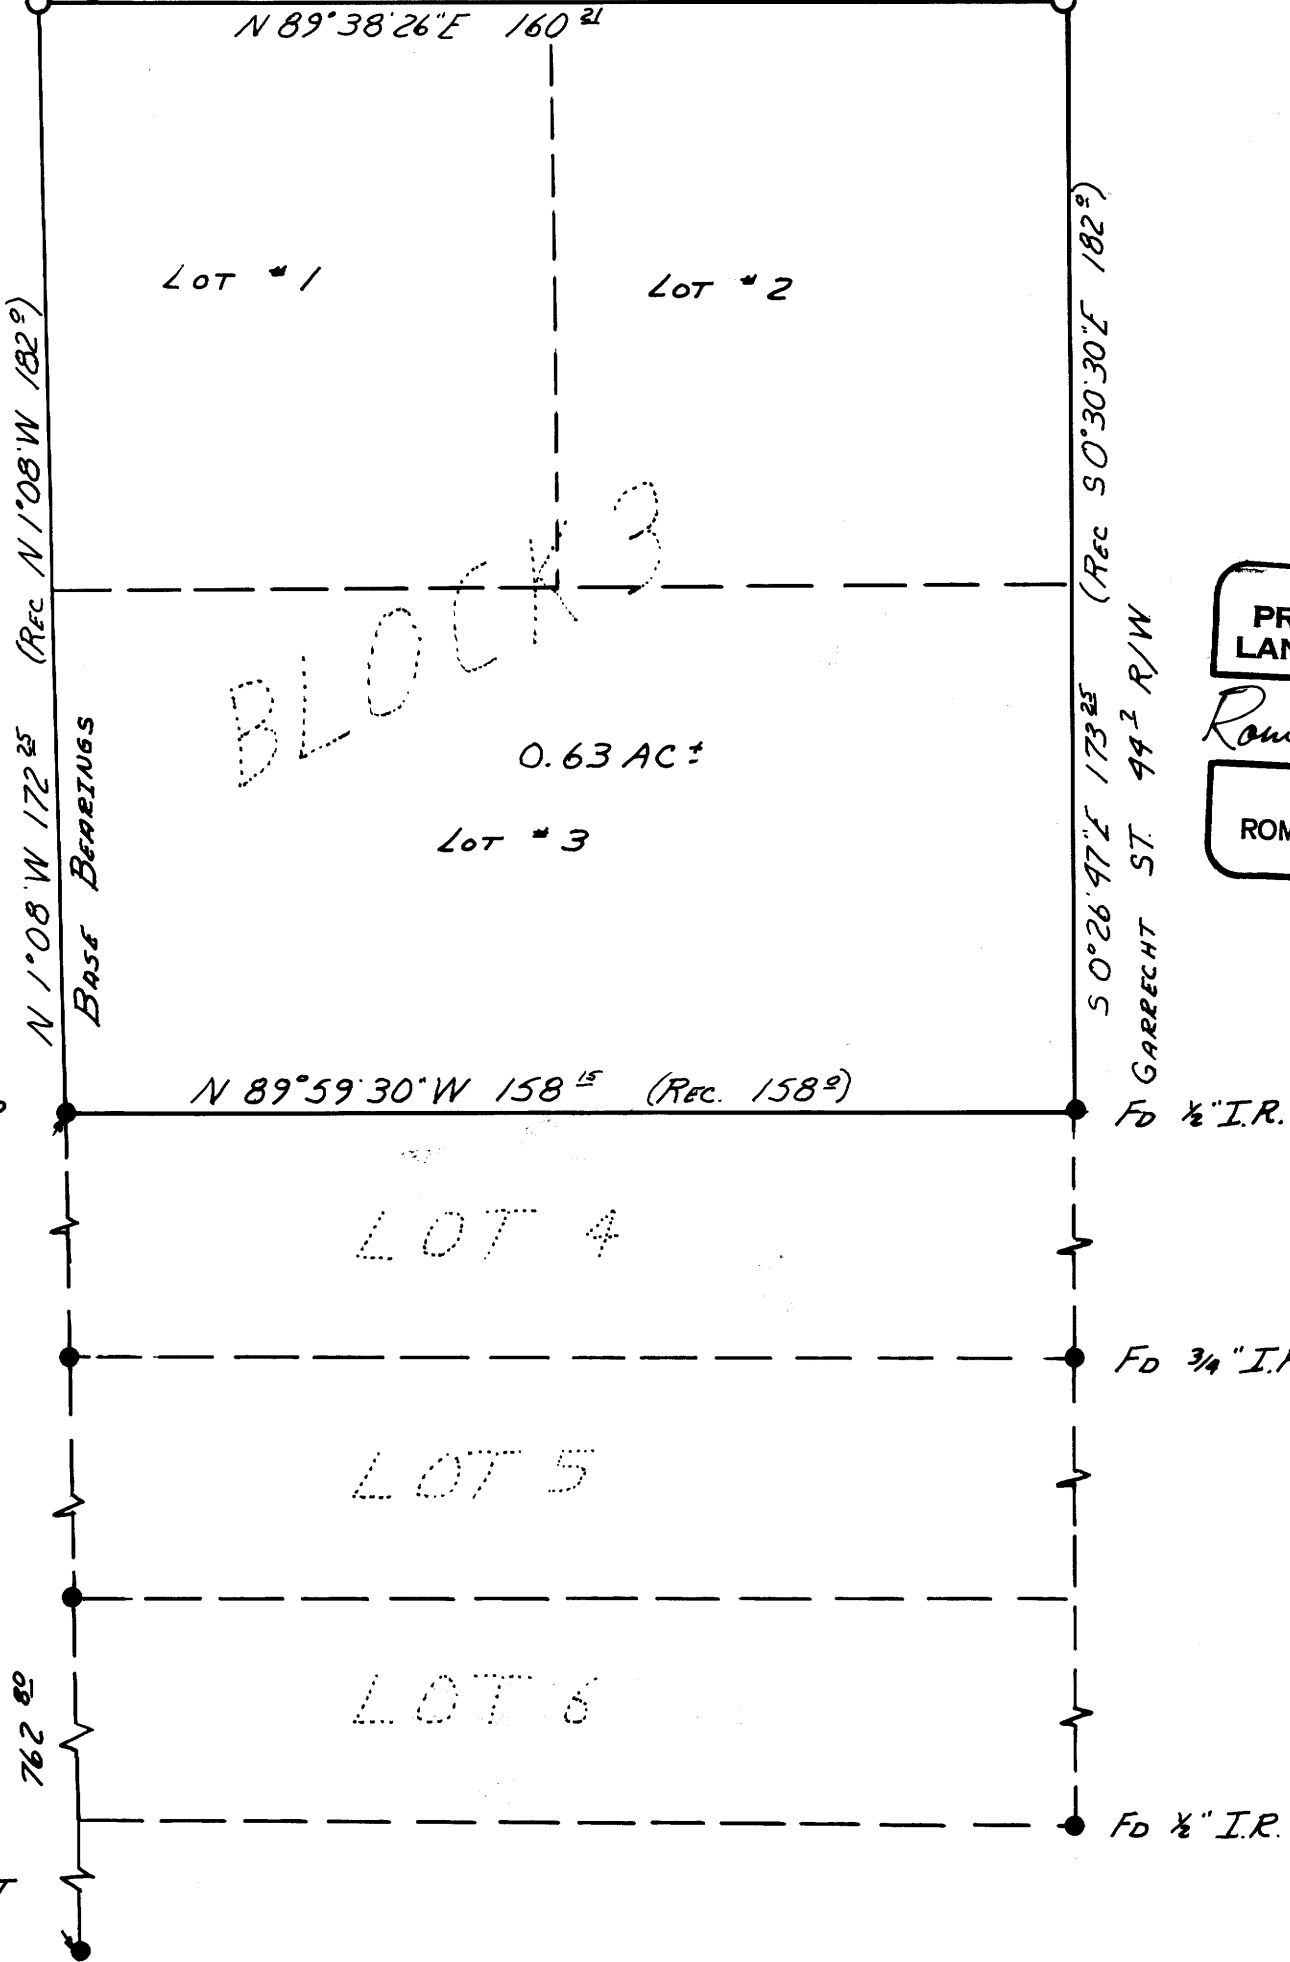

LOT # 1
LOT # 2
LOT # 3
0.63 AC ±
LOT # 4
LOT # 5
LOT # 6

REGISTERED
PROFESSIONAL
LAND SURVEYOR

Romano E. Ware

OREGON
NOV. 16, 1973
ROMANSO E. WARE
1005



INITIAL POINT
DEER CREEK
MEADOWS