

SURVEY FOR PROPERTY DESCRIPTION IN SEC. 29, T.25S., R.6W.W.M.


FOR - SMITH B. FOSBRINK
BY - BAUGHMAN SURVEYING SERVICE
APRIL, 1975

COUNTY SURVEYORS FILE DATA
DO NOT REMOVE FROM OFFICE

SCALE 1" = 200'

FILED ✓
RECEIVED *mg*
MAY 12 1975

COUNTY SURVEYOR
DOUGLAS COUNTY, ORE.

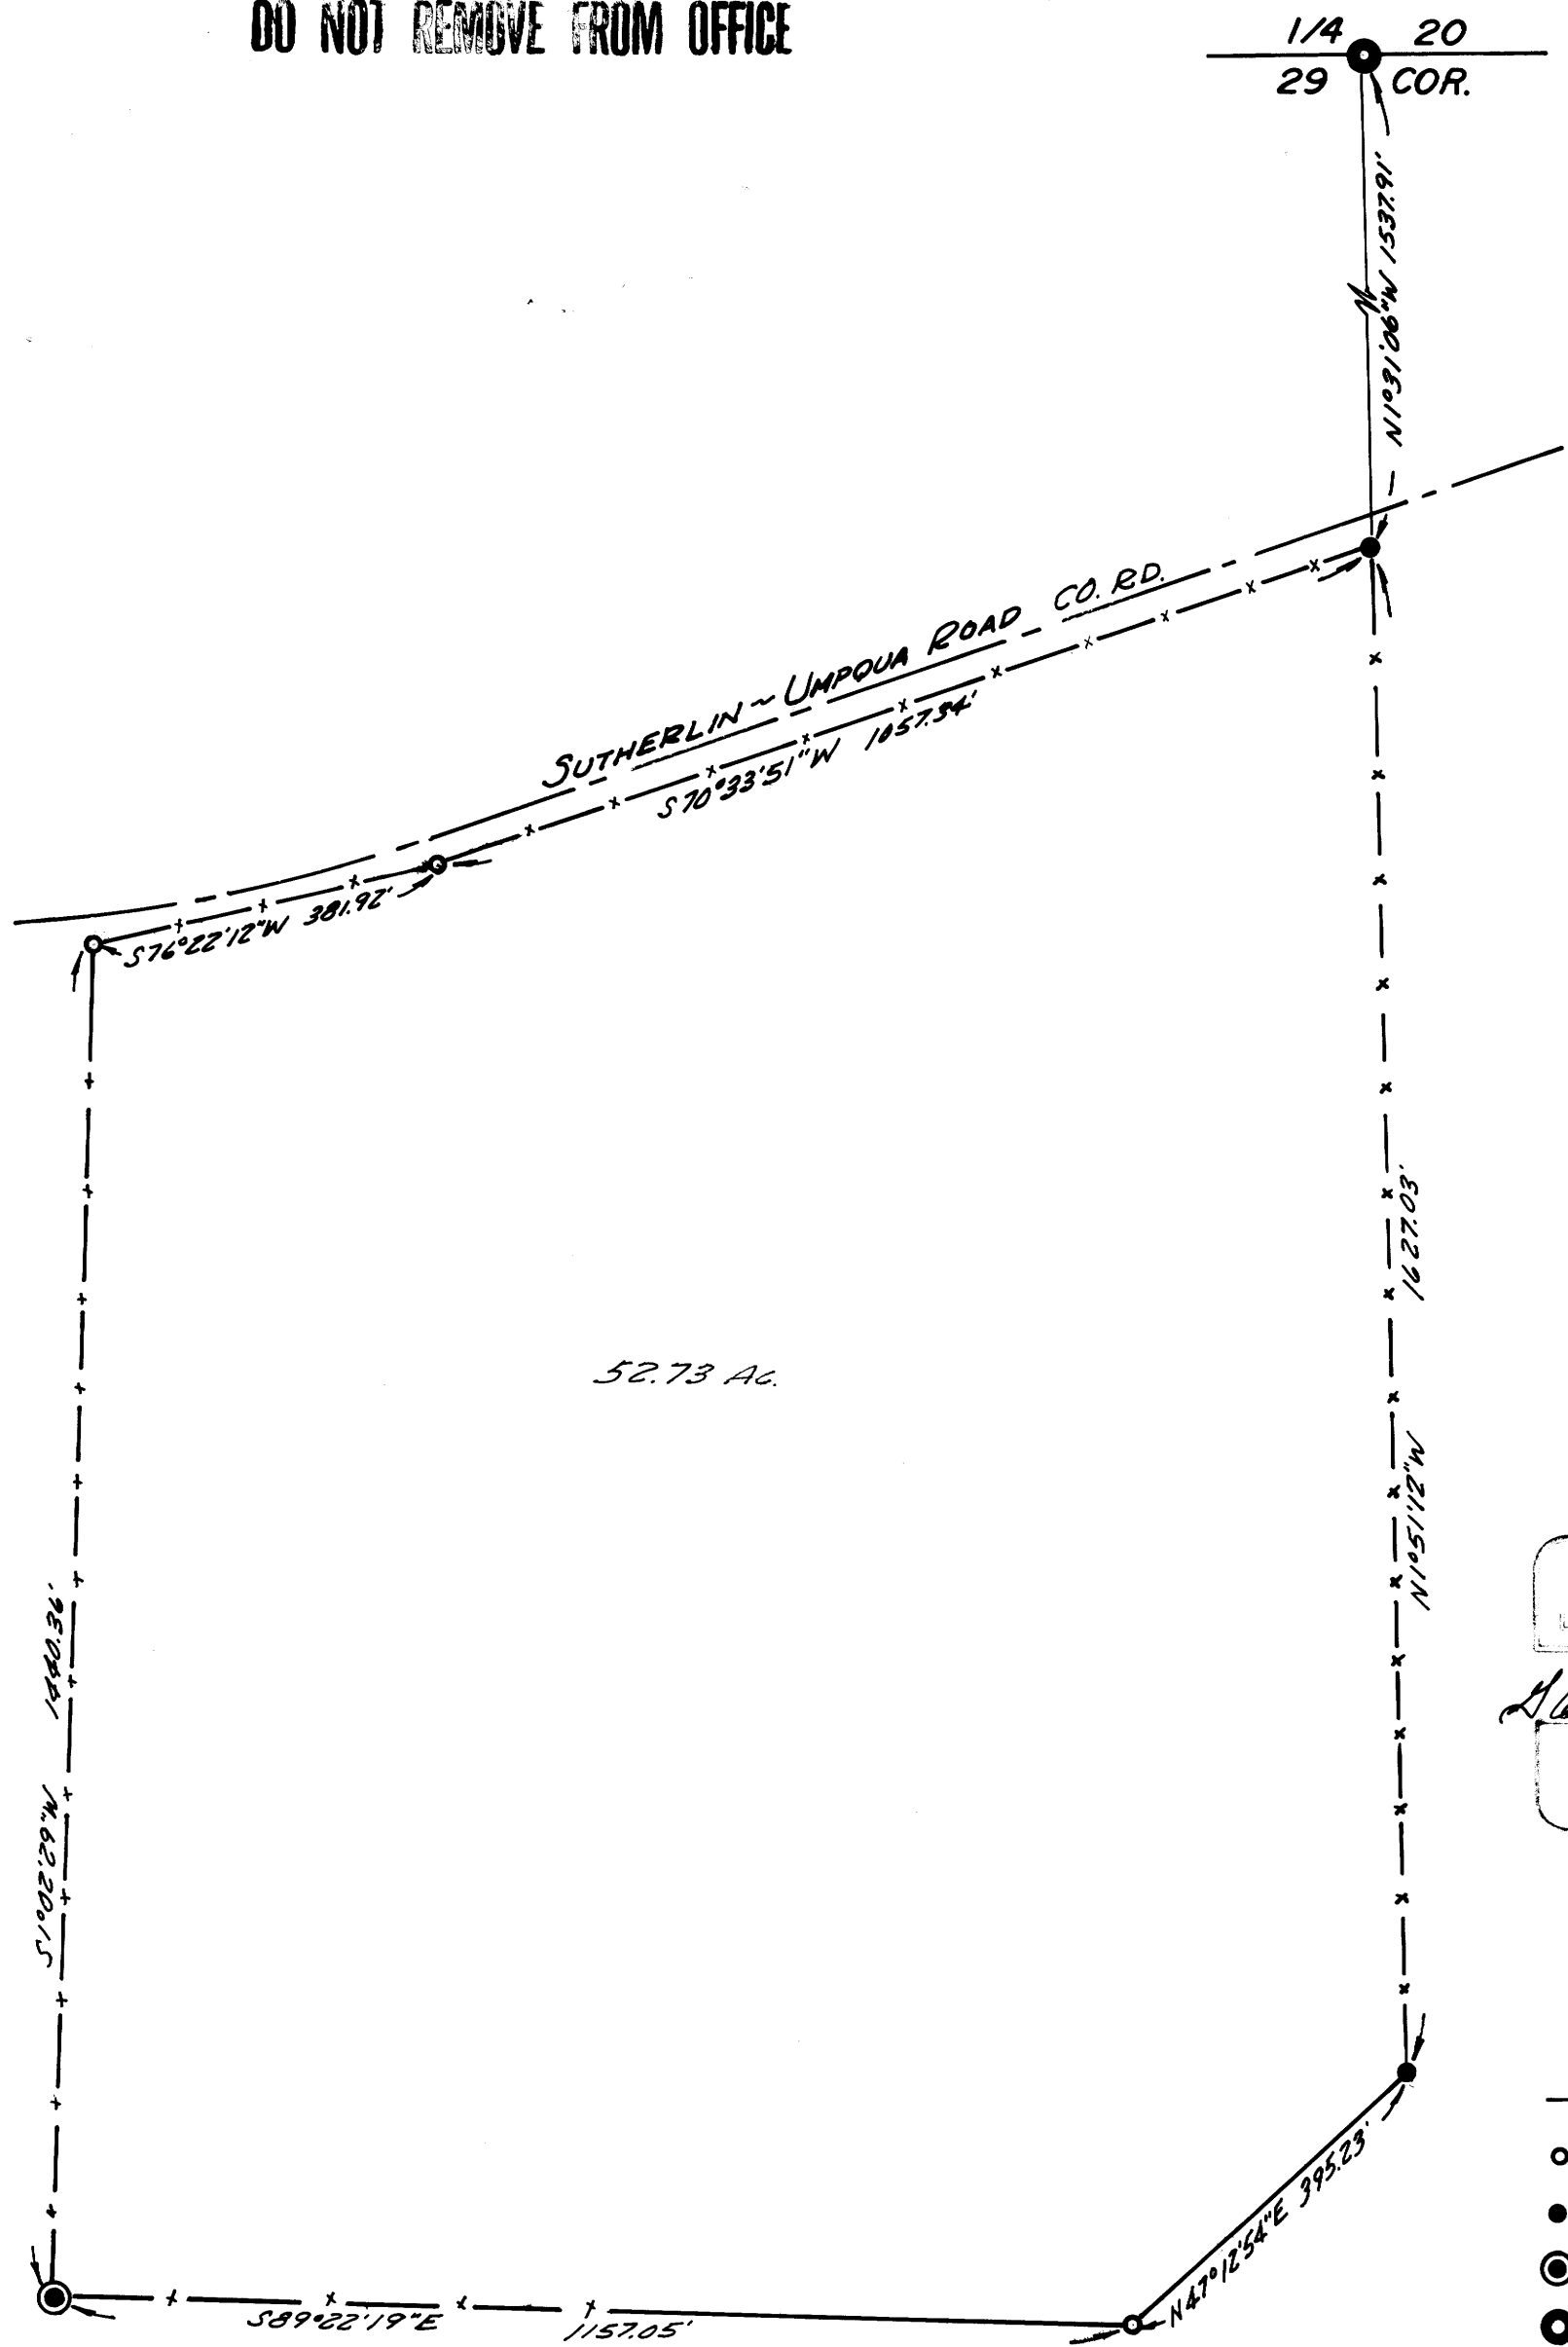

52.73 AC.

↑
BASED ON COUNTY ROAD

REGISTERED
PROFESSIONAL
LAND SURVEYOR

Glenn S. Baughman

OREGON
JULY 14, 1961
GLENN S. BAUGHMAN
536

LEGEND

- not set
- set 1/2" I.R.
- ⊙ iron bar
- ⦿ brass cap