

SURVEY IN LOT 2 FRUITVALE COUNTY SURVEYORS FILE DATA IN SECTION 12, T.27S.R.6W.W.M. DO NOT REMOVE FROM OFFICE


FILED *mg*
RECEIVED *mg*

FOR: MOCK MOTORS
BY: BAUGHMAN SURVEYING SERVICE
OCTOBER 1975 SCALE: 1"=40'

COUNTY SURVEYORS
DOUGLAS COUNTY, ORE.
mg

M 58 - 34

BASED ON M.34-14

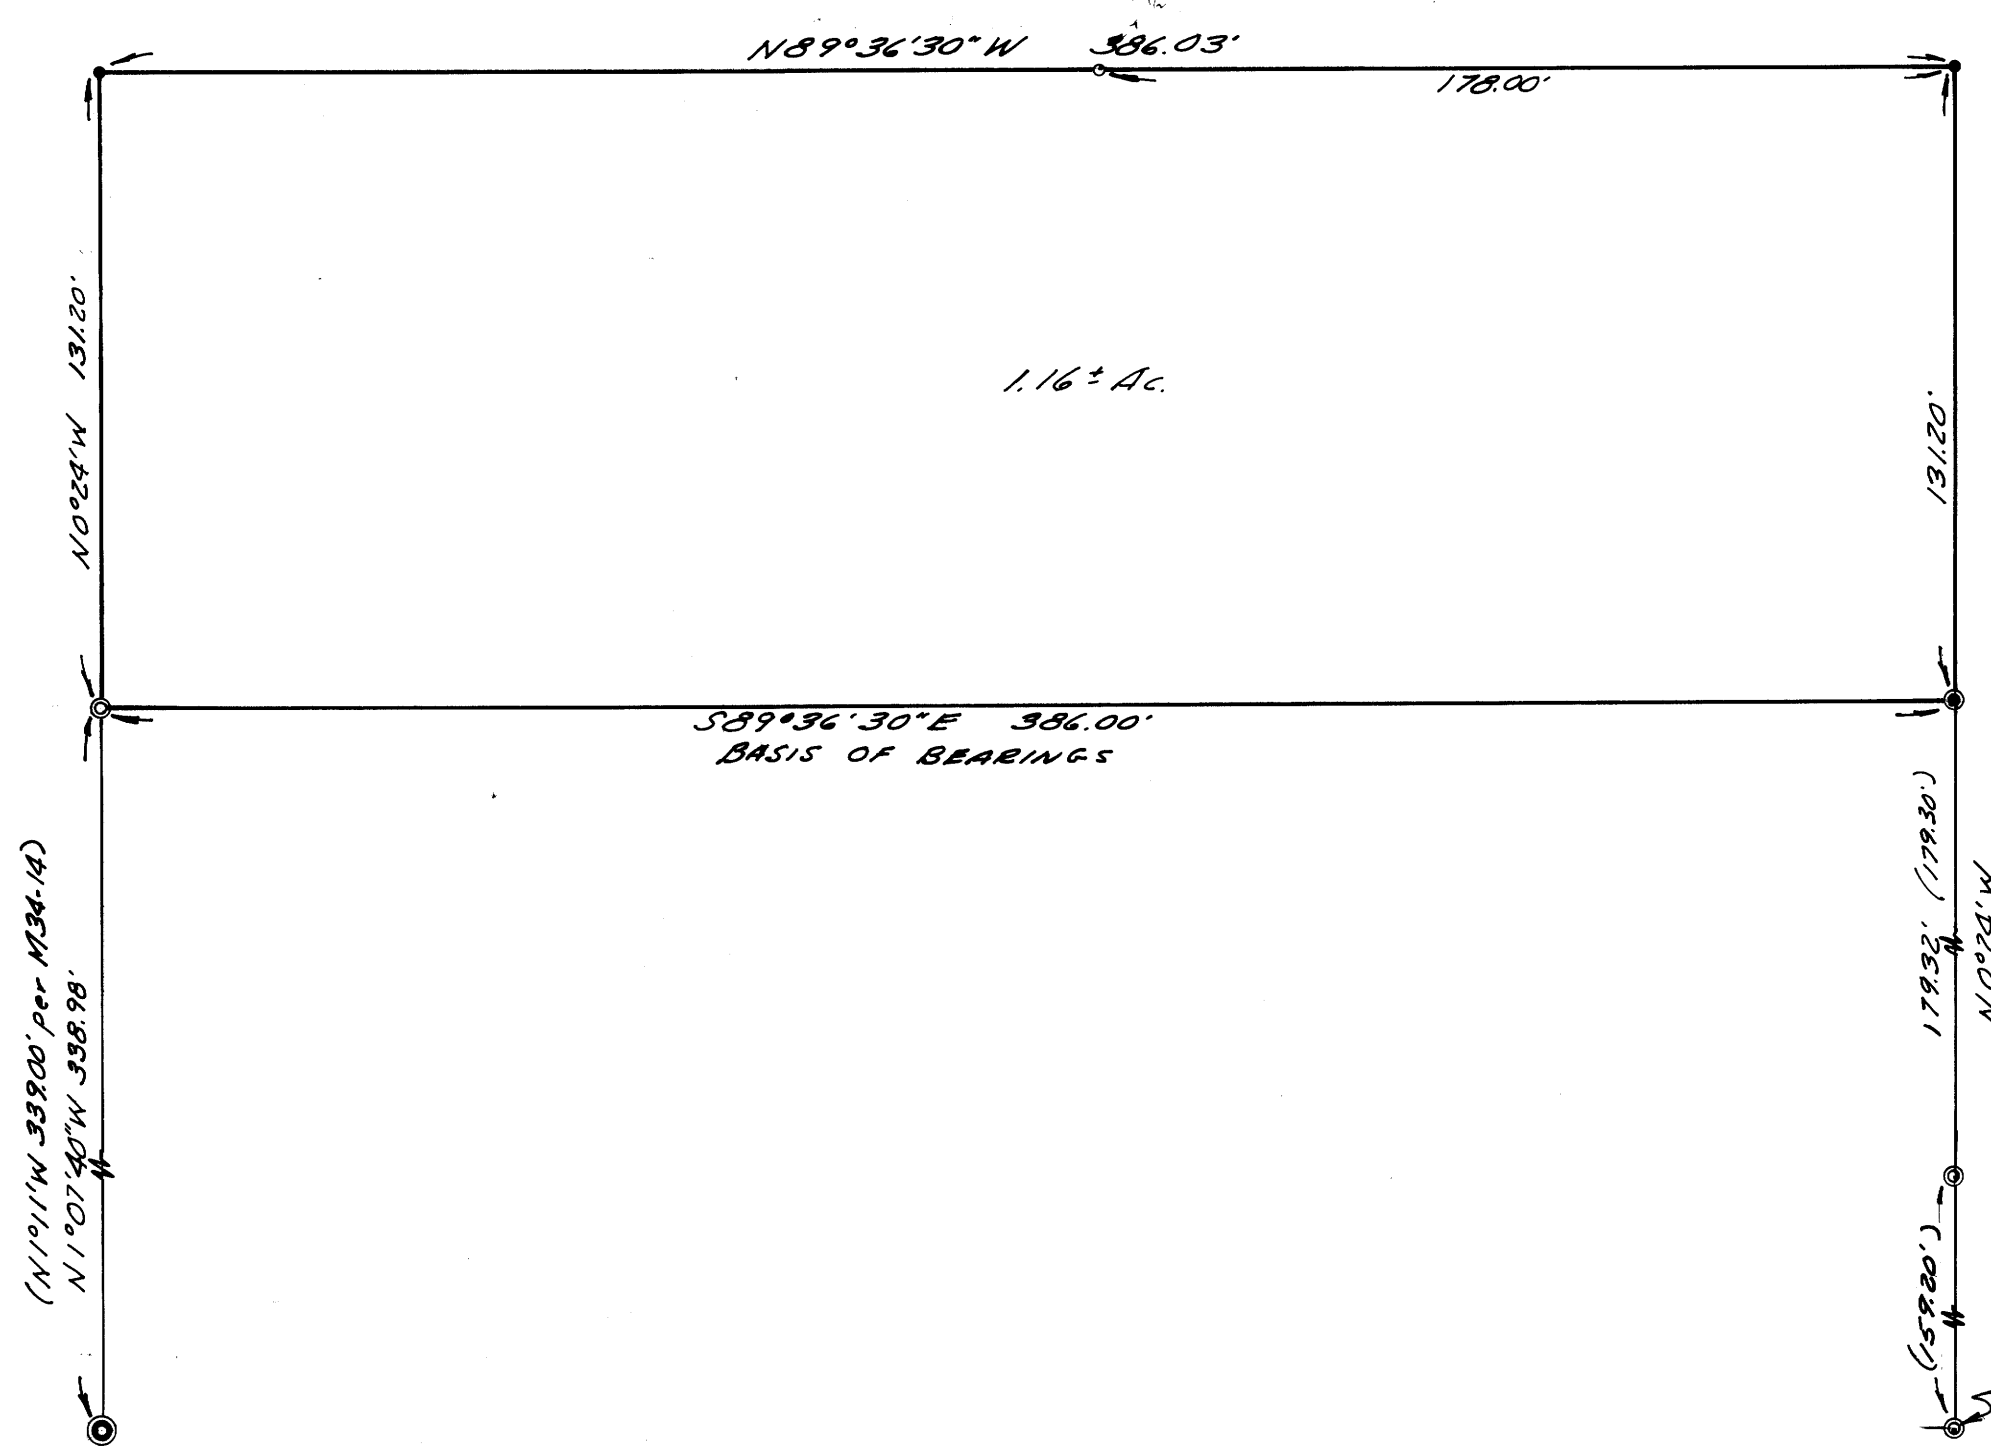

LEGEND

- — Set 5/8" iron rod
- — Set 1/2" iron rod
- ⊙ — Found Bridge Spike
- ⊗ — Found 3/4" iron rod
- ⊕ — Found 1 1/2" iron pipe

Almond Baughman

SE COR LOT 2
FRUITVALE PER
SURVEY M.34-14

M 58 - 34