



July, 1973

Survey for Ron Geisen  
Section 1, T 27 S, R 6 W, W. M.  
Douglas County, Oregon

FILED

RECEIVED

*di*

DEC 29 1975

COUNTY SURVEYOR  
DOUGLAS COUNTY, ORE.

I located the Oregon State Highway Dept. right-of-way pin just south of Joseph Street and the spiral point near the Northerly end of the property.

I located the iron rods delineating the westerly line of Ferguson Terraces, Block 3 and 4.

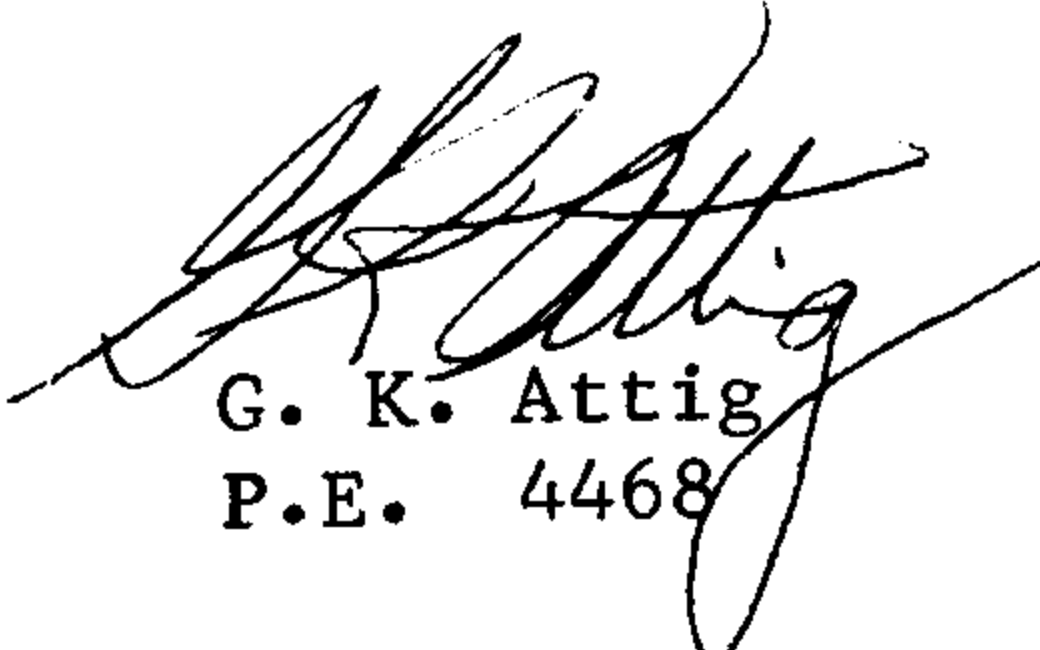
I then ran a complete traverse around the property and along General Street. I set hubs and tacks at the angle points on the traverse.

The northerly boundary of General Avenue was established by use of the iron rods through the Ferguson Acres Subdivision.

I found an iron rod recorded as the intersection of Bower Street and General Avenue.

All these iron rods were tied by transit and chain to the traverse points.

The perimeter of the tract was determined by calculations from the existing iron rods and the property corners were set by ties from the traverse points.

  
G. K. Attig  
P.E. 4468

C.S. File 58 / 80

Map File MSB / 72