

Survey in S.W. 1/4, Sec. 33, T25S, R6W, W.M.

For: Mike Herrick

By: BHW Eng. & Surveying, Inc.

Date: Dec., 1975

COUNTY SURVEYORS FILE DATA

DO NOT REMOVE FROM OFFICE

Scale 1"=200'

FILED mg  
RECEIVED pc


DEC 20 1975

COUNTY SURVEYOR  
DOUGLAS COUNTY, ORE.

- Set 3/4" Iron Pipe
- Fd. Monument

1/4 COR.  
FD. BRASS  
CAP  
BEARING TREES FD.  
AS PER REC.

FD. 1" I. PIPE (NOT OF RECORD)  
0.26' EAST OF COMPUTED LINE

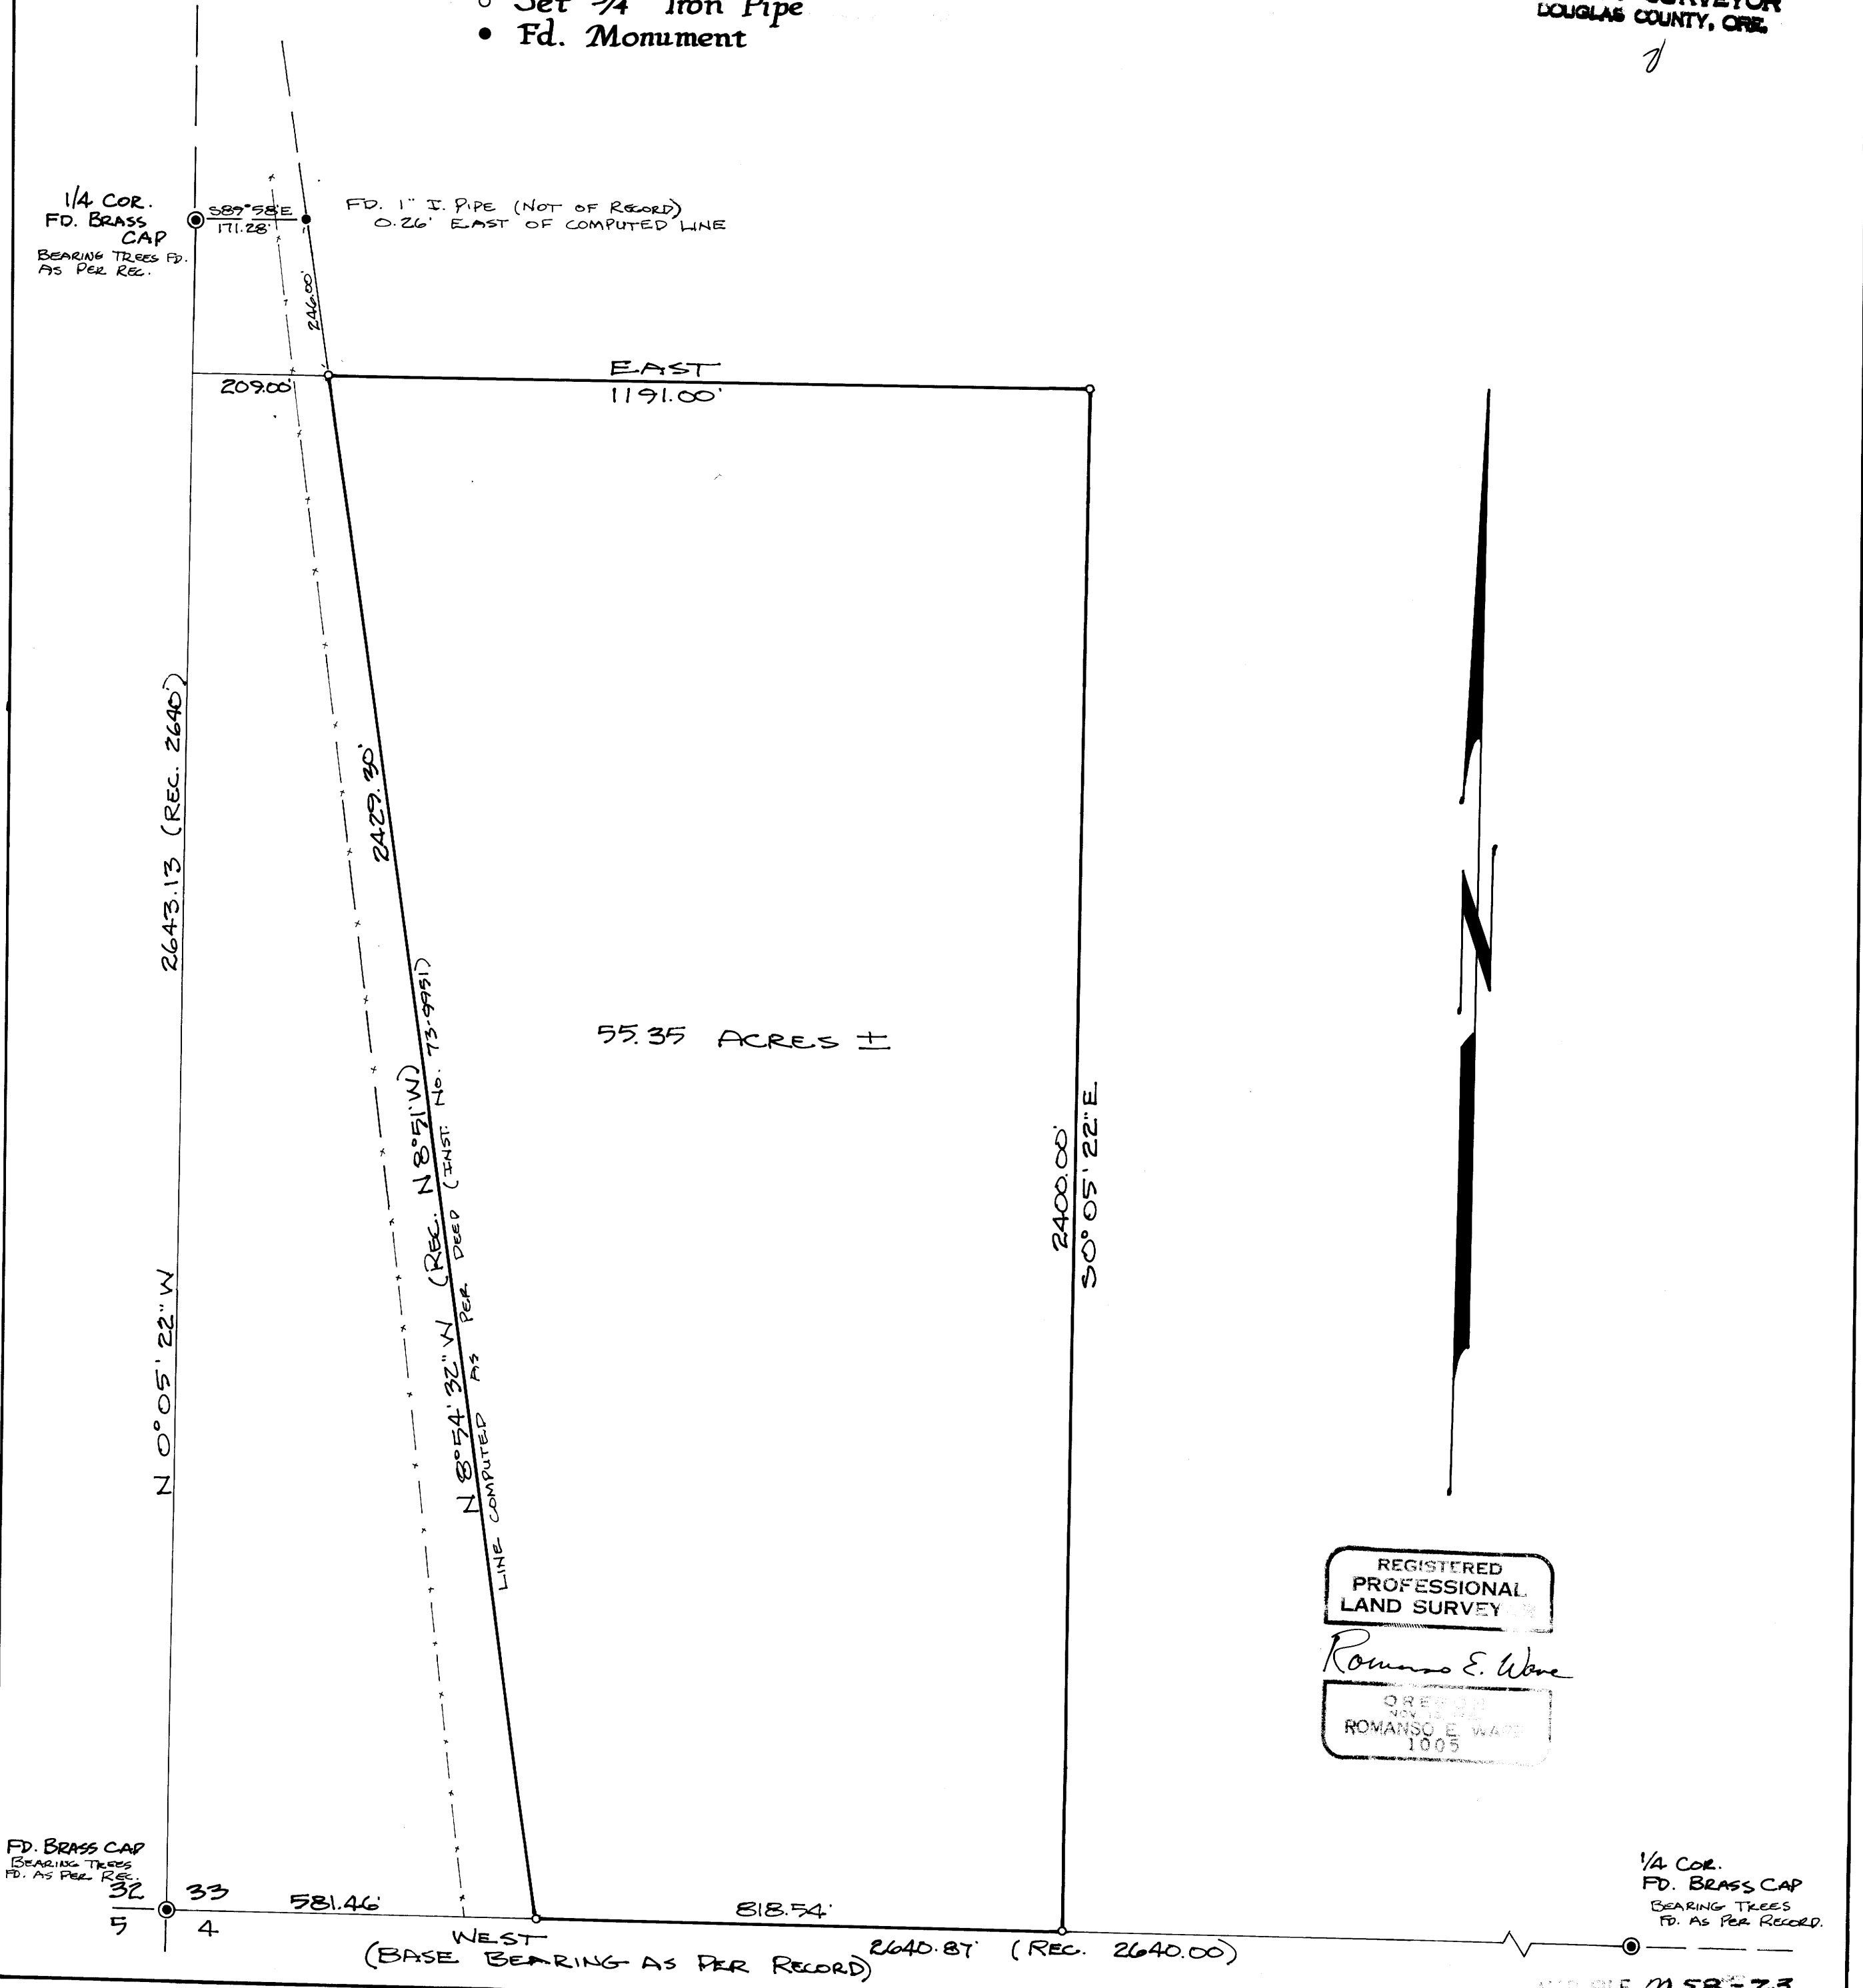

55.35 ACRES ±

REGISTERED  
PROFESSIONAL  
LAND SURVEY

Romanso E. Ware

OREGON  
NOV 15 1975  
ROMANSO E. WARE  
1005

FD. BRASS CAP  
BEARING TREES  
FD. AS PER REC.

1/4 COR.  
FD. BRASS CAP  
BEARING TREES  
FD. AS PER RECORD.