

COUNTY SURVEYORS FILE DATA  
DO NOT REMOVE FROM OFFICE


# SURVEY FOR DESCRIPTION IN SECTION 19, T.22S.R.7W.W.M.

FOR: W.D. CROOK  
BY: BAUGHMAN SURVEYING SERVICE

JANUARY 1976 SCALE: 1"=100'

FILED *mg*  
RECEIVED *mg*  
JAN 4 1976  
COUNTY SURVEYOR  
DOUGLAS COUNTY, ORE.  
*z*

M59-19

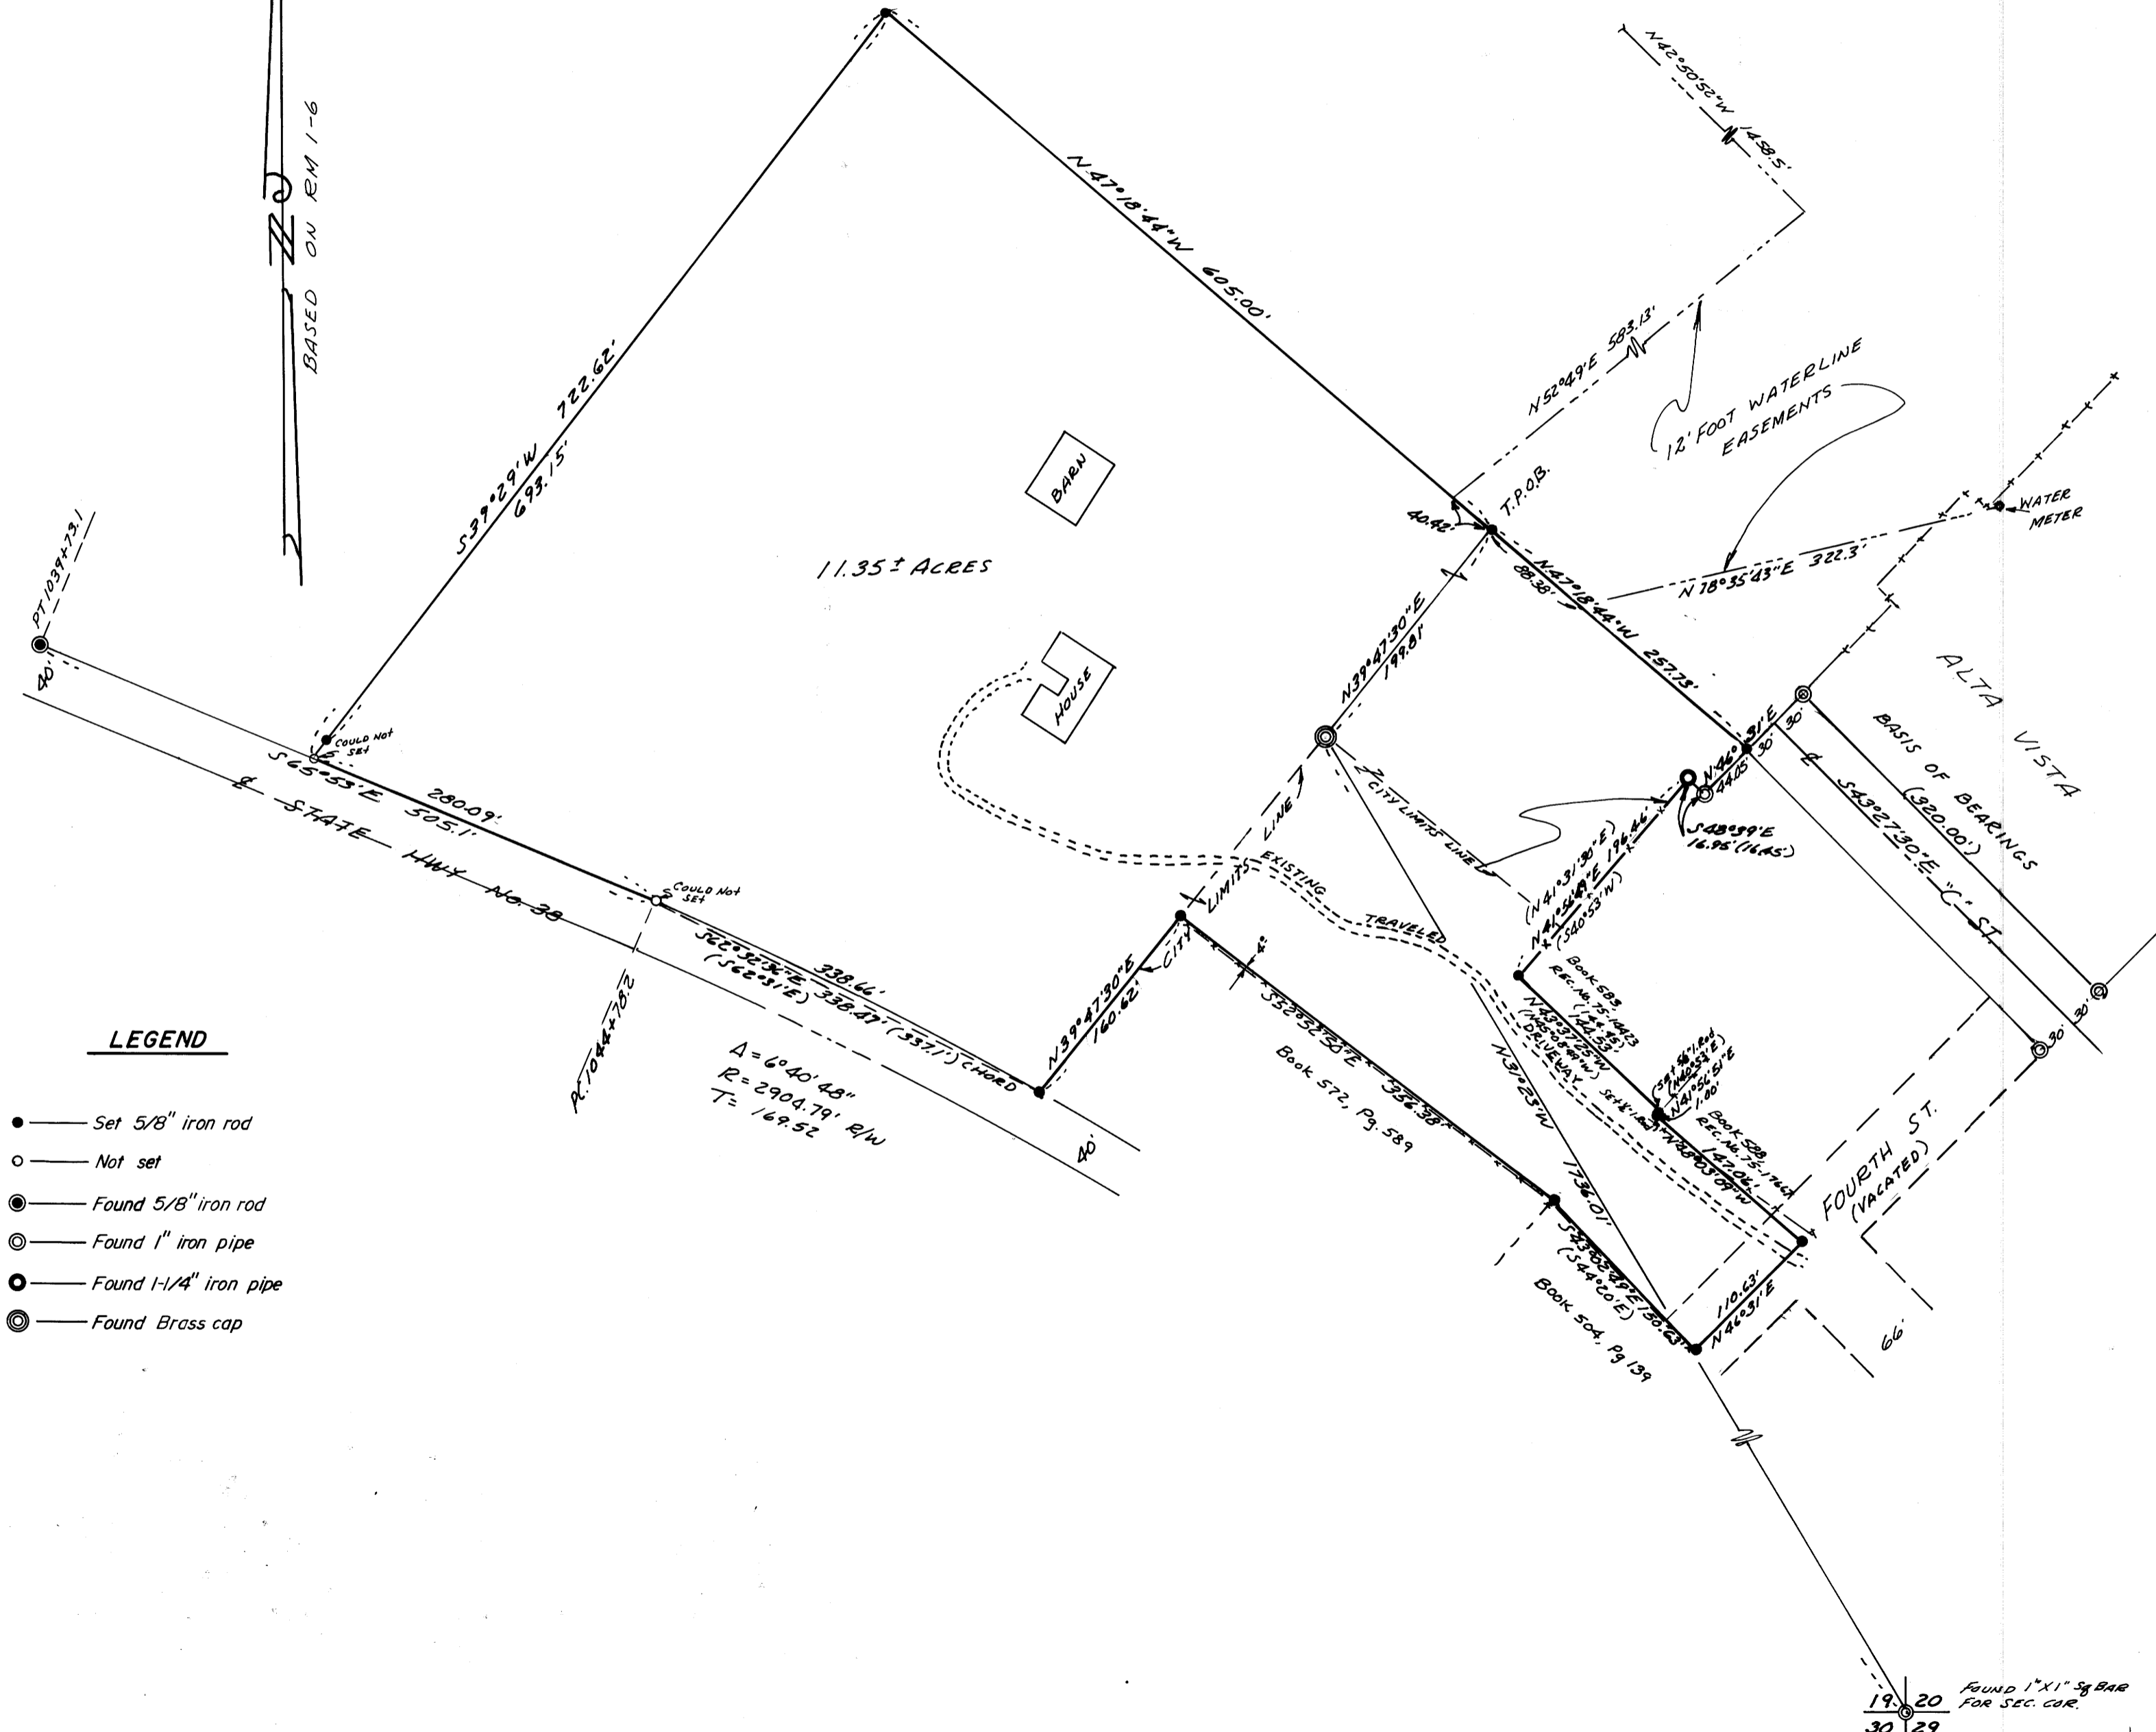

**LEGEND**

- — Set 5/8" iron rod
- — Not set
- ⊙ — Found 5/8" iron rod
- ⊙ — Found 1" iron pipe
- ⊙ — Found 1-1/4" iron pipe
- ⊙ — Found Brass cap

M59-19

REGISTERED  
PROFESSIONAL  
LAND SURVEYOR  
*Glenn S. Baughman*  
OREGON  
JULY 14, 1961  
GLENN S. BAUGHMAN  
536