

COUNTY SURVEYORS FILE DATA
DO NOT REMOVE FROM OFFICE


202 pg 160

MINOR LAND PARTITION
T26S R6W W.M. SEC 23

PARTITIONER & LEGAL OWNER G.C. BLANK
SURVEYED BY B. ROGERS SCALE 1" = 50'
● = 1" PINS FOUND ○ = 5/8" RODS SET
RECORD BEARINGS & DIST = ()
FEB. 1976 BASIS OF BEARING SEE VOL. 9 PG. 14

PAGE - 1

FILED *mg*
RECEIVED *mg*
FEB 10 1976
COUNTY SURVEYOR
DOUGLAS COUNTY, ORE.

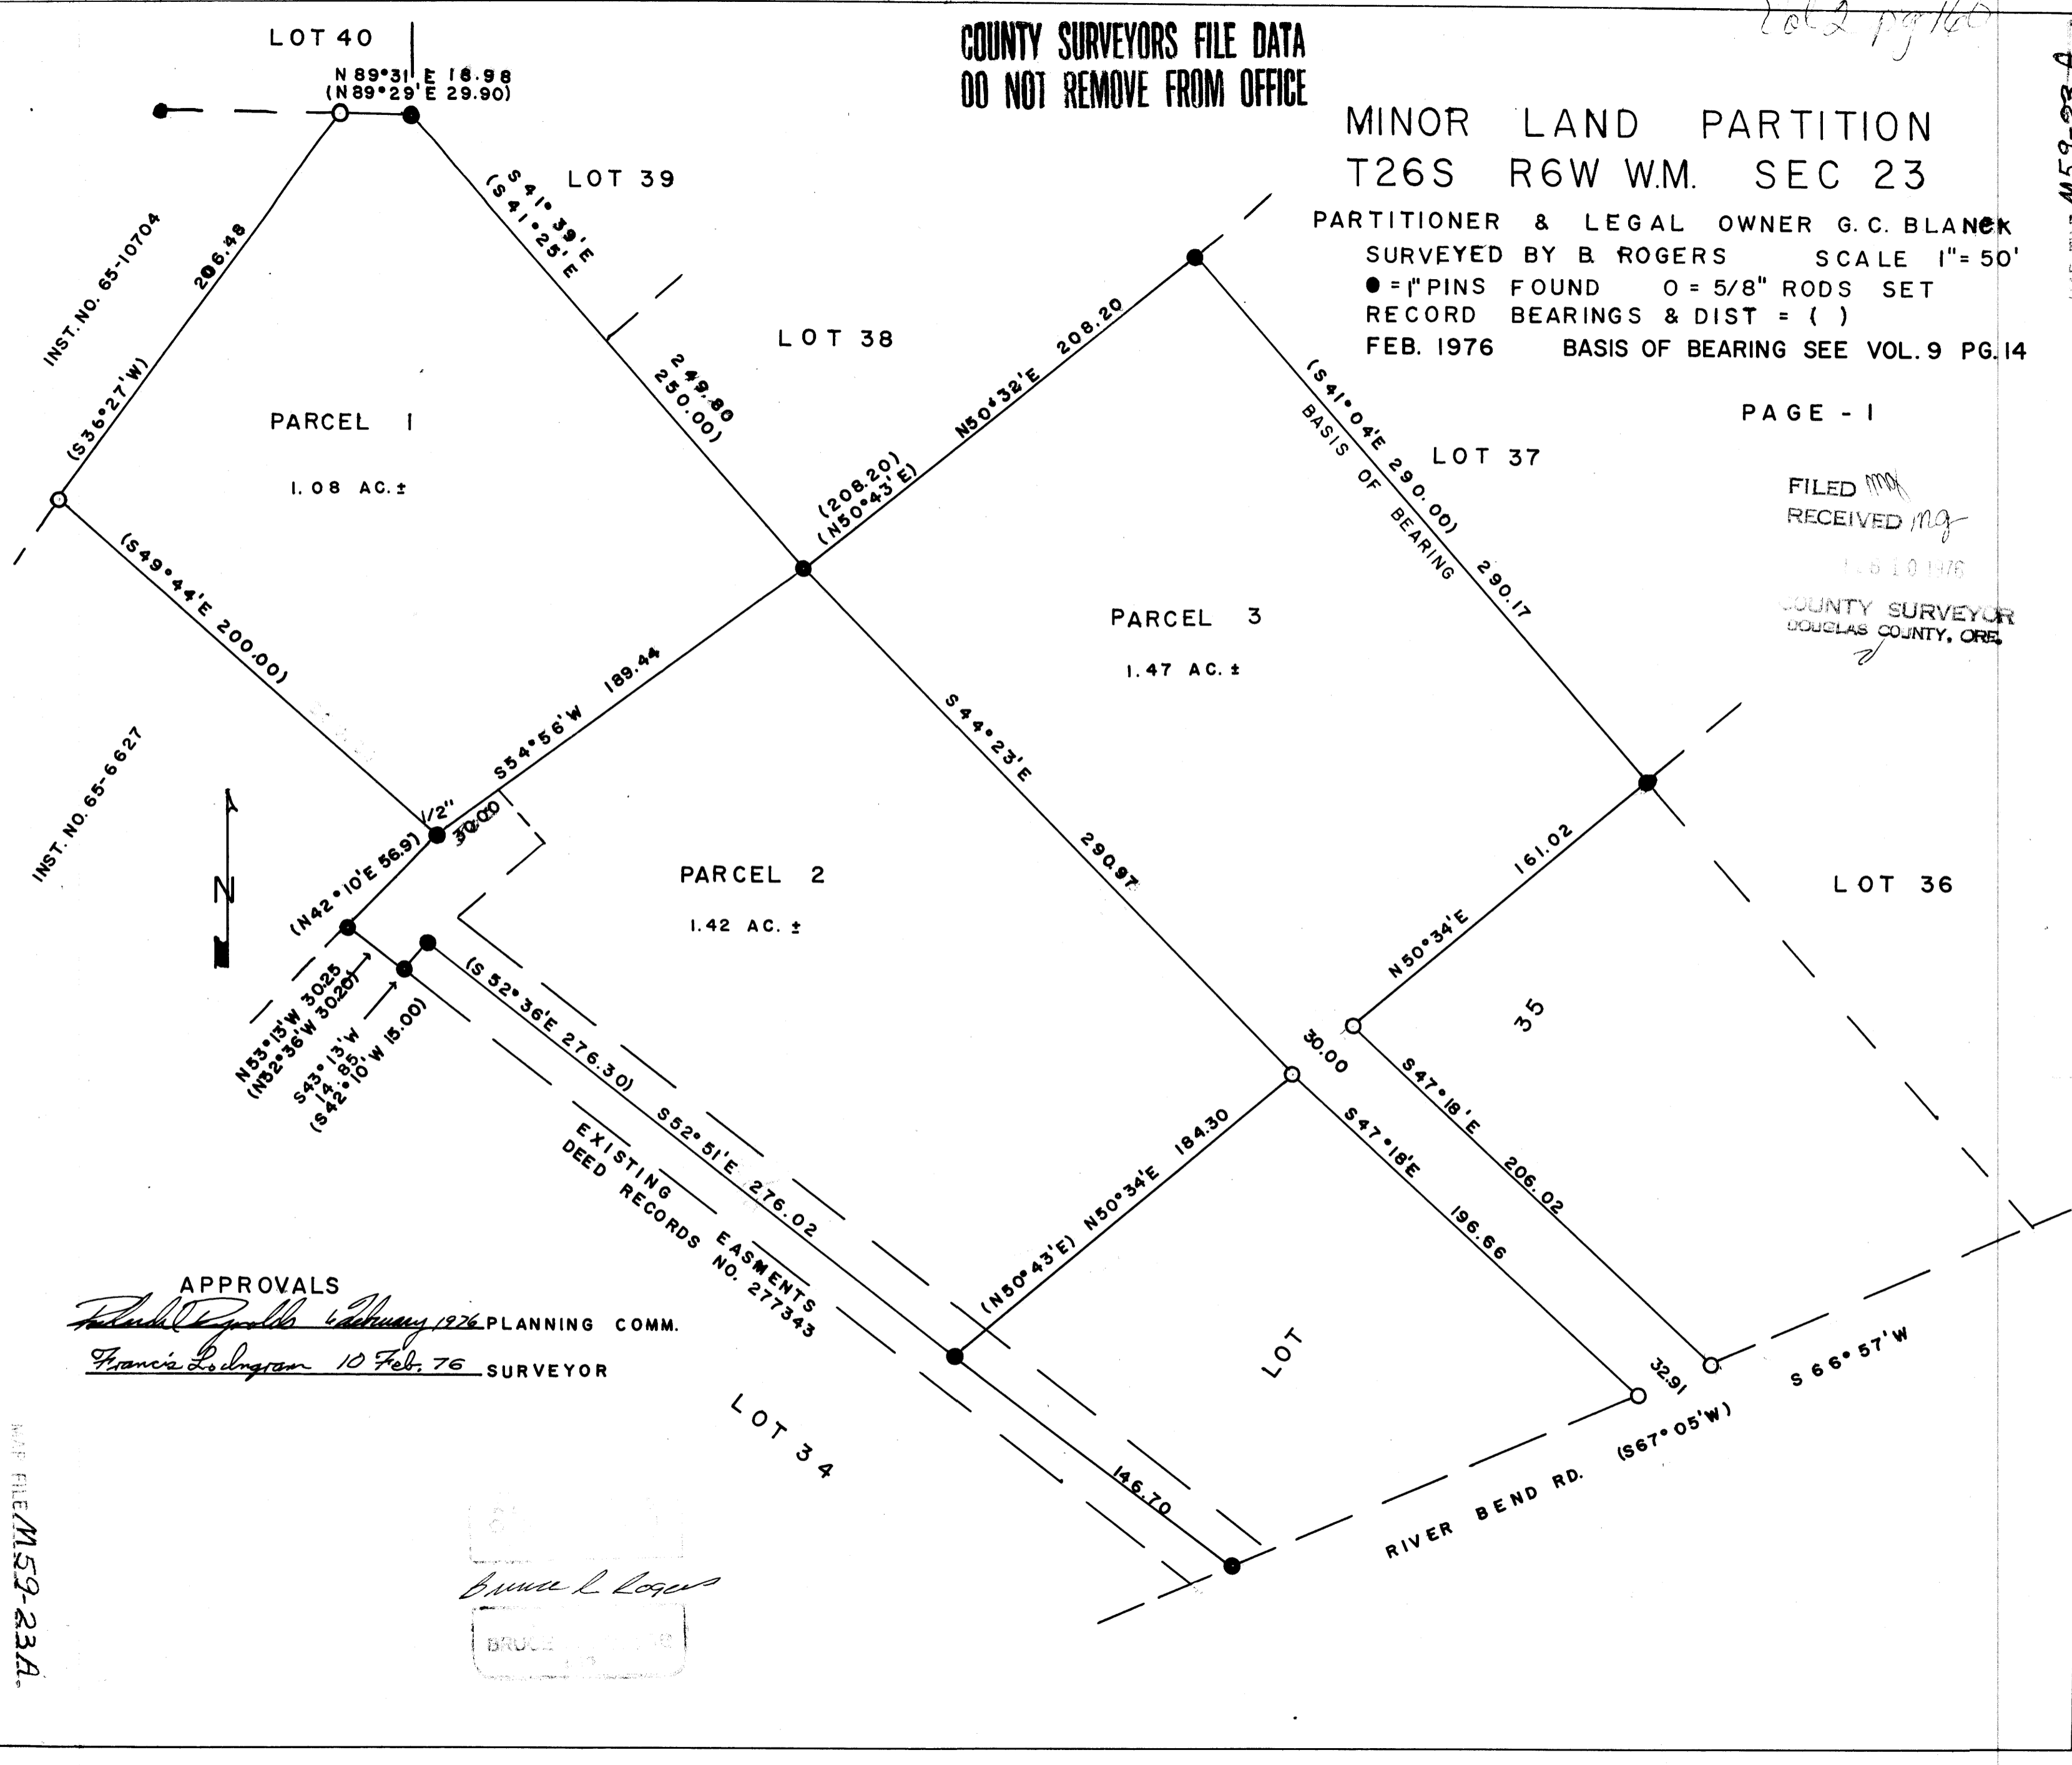

APPROVALS

Paul Reynolds February 1976 PLANNING COMM.
Francis Robinson 10 Feb. 76 SURVEYOR

Bruce Rogers
BRUCE ROGERS

MAP FILE M59-23A

MAP FILE M59-23A