


FILED ✓
 RECEIVED 74
 APR 22 1976
 COUNTY SURVEYOR
 DOUGLAS COUNTY, ORE.
 ✓

MAP FILE M.52 - 70

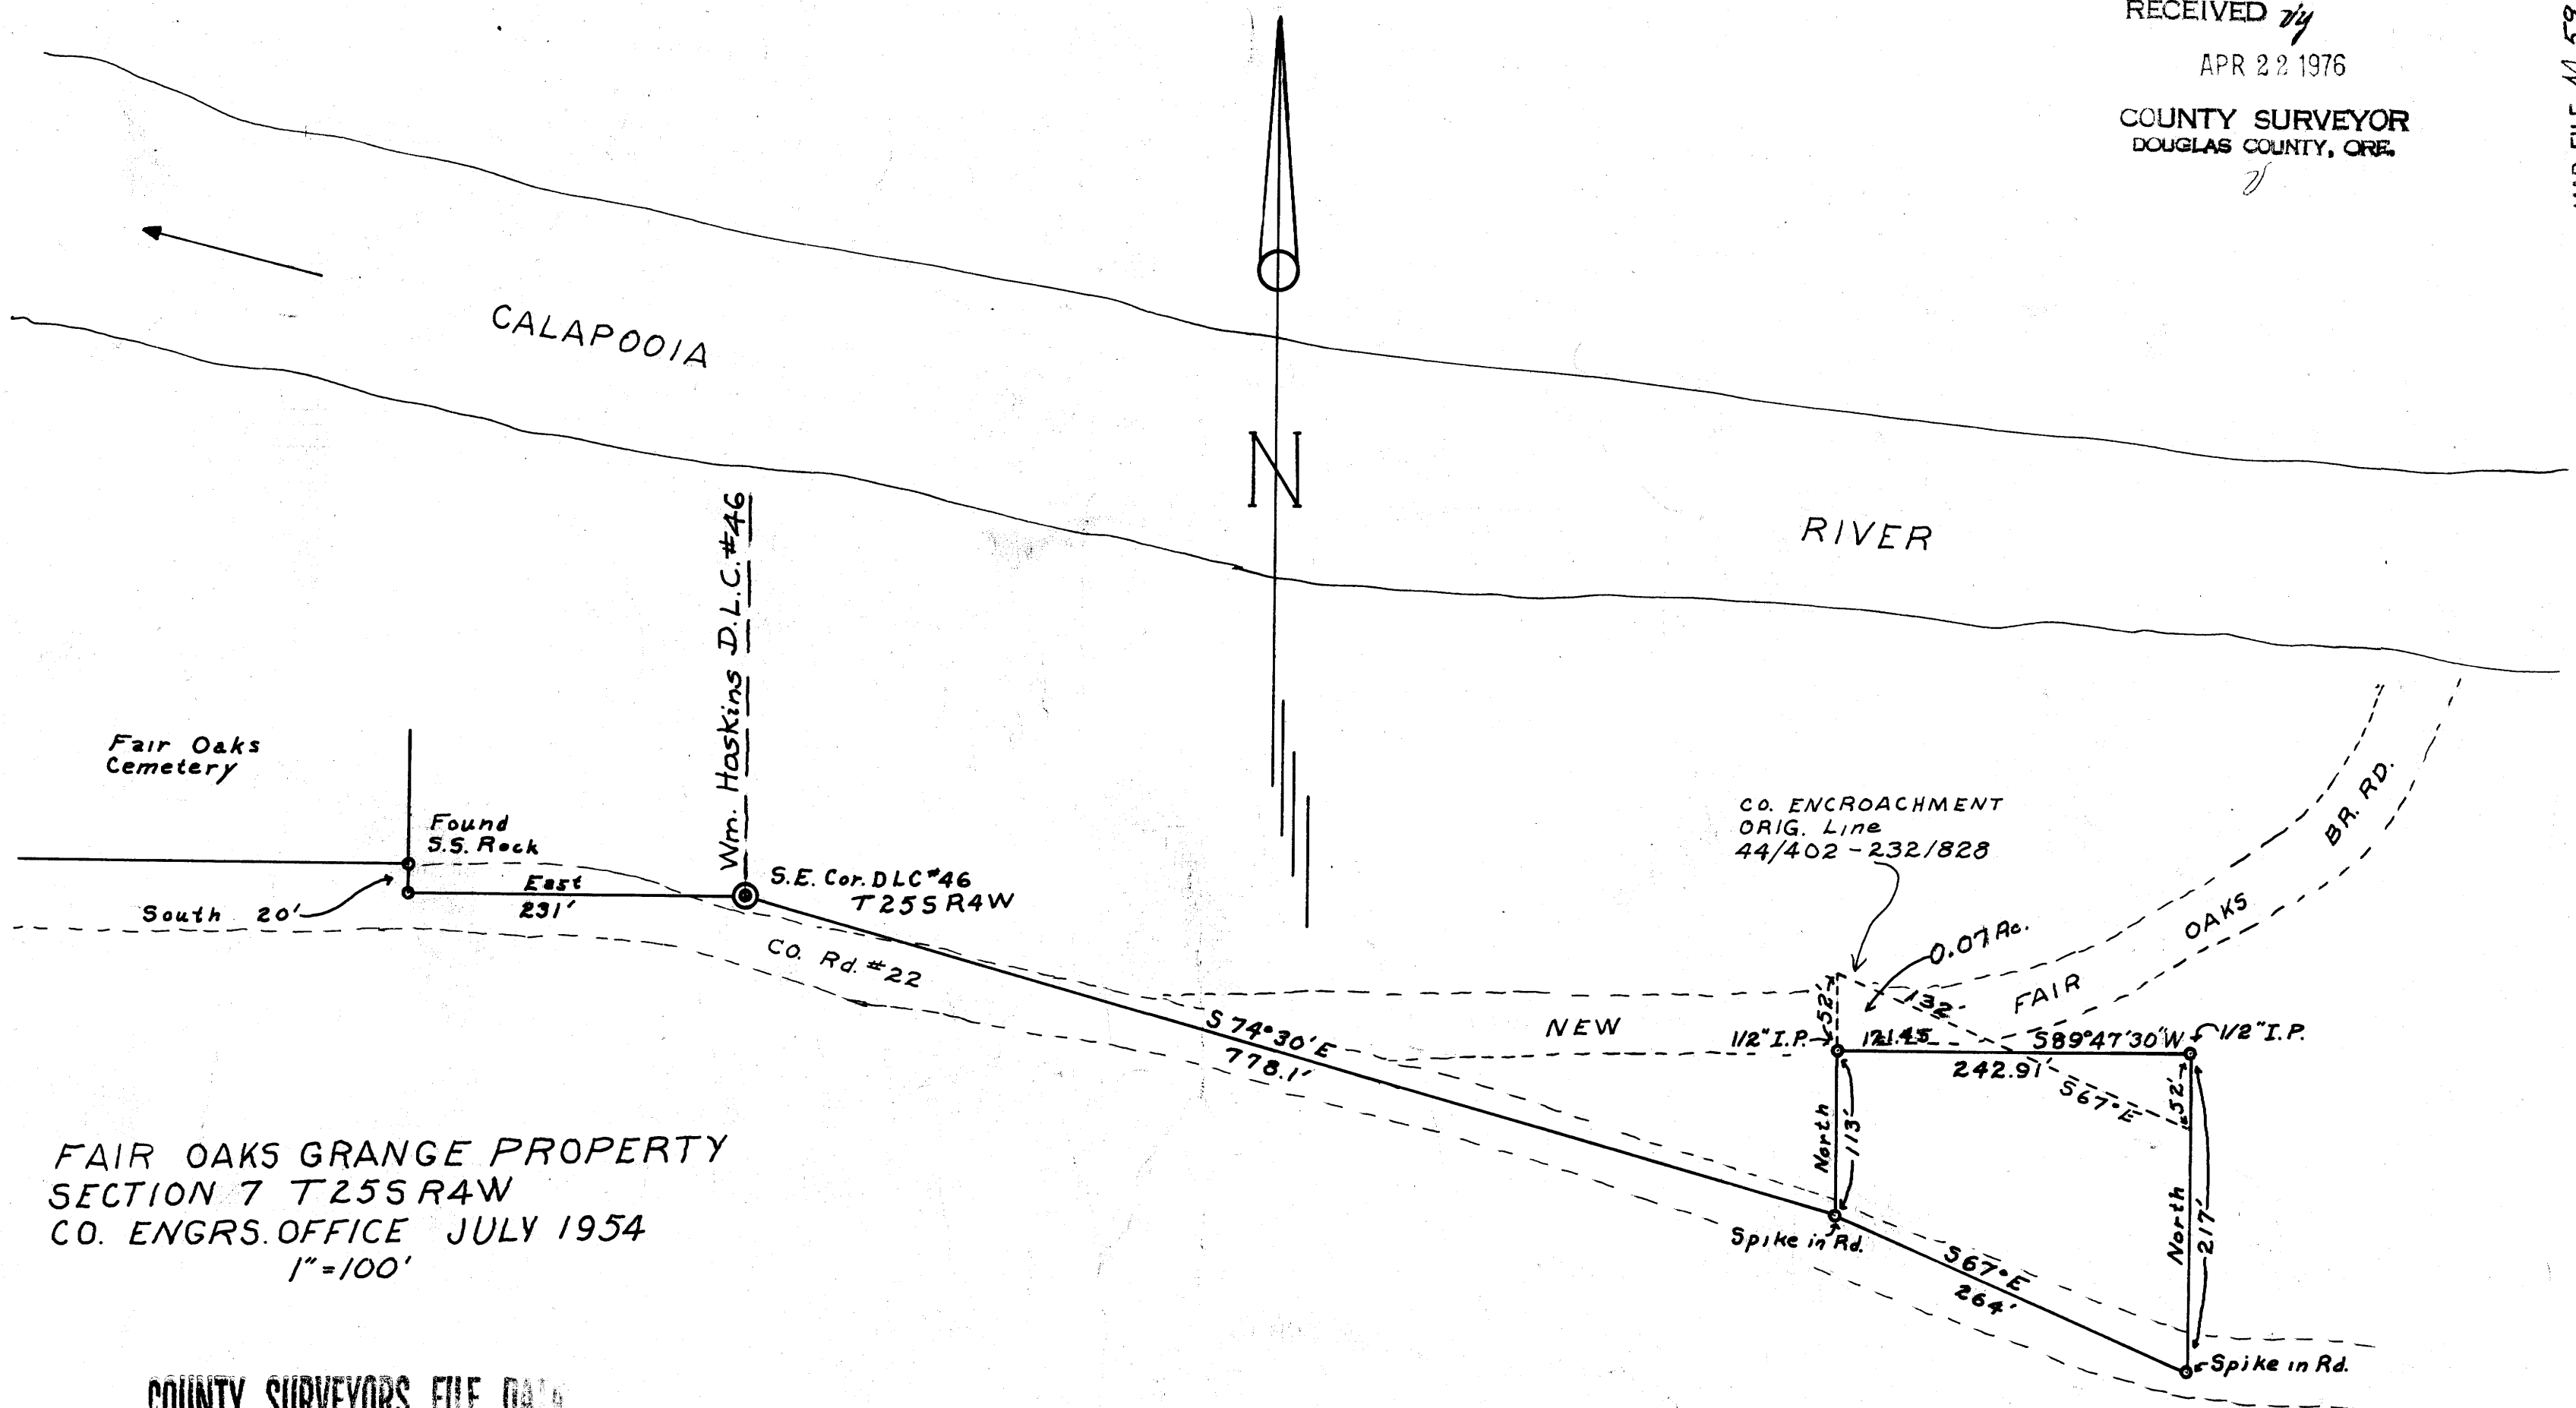

FAIR OAKS GRANGE PROPERTY
 SECTION 7 T255 R4W
 CO. ENGRS. OFFICE JULY 1954
 1" = 100'

COUNTY SURVEYORS FILE DATA
 DO NOT REMOVE FROM OFFICE

FILE RD 22A

②

MAP FILE M.52 - 70