


# SURVEY FOR PROPERTY CORNERS & DESCRIPTION IN LOTS 8,9,10, BLOCK 74, SUBDIVISION "A" KINNEY'S IMPROVED PLAT SECTION 18, T.27S. R.5W.W.M. — SCALE: 1"=20' — APRIL 1976

FOR: TRANSAMERICA TITLE CO.  
BY: BAUGHMAN SURVEYING SERVICE

COUNTY SURVEYORS FILE DATA  
DO NOT REMOVE FROM OFFICE

FILED *2*  
RECEIVED *for*  
MAY 7 1976  
COUNTY SURVEYOR  
DOUGLAS COUNTY, ORE.  
*2*

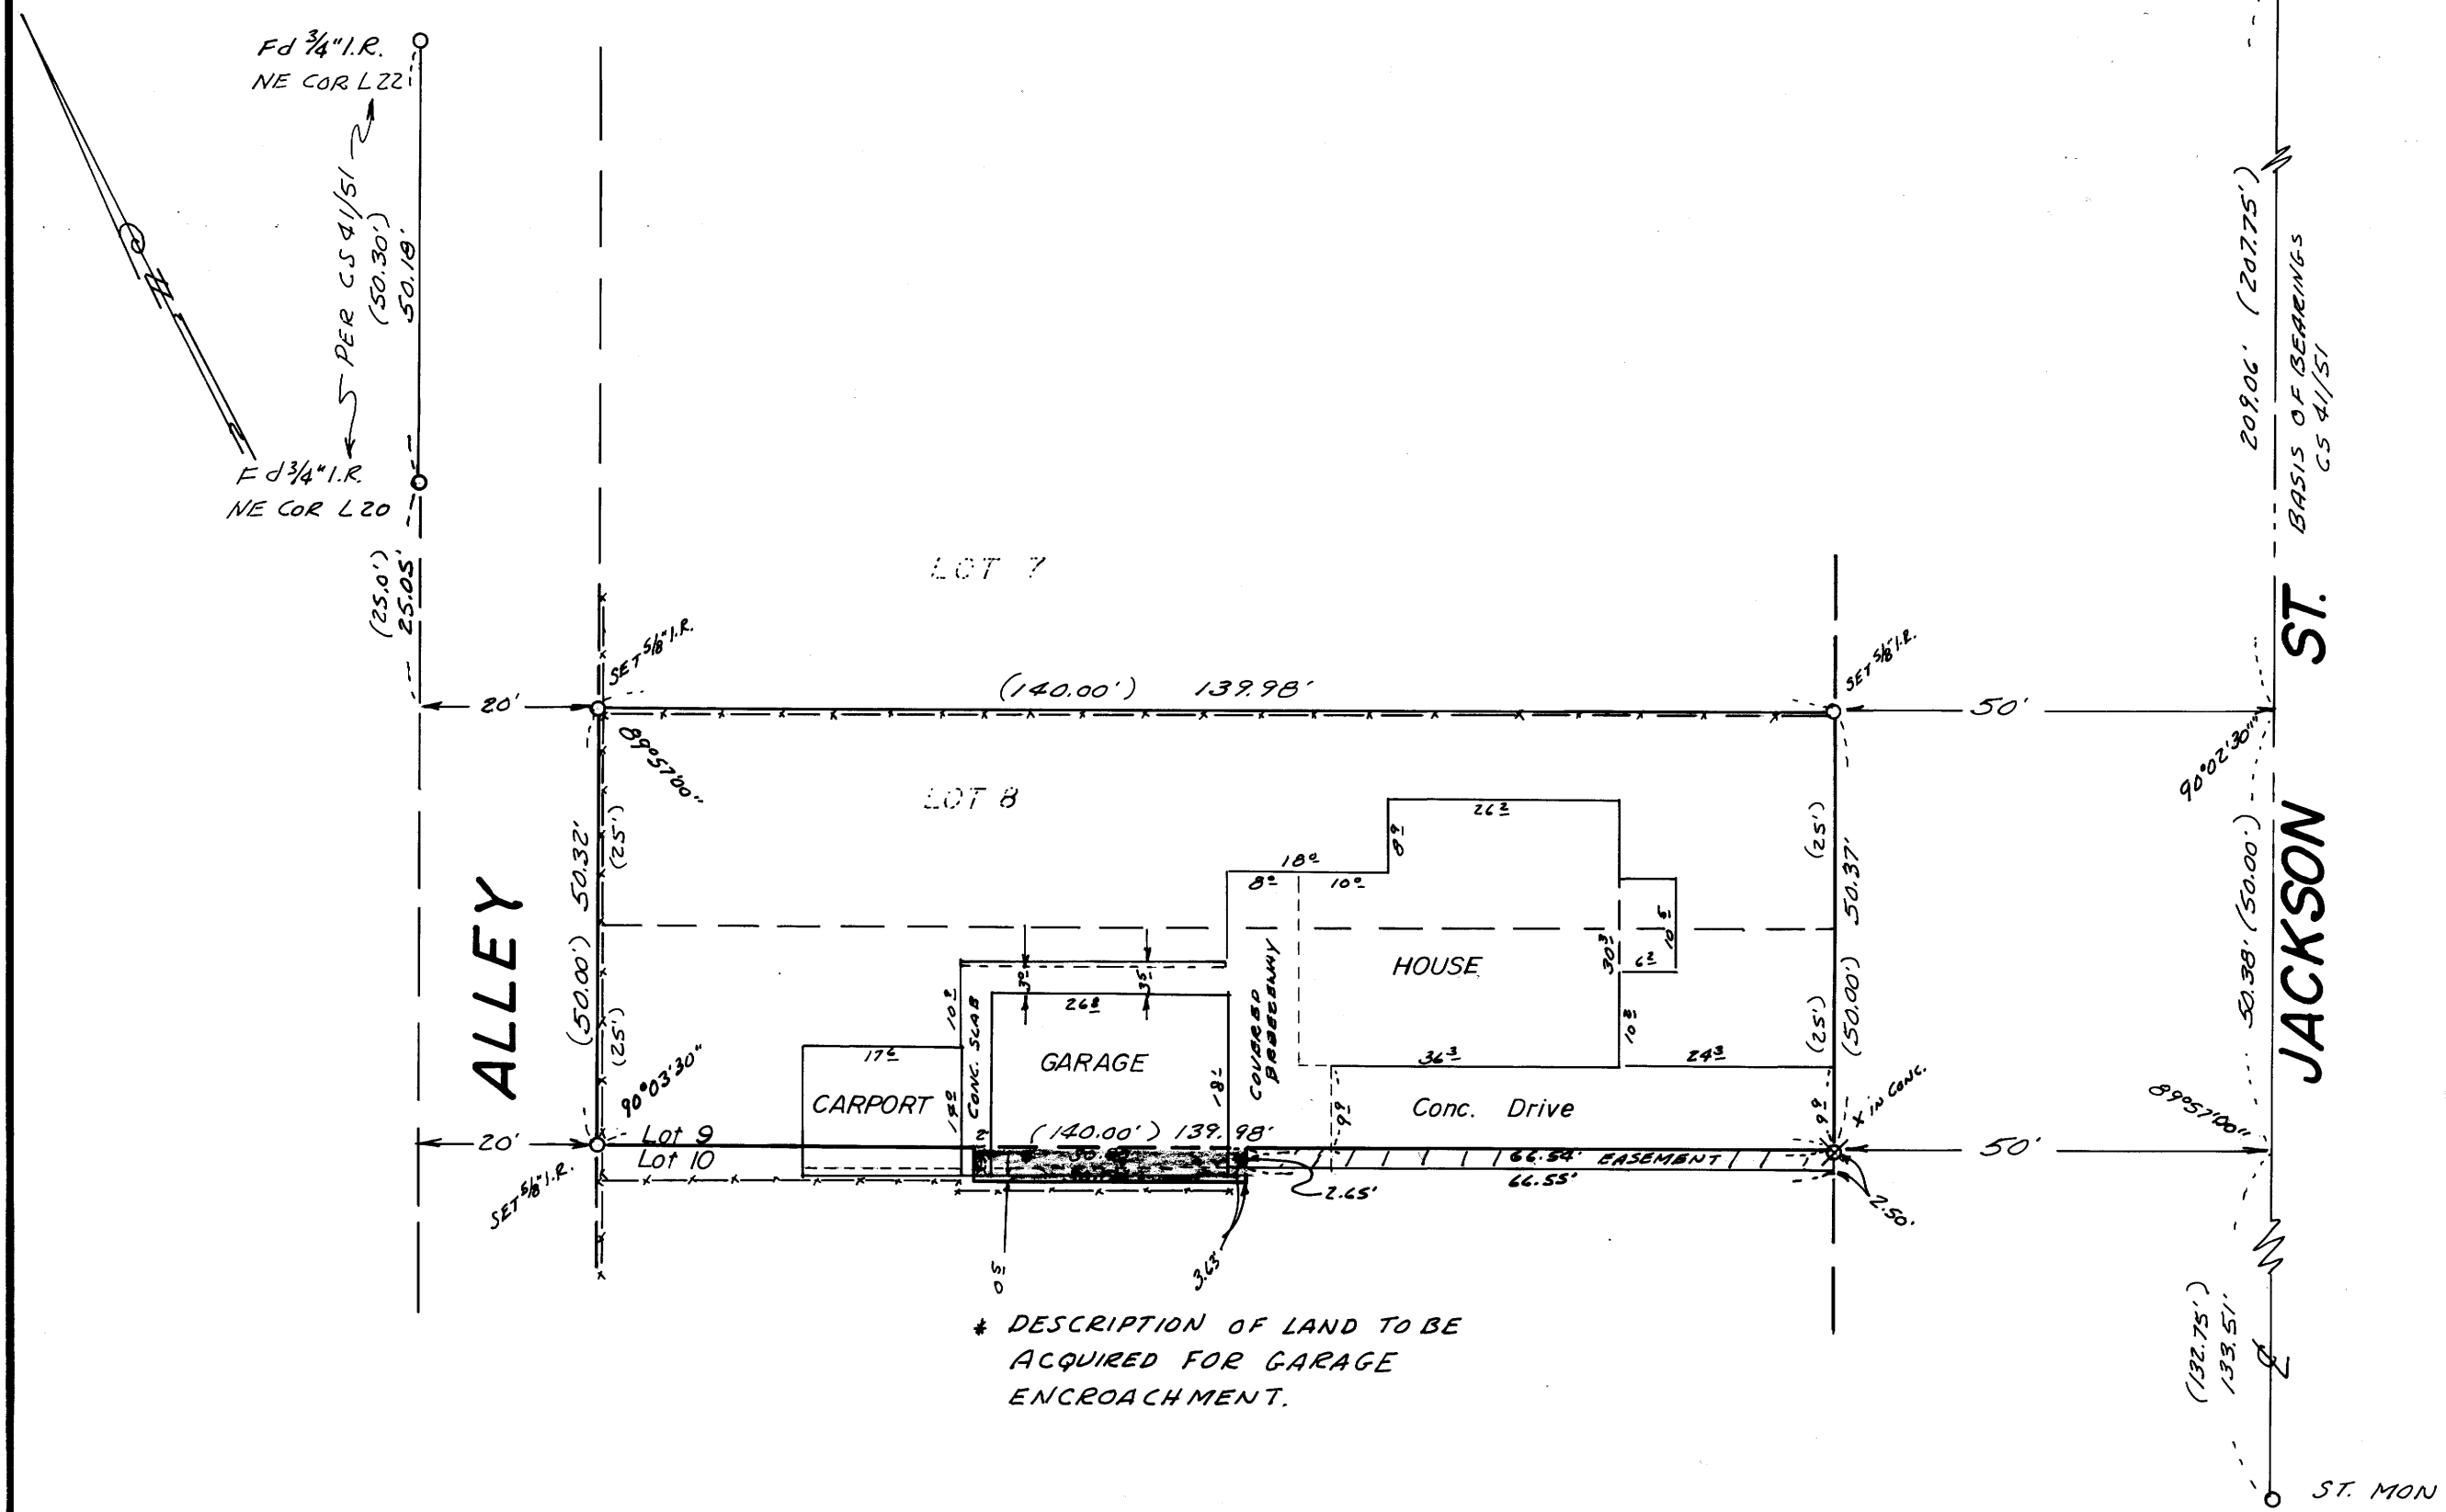

\* DESCRIPTION OF LAND TO BE  
ACQUIRED FOR GARAGE  
ENCROACHMENT.

*Engel*

MAP FILE M60 - 11

MAP FILE M60 - 11