


COUNTY SURVEYORS FILE DATA  
DO NOT REMOVE FROM OFFICE

FILE #  
R/W  
MAY 17 1976  
COUNTY SURVEYOR  
DEPT. OF LAND & FORESTRY, OREGON

PROPERTY LINE SURVEYS IN LOT 2  
PLAT E, ROSEBURG HOME ORCHARD  
TRACTS in NE 1/4, SEC. 32, T26S, R6W,  
W.M.

For: Robert Bathurst  
1249 Cascade Avenue  
Oak Harbor, Washington 98277

By: Shaner Engineering, Inc.  
P.O. Box 1430  
Roseburg, Oregon 97470

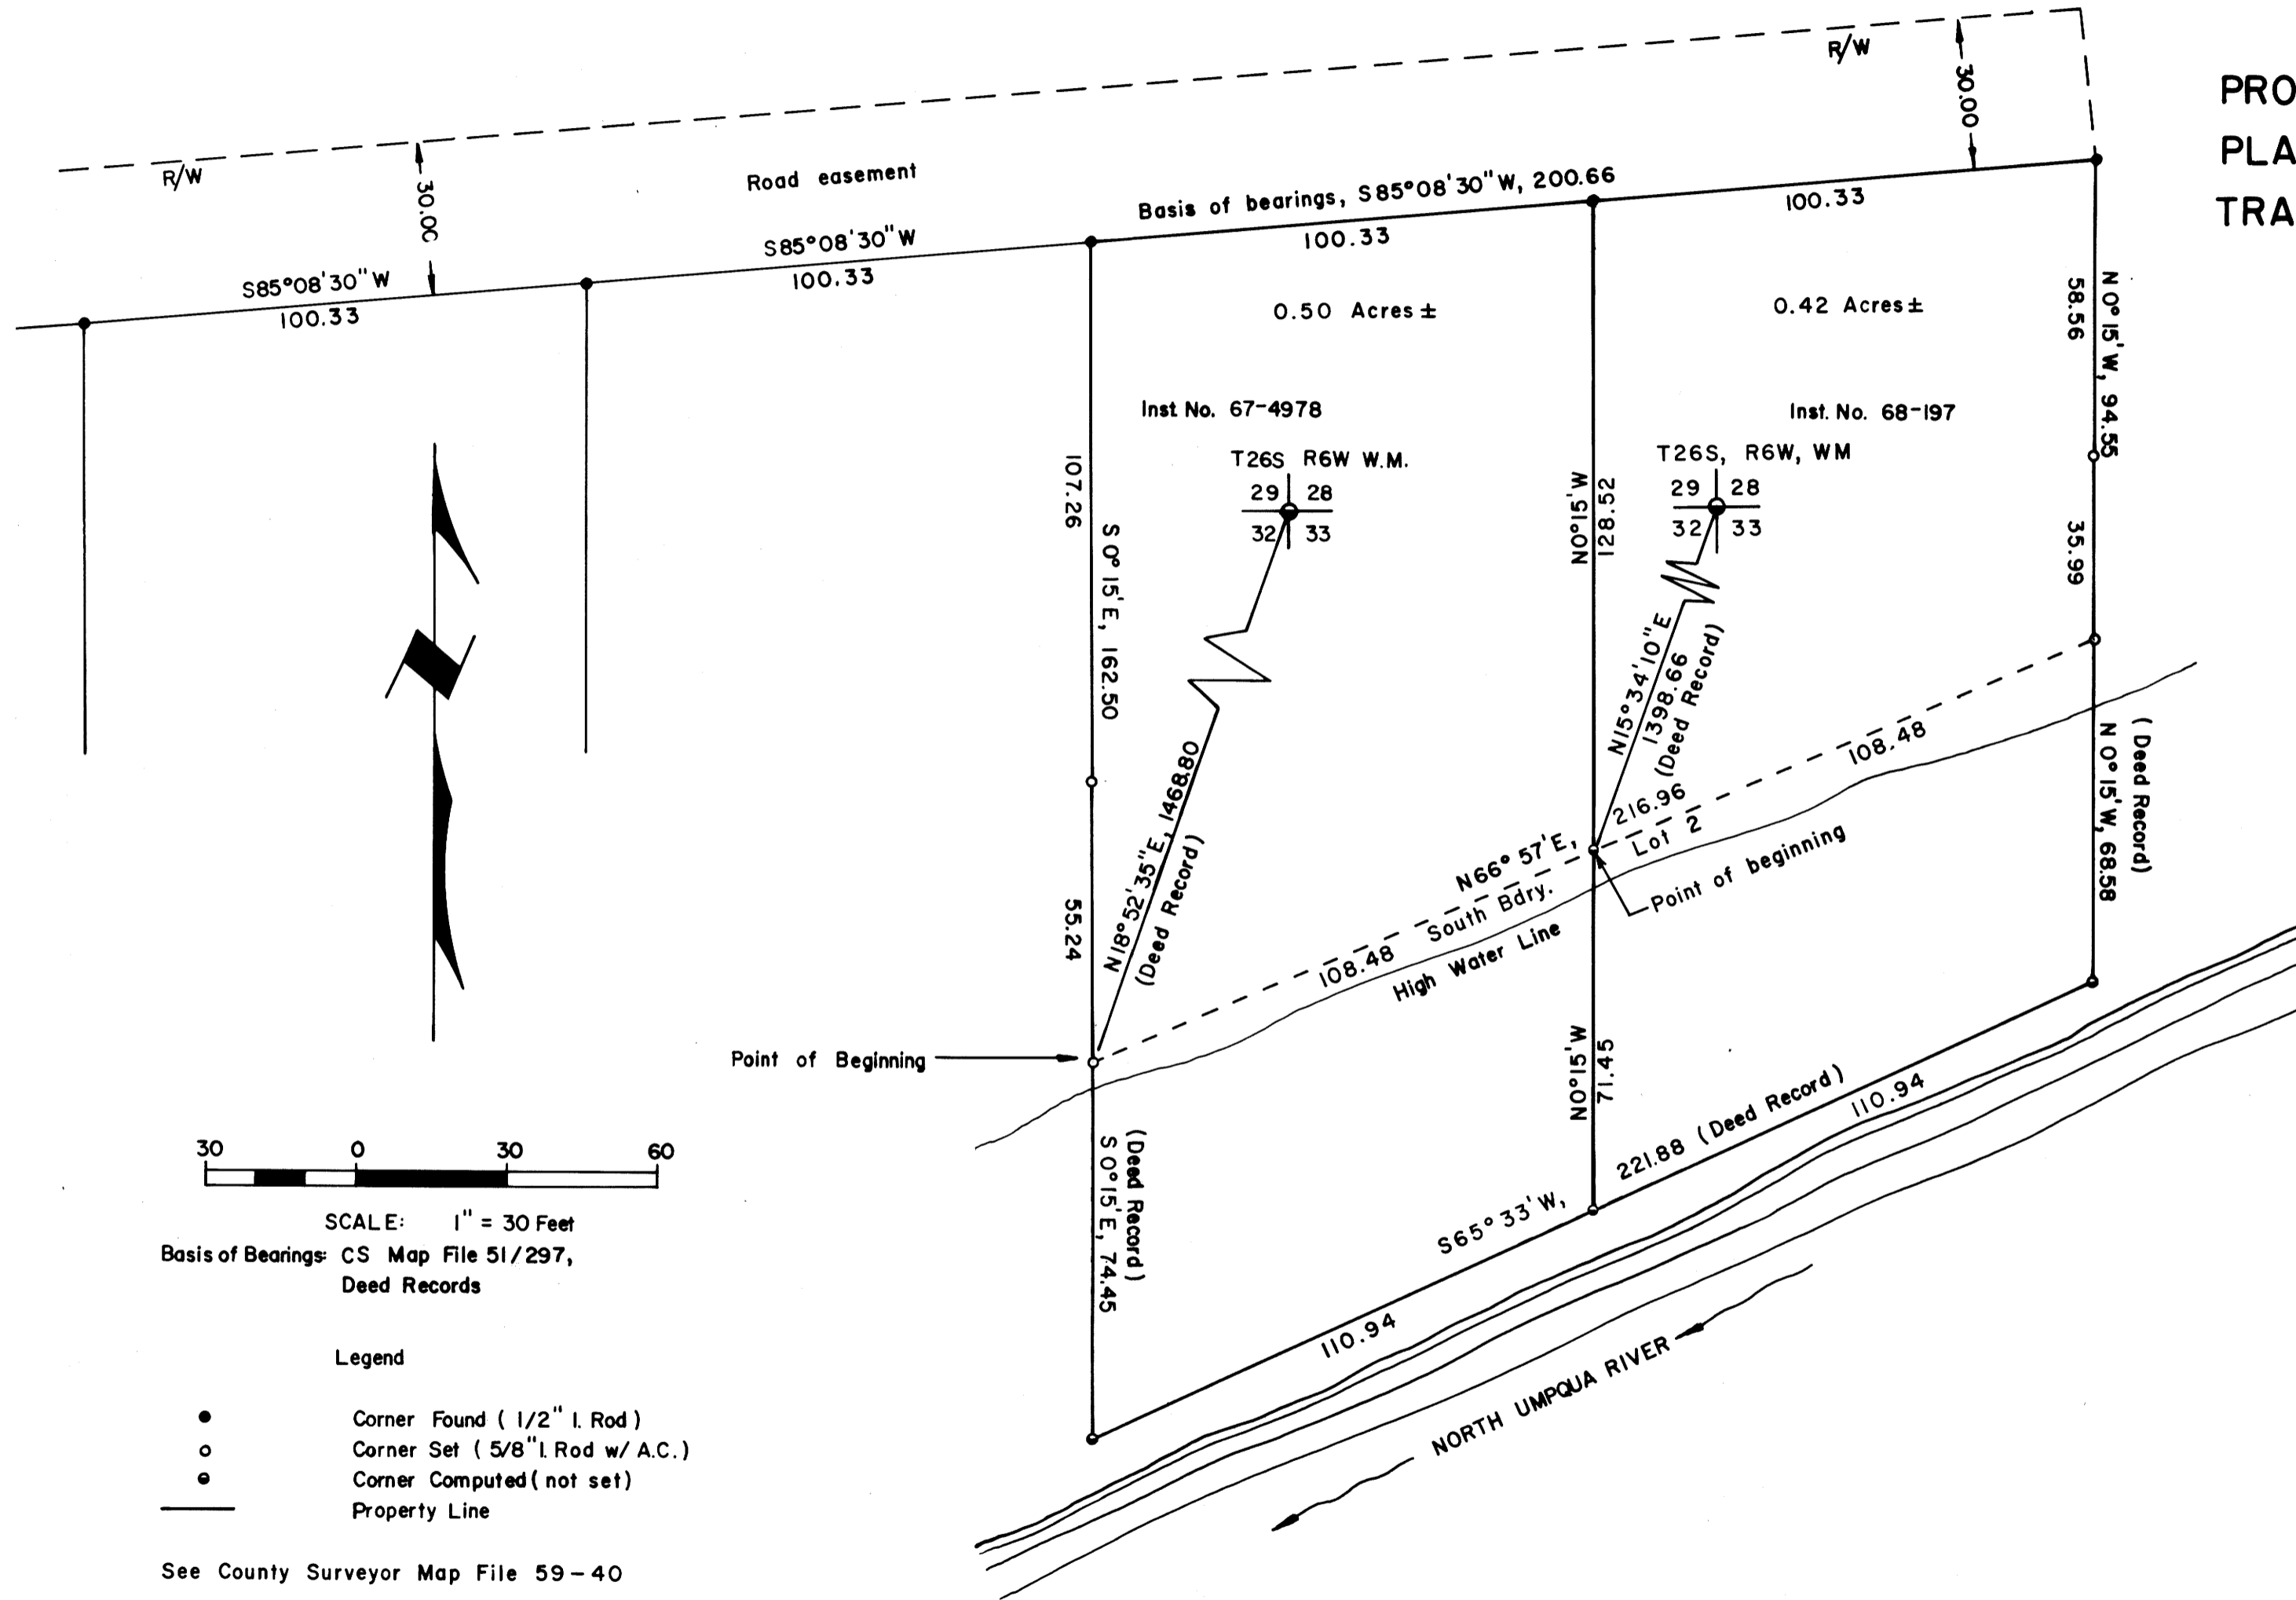


SCALE: 1" = 30 Feet

Basis of Bearings: CS Map File 51/297,  
Deed Records

Legend

- Corner Found ( 1/2" I. Rod )
- Corner Set ( 5/8" I. Rod w/ A.C. )
- Corner Computed ( not set )
- Property Line

See County Surveyor Map File 59-40

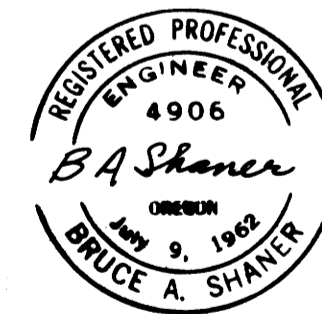

May 17, 1976

MAP FILE M60-17

MAP FILE M60-17