

COUNTY SURVEYORS FILE DATA
DO NOT REMOVE FROM OFFICE

SURVEY TO DETERMINE NORTH LINE OF HOLGATE PROPERTY

IN SECTION 30, T25S, R5W, W.M.


SURVEY FOR E.W. HOLGATE
SURVEY BY BHW ENG. & SURVEYING, INC.
APRIL, 1976 SCALE: 1"=100'

- — DENOTES SET 3/4" I. PIPE
- — DENOTES FD. MONUMENT

REGISTERED
PROFESSIONAL
LAND SURVEYOR

Romano E. Ware

OREGON
NOV. 16, 1973
ROMANSO E. WARE
1005

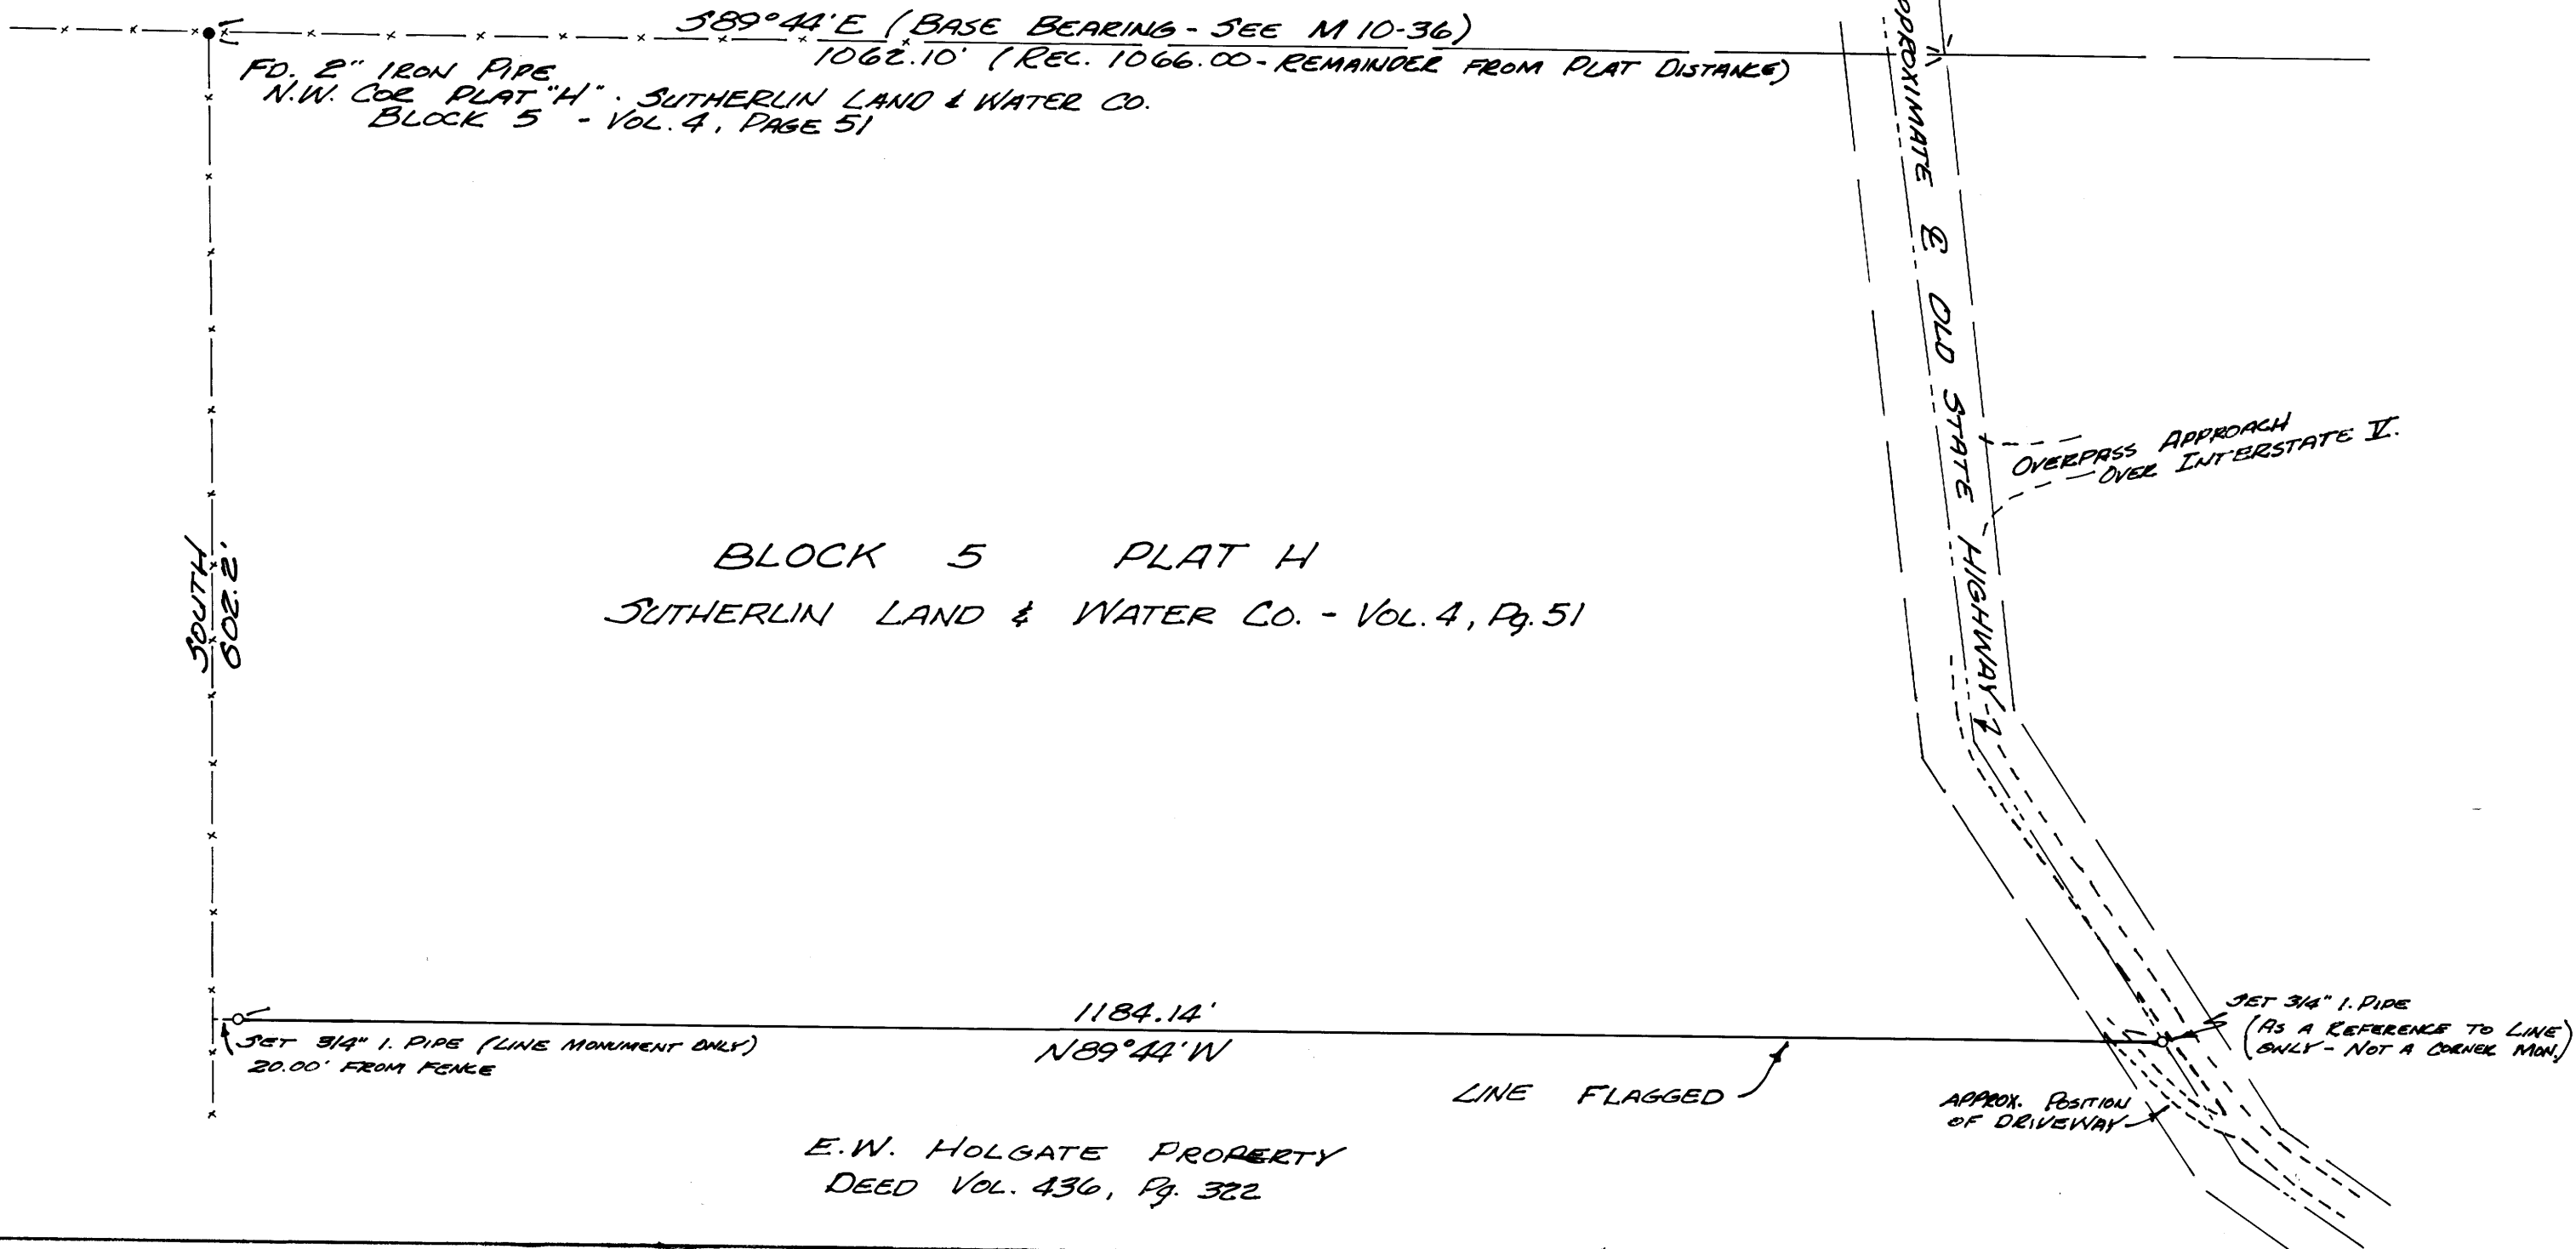

M 60 - 2

M 60 - 2