

SURVEY TO LOCATE PROPERTY CORNERS

IN SECTIONS 13 & 24, T.22S. R.10W.W.M.



FOR: DICK MERTZ

BY: BAUGHMAN SURVEYING SERVICE

SCALE: 1" = 30' JULY 1976

COUNTY SURVEYORS FILE DATA
DO NOT REMOVE FROM OFFICE

FILED
RECEIVED 79
JUL 16 1976
COUNTY SURVEYOR
DOUGLAS COUNTY, ORE.

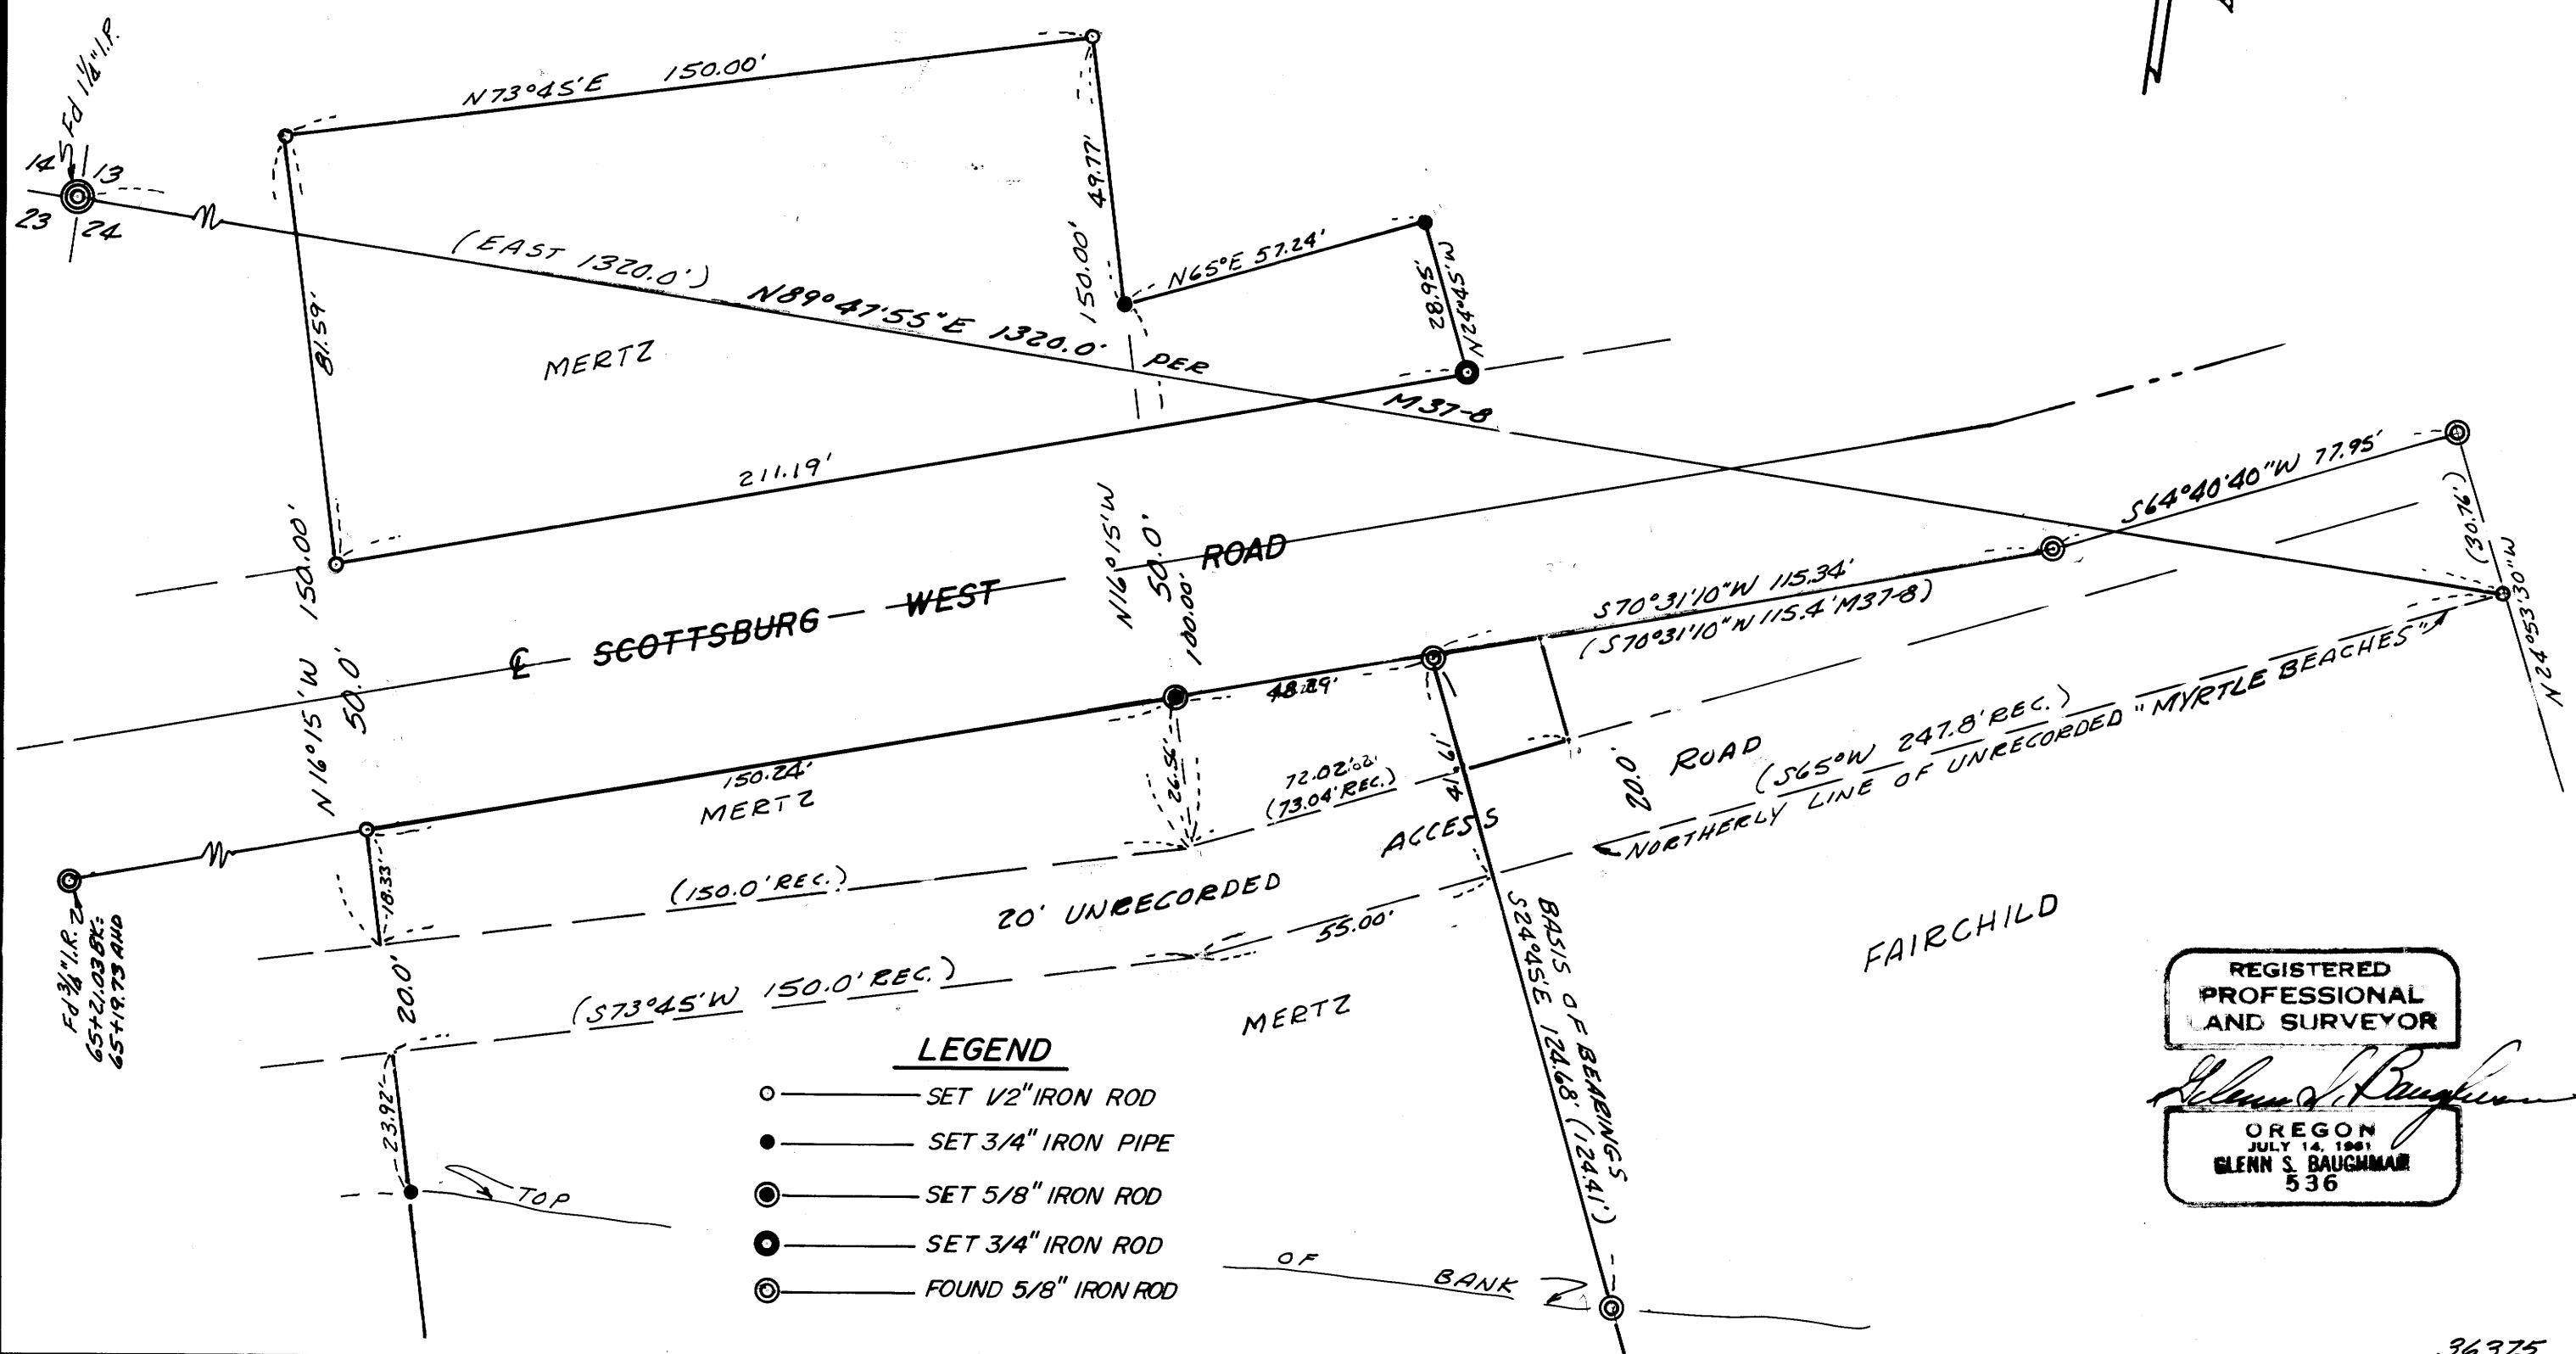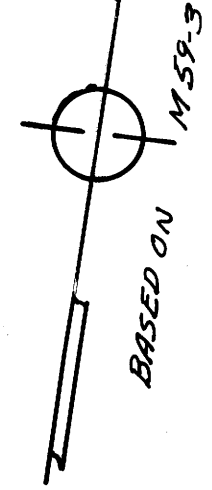

LEGEND

- — SET 1/2" IRON ROD
- — SET 3/4" IRON PIPE
- ⊙ — SET 5/8" IRON ROD
- ⦿ — SET 3/4" IRON ROD
- ⊗ — FOUND 5/8" IRON ROD

REGISTERED
PROFESSIONAL
LAND SURVEYOR

Glenn S. Baughman

OREGON
JULY 14, 1961
GLENN S. BAUGHMAN
536

36375

MAP FILE M 60 - 79

MAP FILE M 60 - 79