

SURVEY FOR DESCRIPTION IN LOT 2, SECOND BROOKSIDE ADDITION SECTION 20, T.27S.R.5W.W.M.

FOR: H.R. HEDQUIST
BY: BAUGHMAN SURVEYING SERVICE


COUNTY SURVEYORS FILE DATA
DO NOT REMOVE FROM OFFICE

FILED *v*
RECEIVED *24*
MAY 7 1976

COUNTY SURVEYOR
DOUGLAS COUNTY, ORE.

APRIL 1976

SCALE: 1"=50'

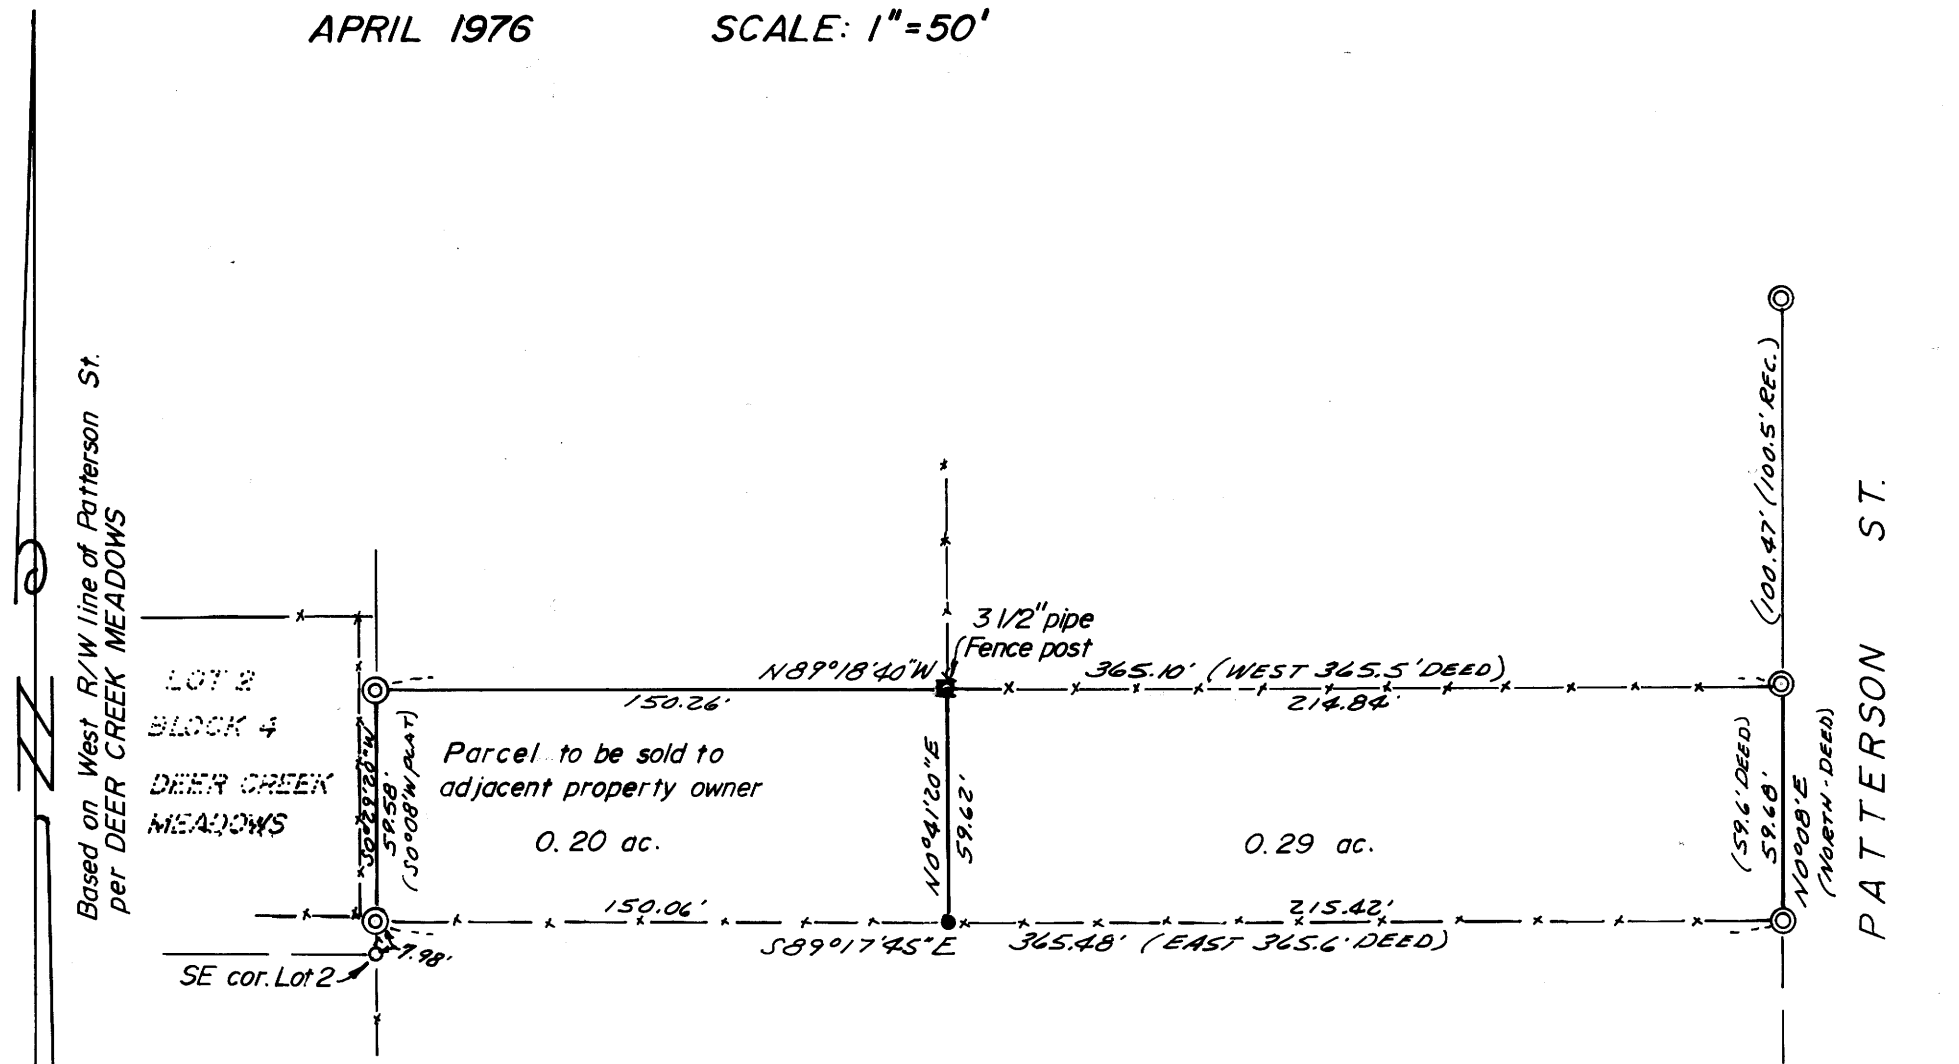

LEGEND

- — Set 5/8" iron rod
- — Found 1/2" iron pipe
- ⊙ — Found 1" iron pipe

Eugene Bloom

MAP FILE M.60 - 9

MAP FILE M.60 - 9