

# SURVEY FOR DESCRIPTION

IN LOT 35 PLAT H, ROSEBURG HOME ORCHARD TRACTS  
SECTION 10, TOWNSHIP 28 SOUTH, RANGE 6 WEST, W.M.

FOR: MERL AUSTIN

BY: BAUGHMAN SURVEYING SERVICE

JULY 1976

SCALE: 1"=100'

COUNTY SURVEYORS FILE DATA  
DO NOT REMOVE FROM OFFICE


FILED  
RECEIVED *ALS*

AUG 3 1976

COUNTY SURVEYOR  
DOUGLAS COUNTY, ORE.

LOT 6

BASIS OF BEARINGS  
(N89°31'W 3300.0' PLAT)  
N89°31'W 3298.89'

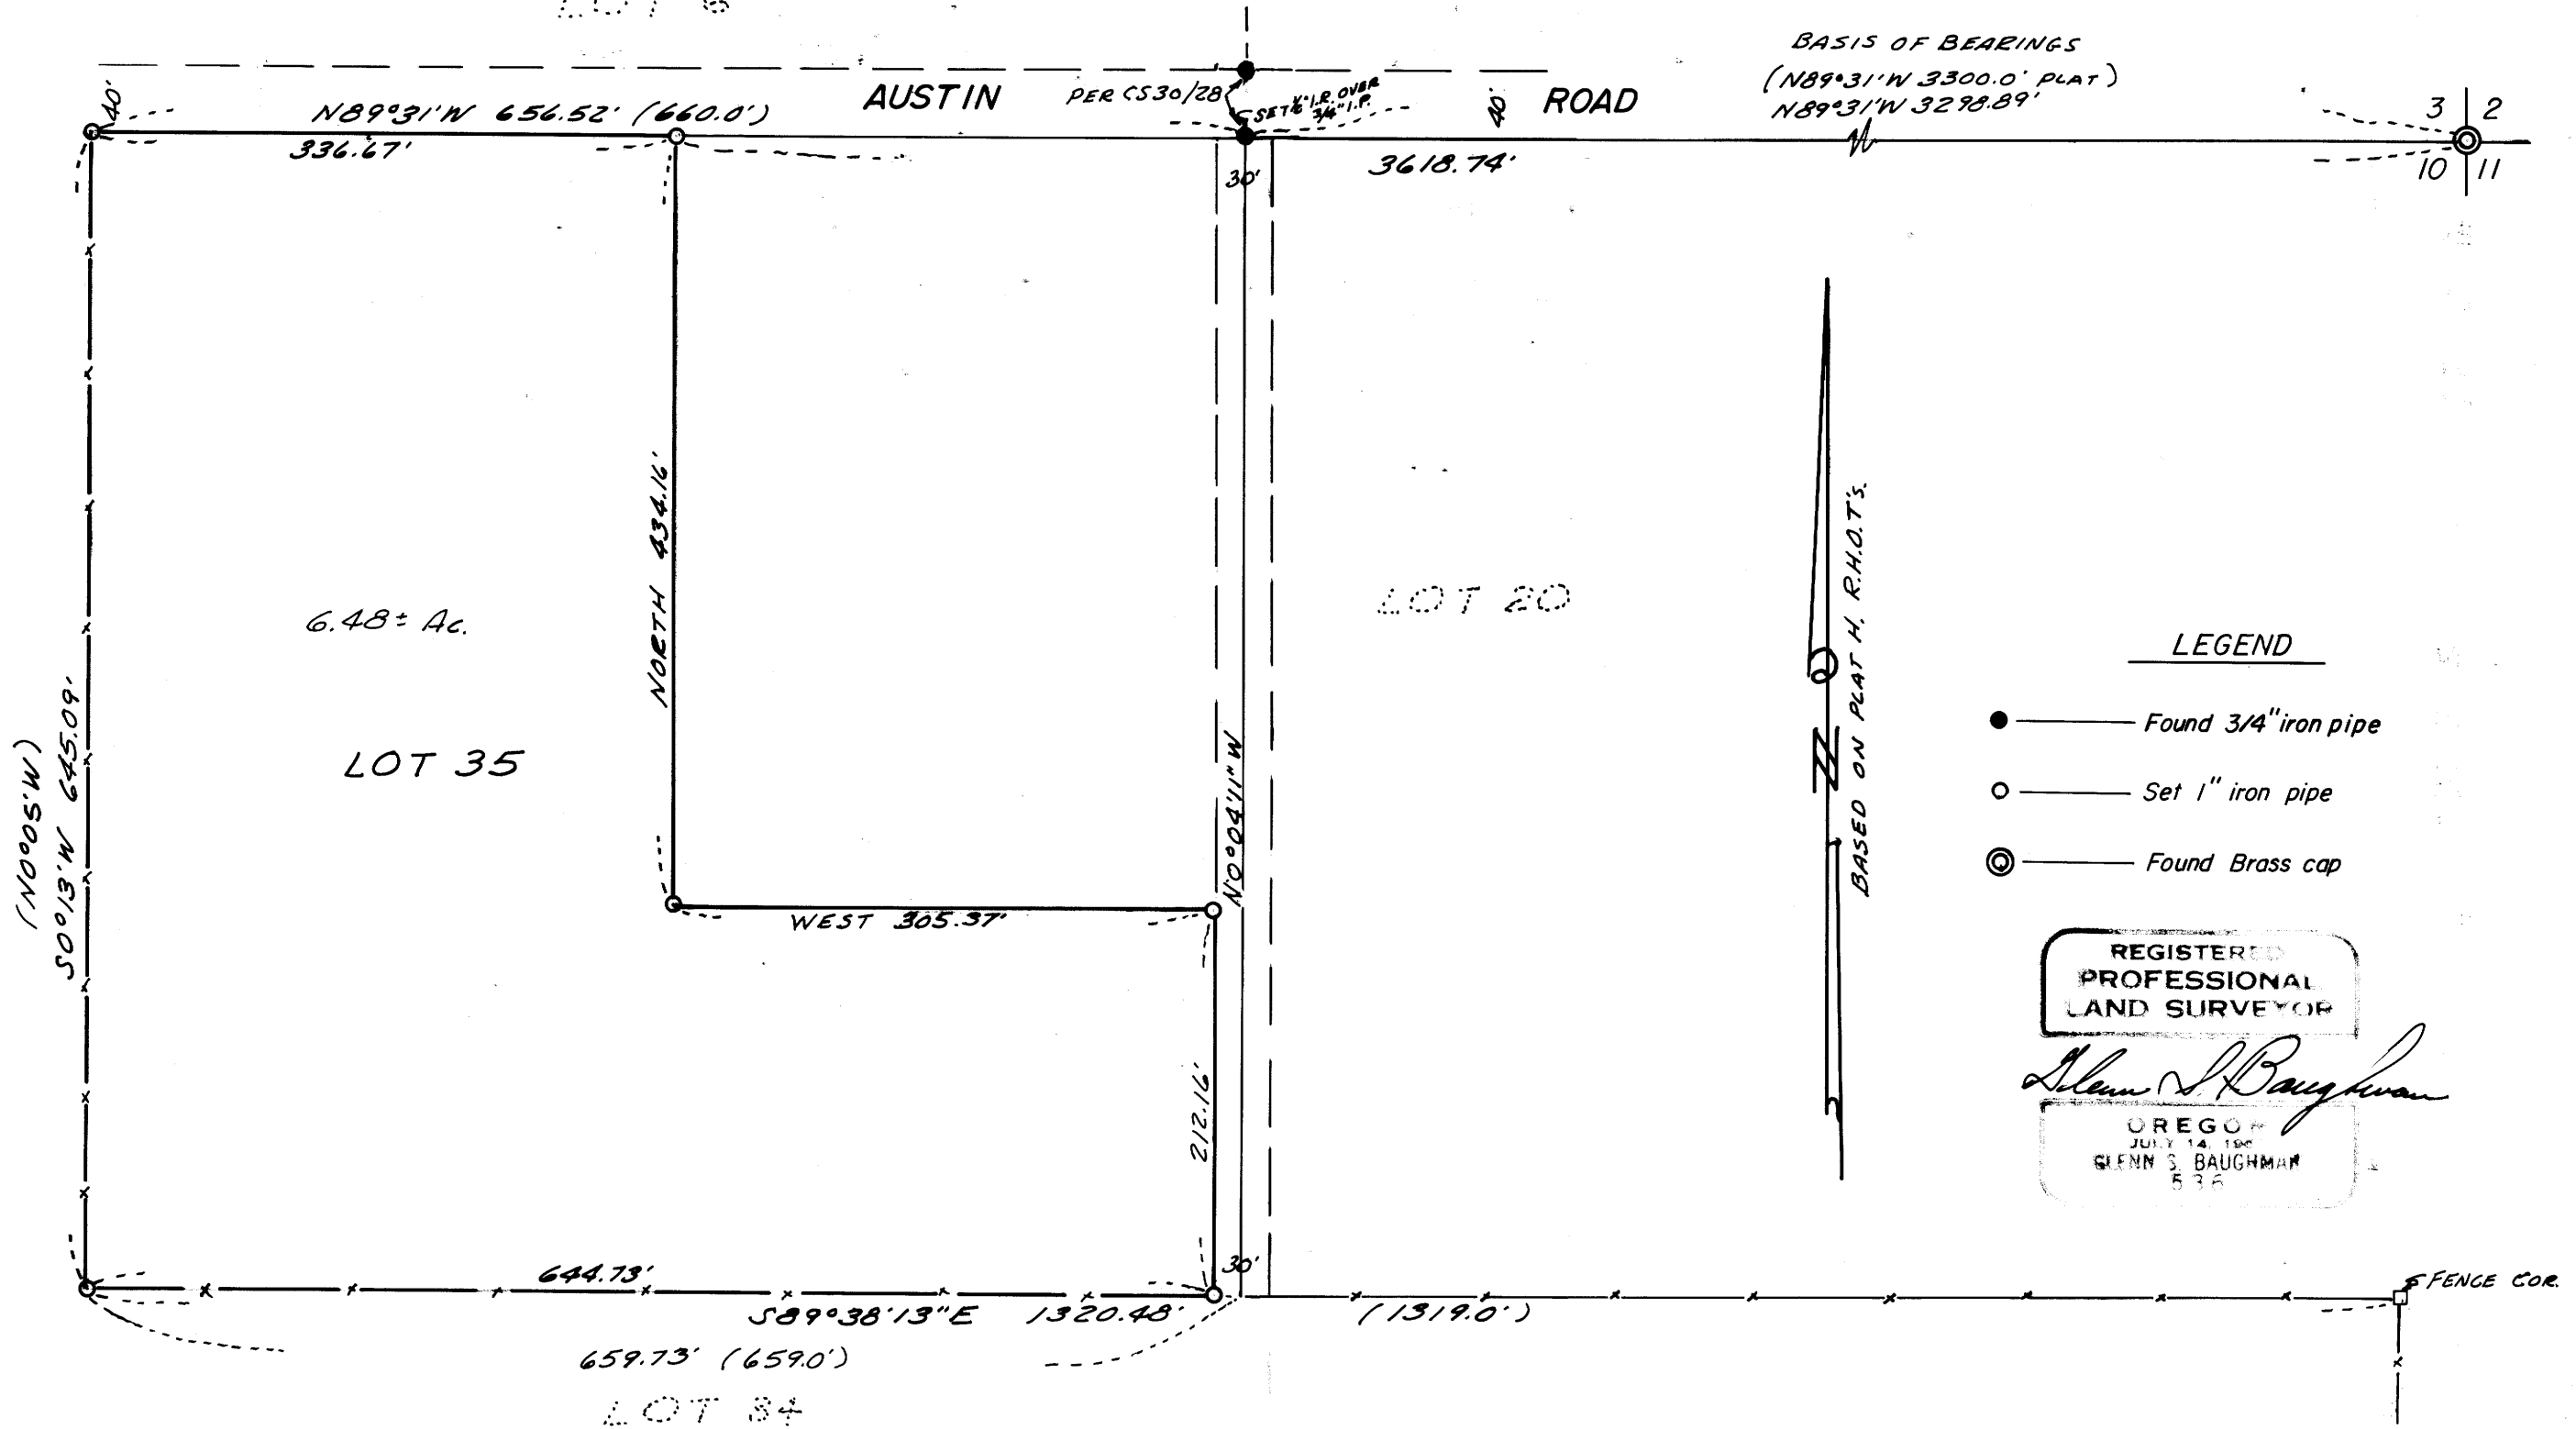

36401

MAP FILE M61-11

MAP FILE M61-11