

COUNTY SURVEYORS FILE DATA  
DO NOT REMOVE FROM OFFICE


SURVEY IN SEC. 34, T 22 S, R 5 W. W.M.

SURVEYED FOR - REX APPLIGATE  
SURVEYED BY - W.S. BARNES

SEPT. 1976

FILED  
RECEIVED

COUNTY SURVEYOR  
DEWAS COUNTY, ORE.

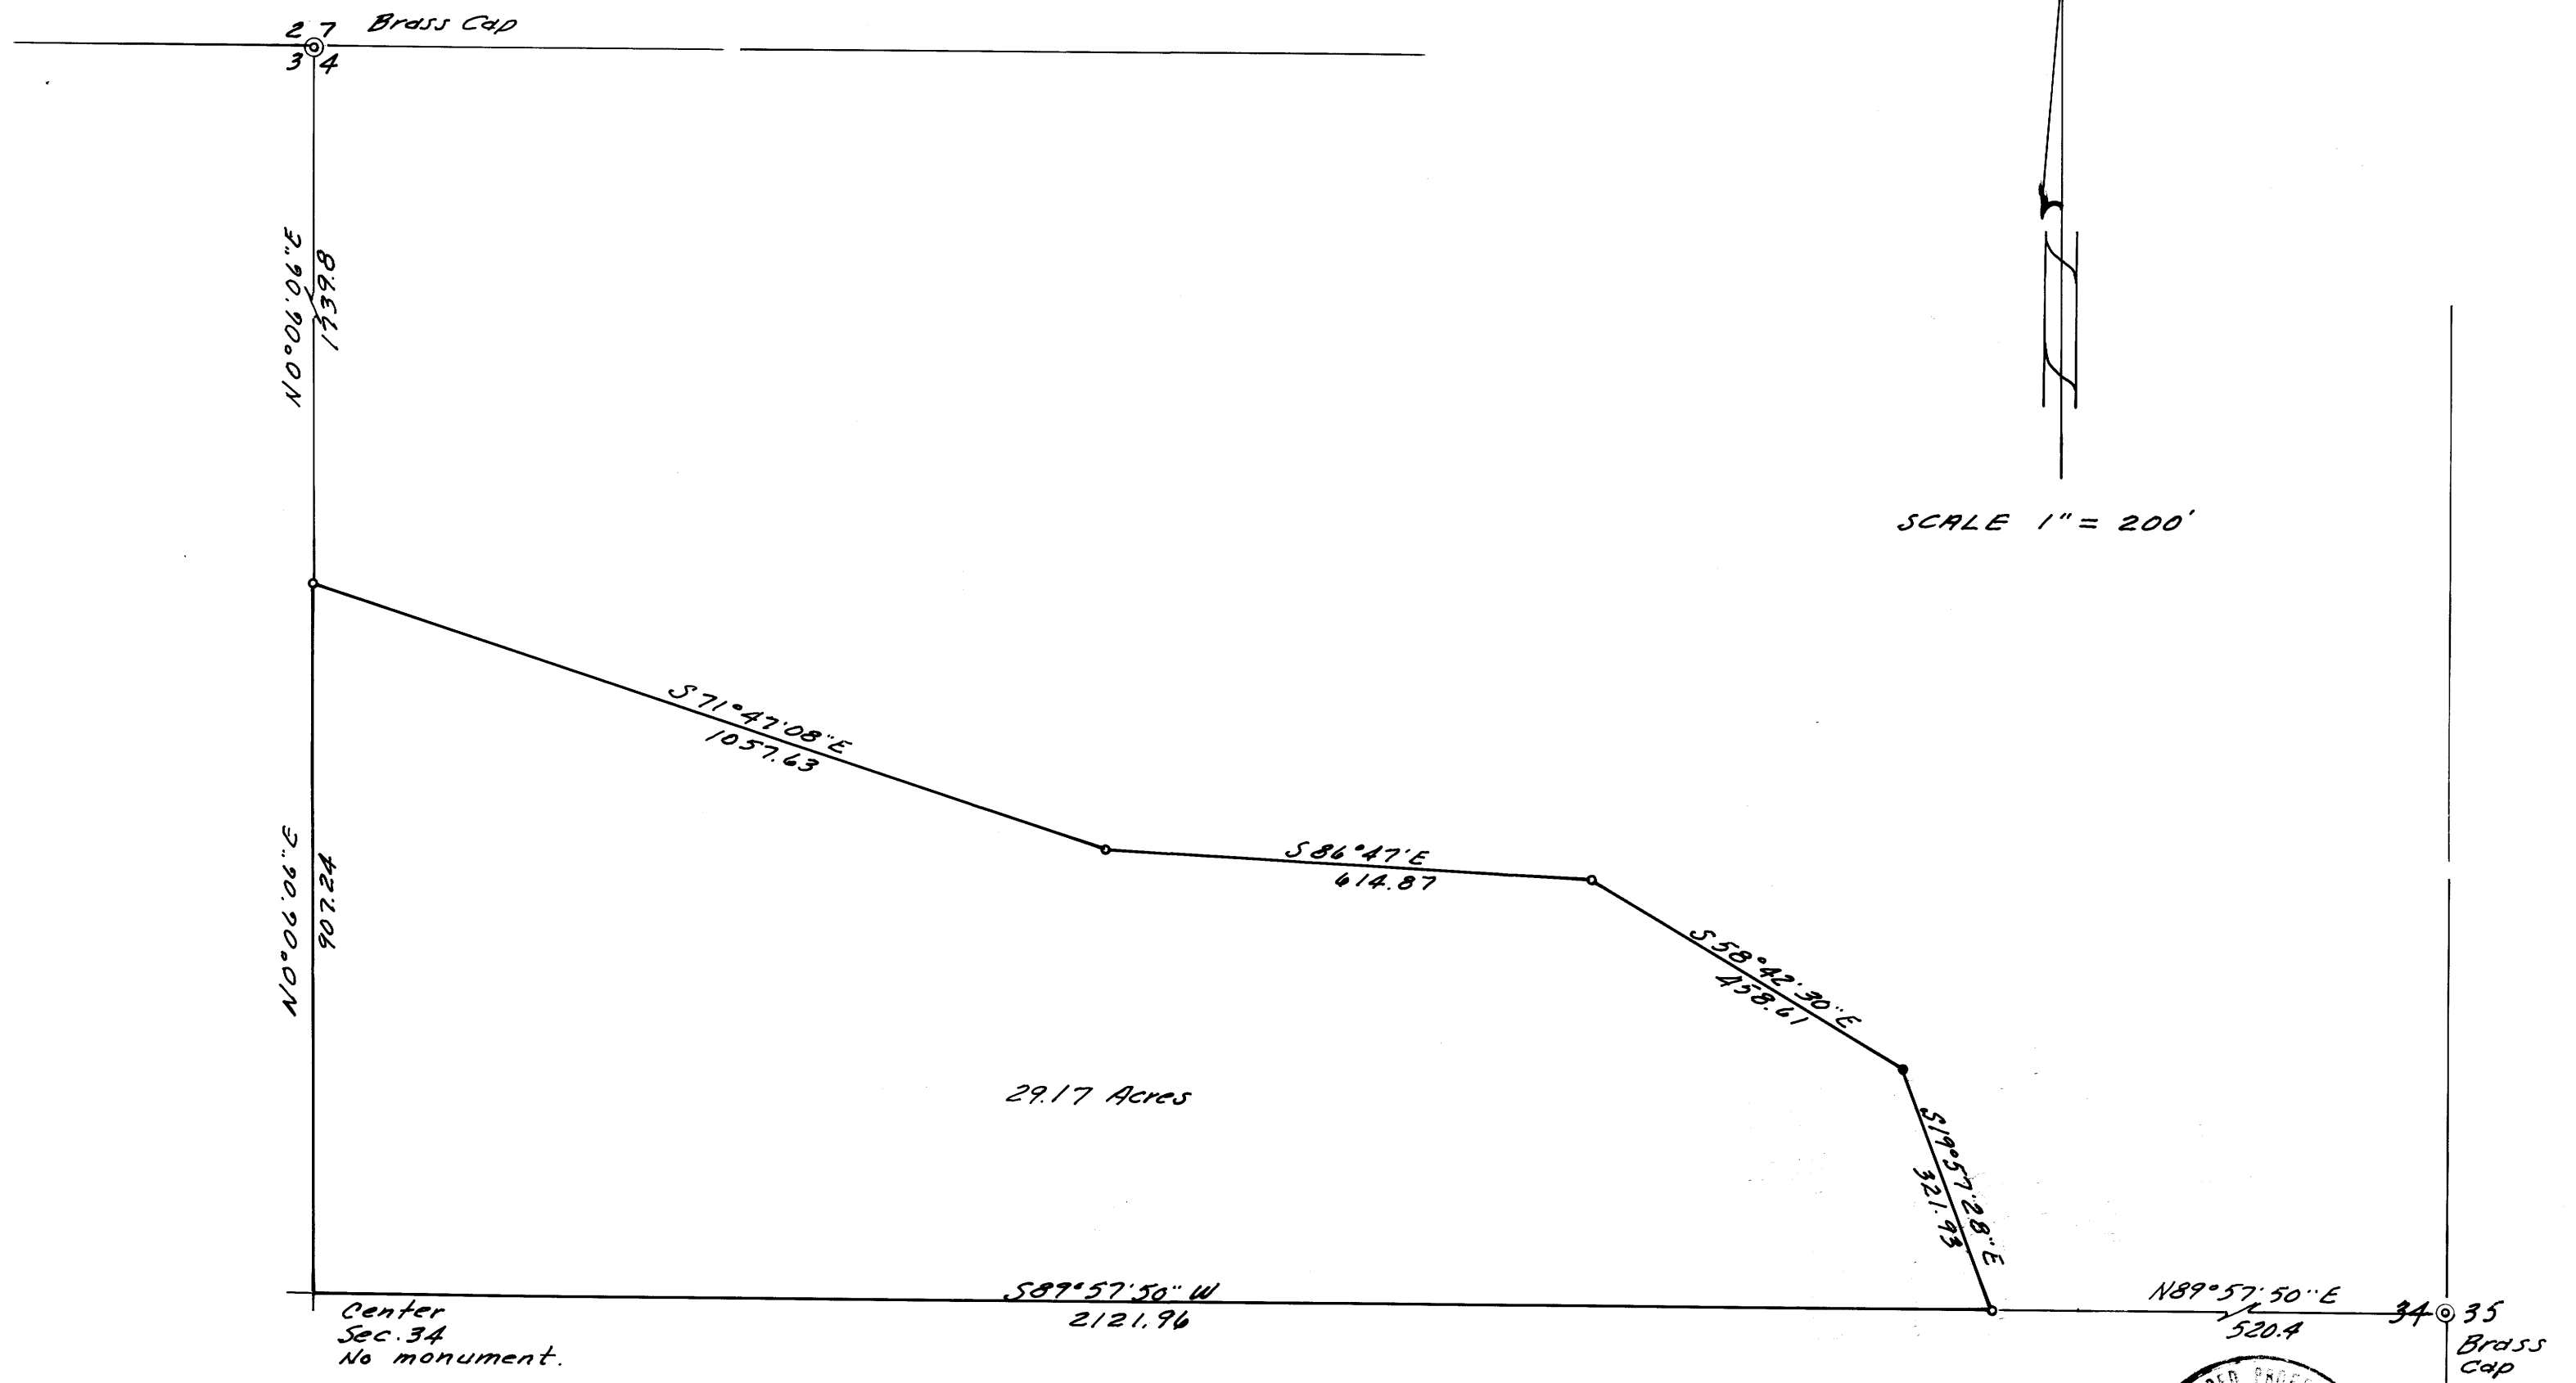

SCALE 1" = 200'

29.17 Acres

Center  
Sec. 34  
No monument.

34 35  
Brass  
Cap

- 5/8" iron rods set.
- Base bearing taken from E-W  $\frac{1}{2}$  Sec. 34
- Refr. - C.S. File - ~~537~~ M-53-75



FILE M 61-59

FILE M 61-59