



SURVEY TO ESTABLISH ONE - SIXTEENTH CORNERS  
 IN SECTION 34 T 29 S R 8 W. W.M.  
 FOR SUN STUDS INC.  
 BY BURTON W. HOLT  
 SEPTEMBER, 1976 1" = 200'

COUNTY SURVEYORS FILE DATA  
 DO NOT REMOVE FROM OFFICE

FILED  
 RECEIVED  
 OCT 19 1976  
 COUNTY SURVEYOR  
 DOUGLAS COUNTY, ORE.

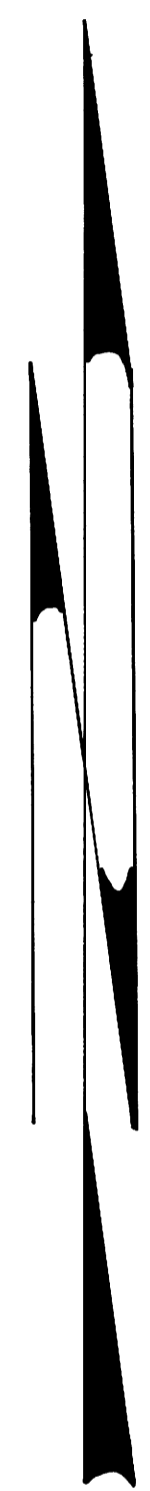

BASED ON  
 SOLAR OBSERVATION  
 AUG 31- 1976

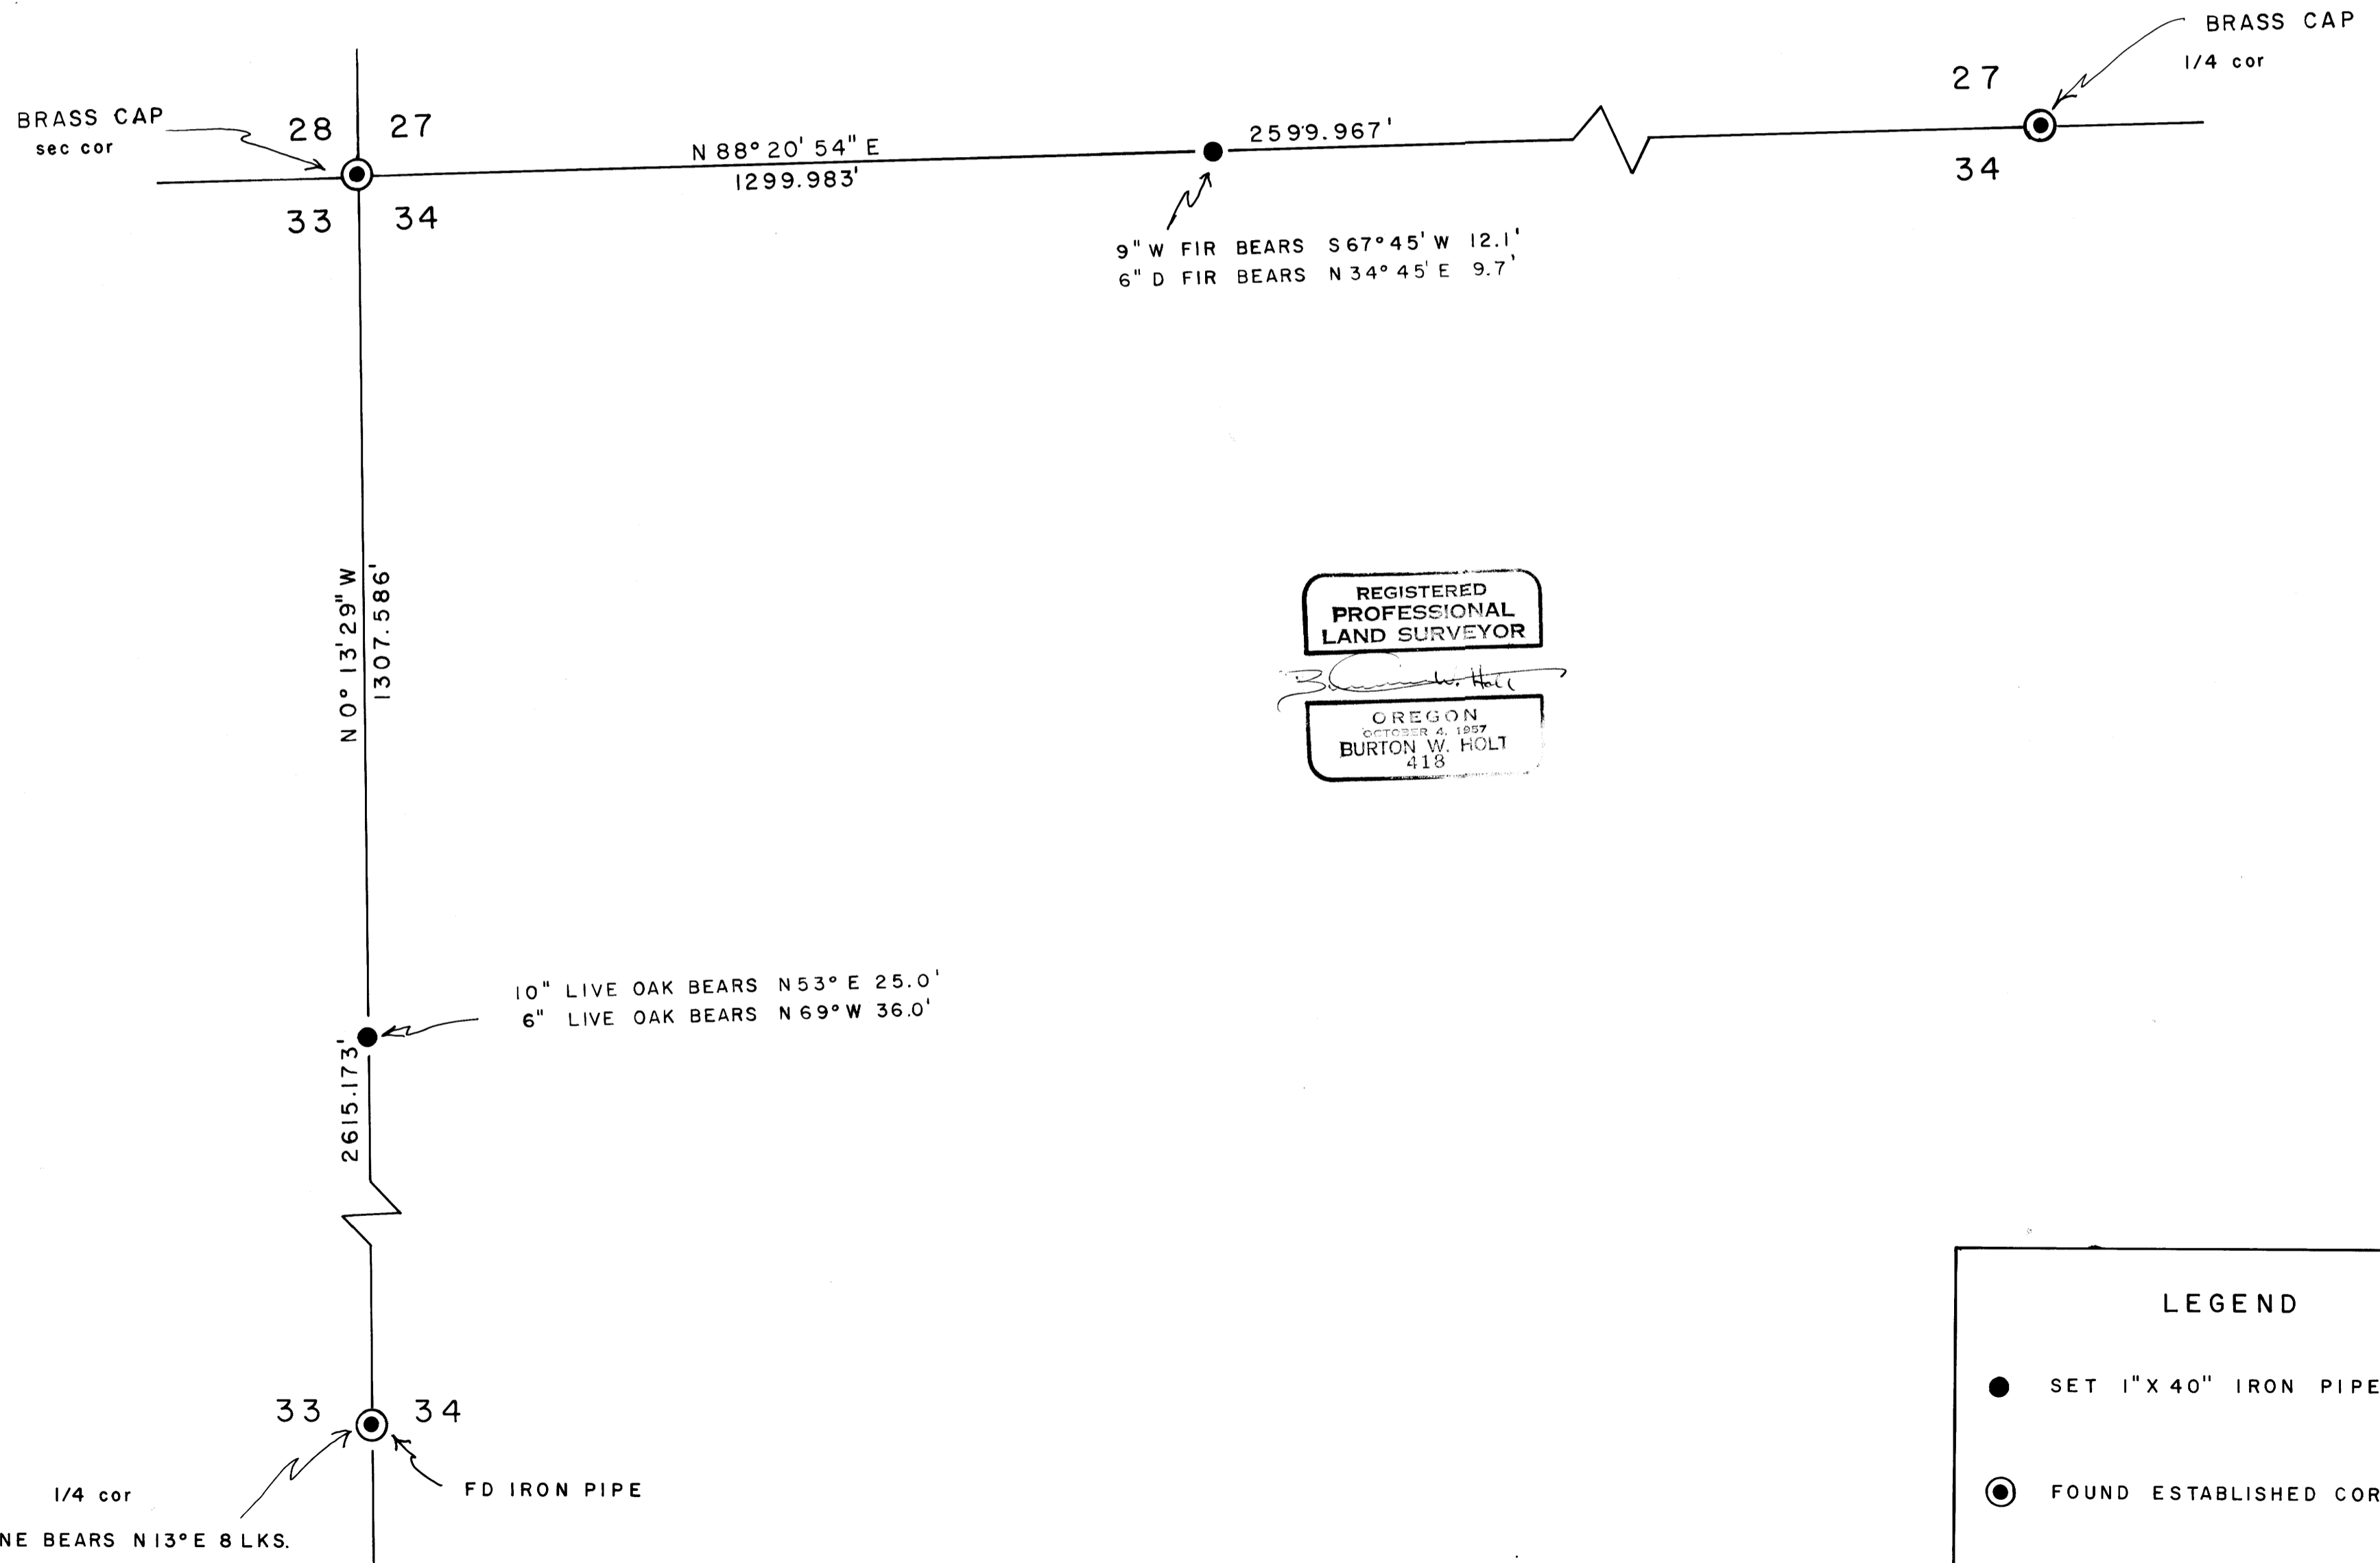

LEGEND

- SET 1" X 40" IRON PIPE
- ⊙ FOUND ESTABLISHED CORNERS

MAP FILE M.61-28

MAP FILE M.61-28