

SURVEY TO SET PROPERTY CORNERS IN PLAT "A" DEER CREEK ORCHARD TRACTS-SEC. 23, T.27S. R.5W.W.M.

FOR: HENRY GREGORY — BY: C & G ENG., INC.

OCTOBER 1976

SCALE: 1" = 100'

COUNTY SURVEYORS FILE DATA
DO NOT REMOVE FROM OFFICE

FILED ✓
RECEIVED *ry*


NOV 9 1976

COUNTY SURVEYOR
DOUGLAS COUNTY, ORE.

T. 275

~~T. 23S.~~ R. 5W.W.M.

MAP FILE M.62-13

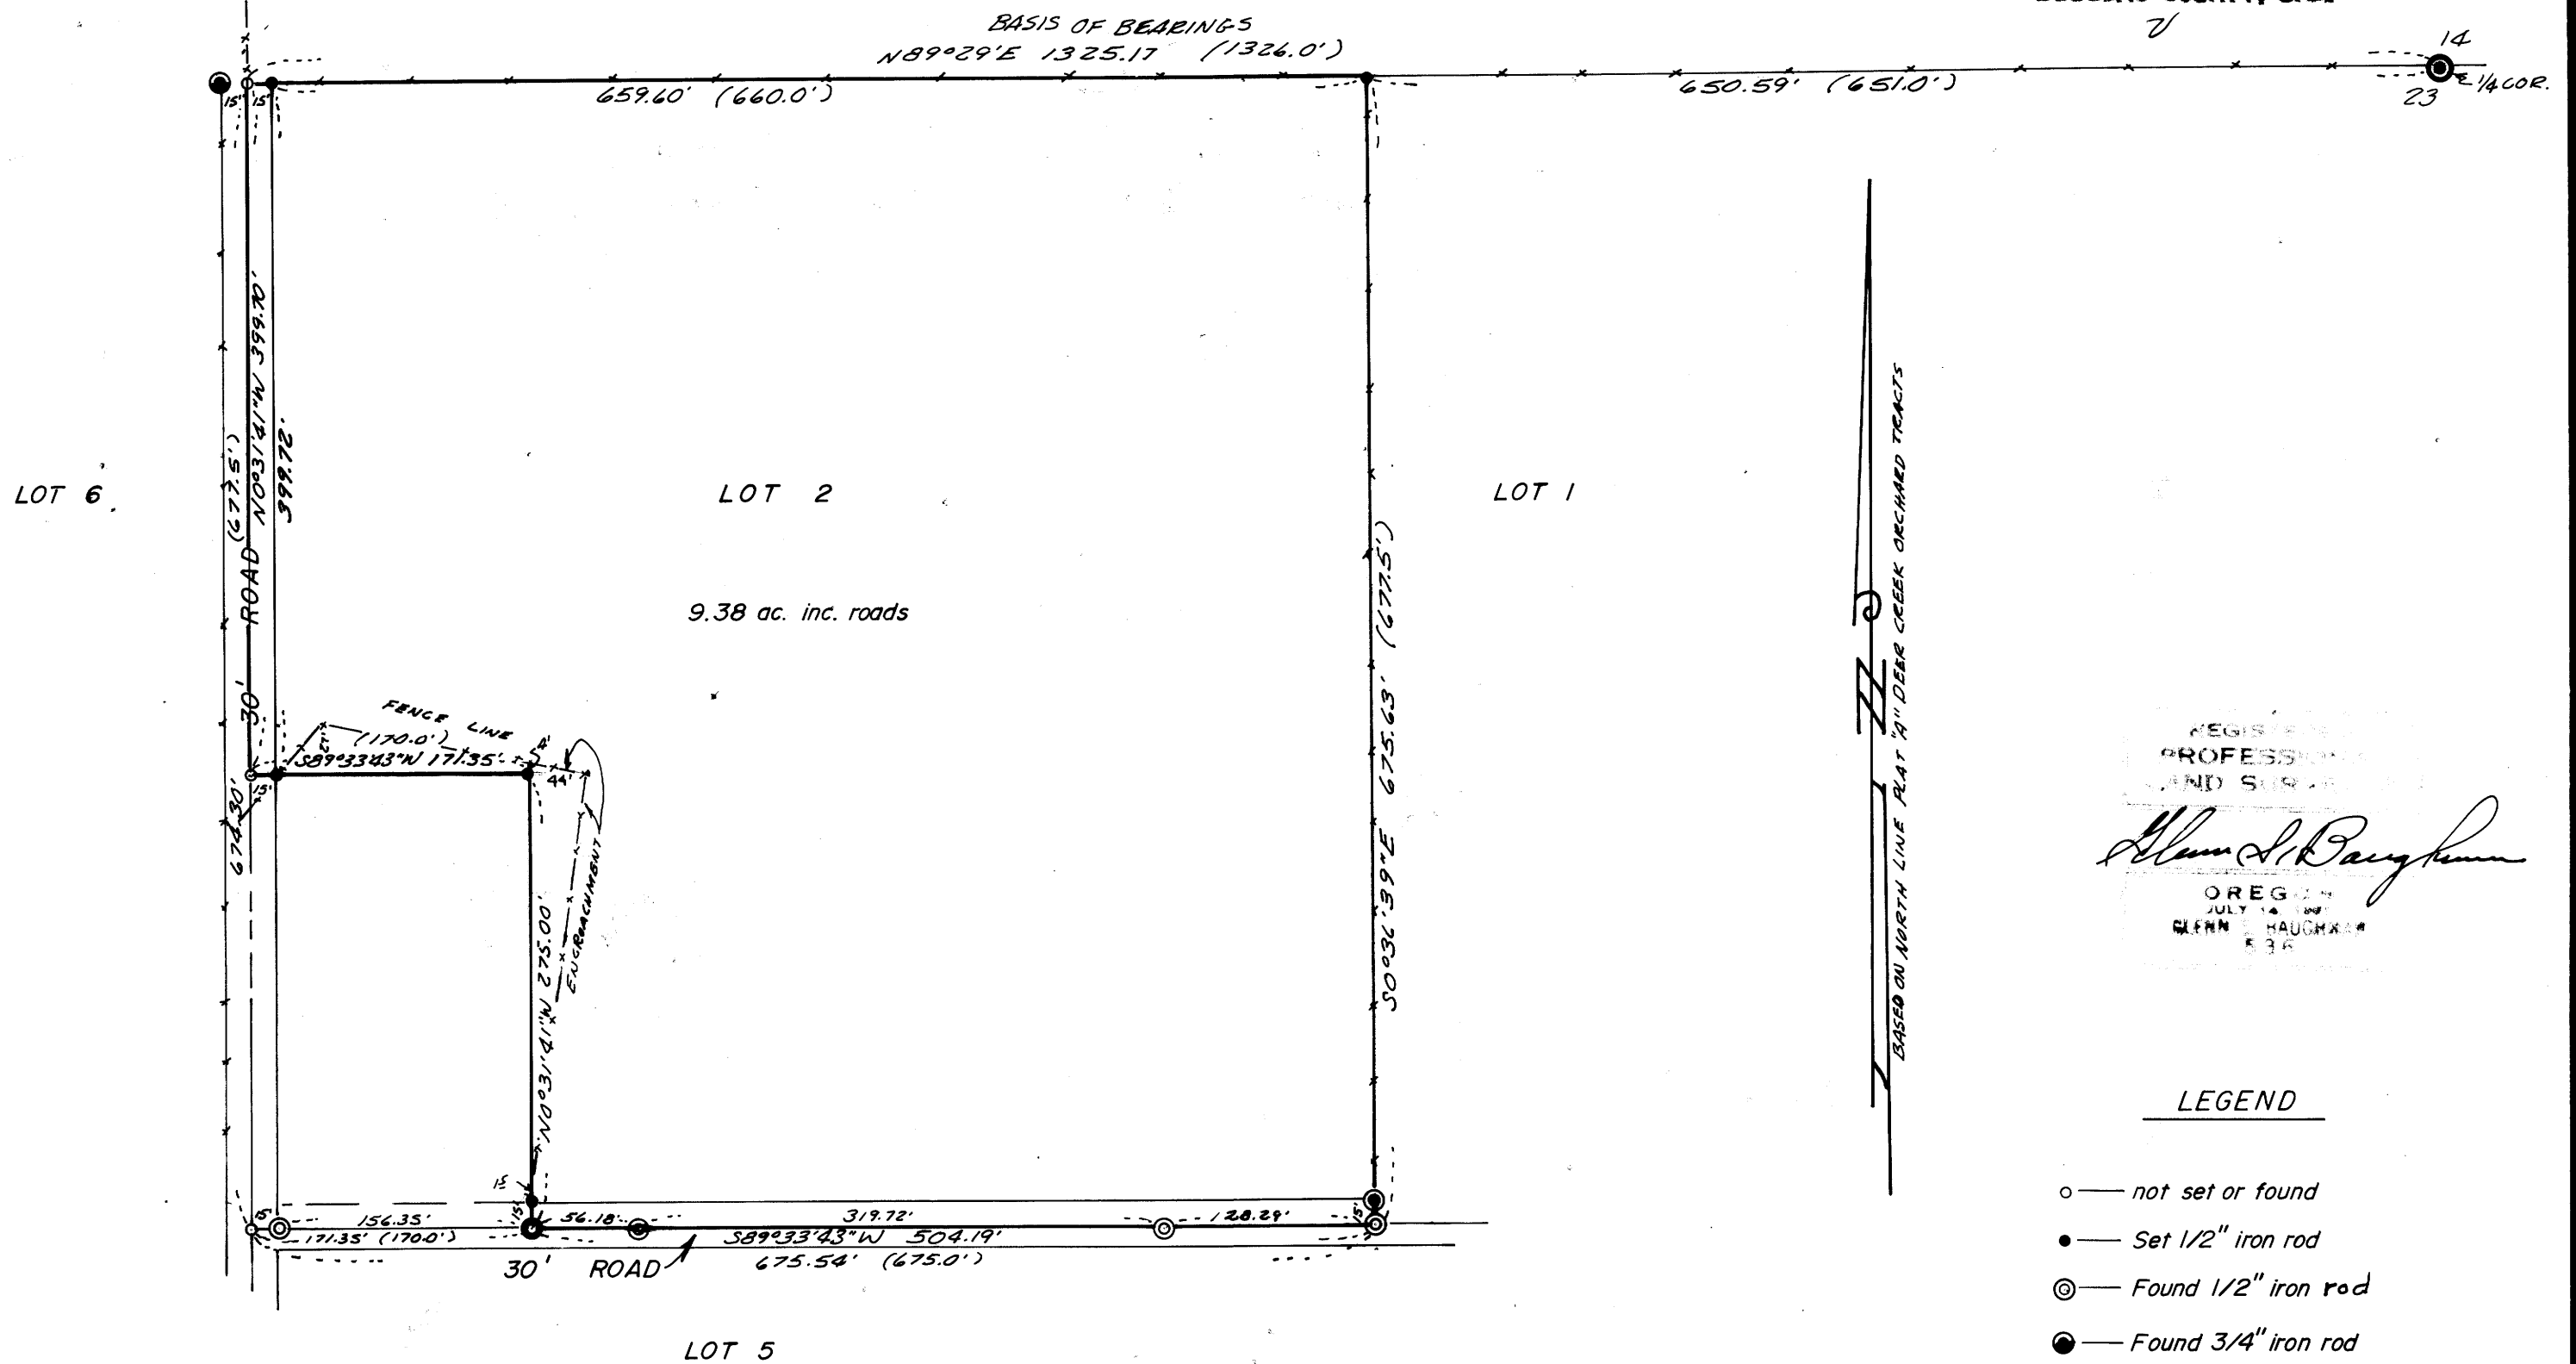

REGISTERED
PROFESSIONAL
LAND SURVEYOR

Glenn S. Haugman

OREGON
JULY 14 1964
GLENN S. HAUGMAN
538

LEGEND

- — not set or found
- — Set 1/2" iron rod
- ⊙ — Found 1/2" iron rod
- ⦿ — Found 3/4" iron rod
- ⊖ — Found 1" iron pipe
- ⦿ — Found 5/8" iron rod
- ⊖ — Found iron bar

MAP FILE M.62-13