

SURVEY FOR DESCRIPTION

A PORTION OF LOT 1, BLOCK 4 SHINN'S ADDITION
IN SECTIONS 22 & 23, T.27S.R.6W.W.M.

FOR: **BILL LUTH**
BY: **C & G ENG, INC.**

FEBRUARY 1977 — SCALE: 1" = 40'


COUNTY SURVEYORS FILE DATA
DO NOT REMOVE FROM OFFICE

FILED *d*
RECEIVED *OLS*

MAR 2 1977

COUNTY SURVEYOR
DOUGLAS COUNTY, ORE.
MC

MAP FILE M 63-24

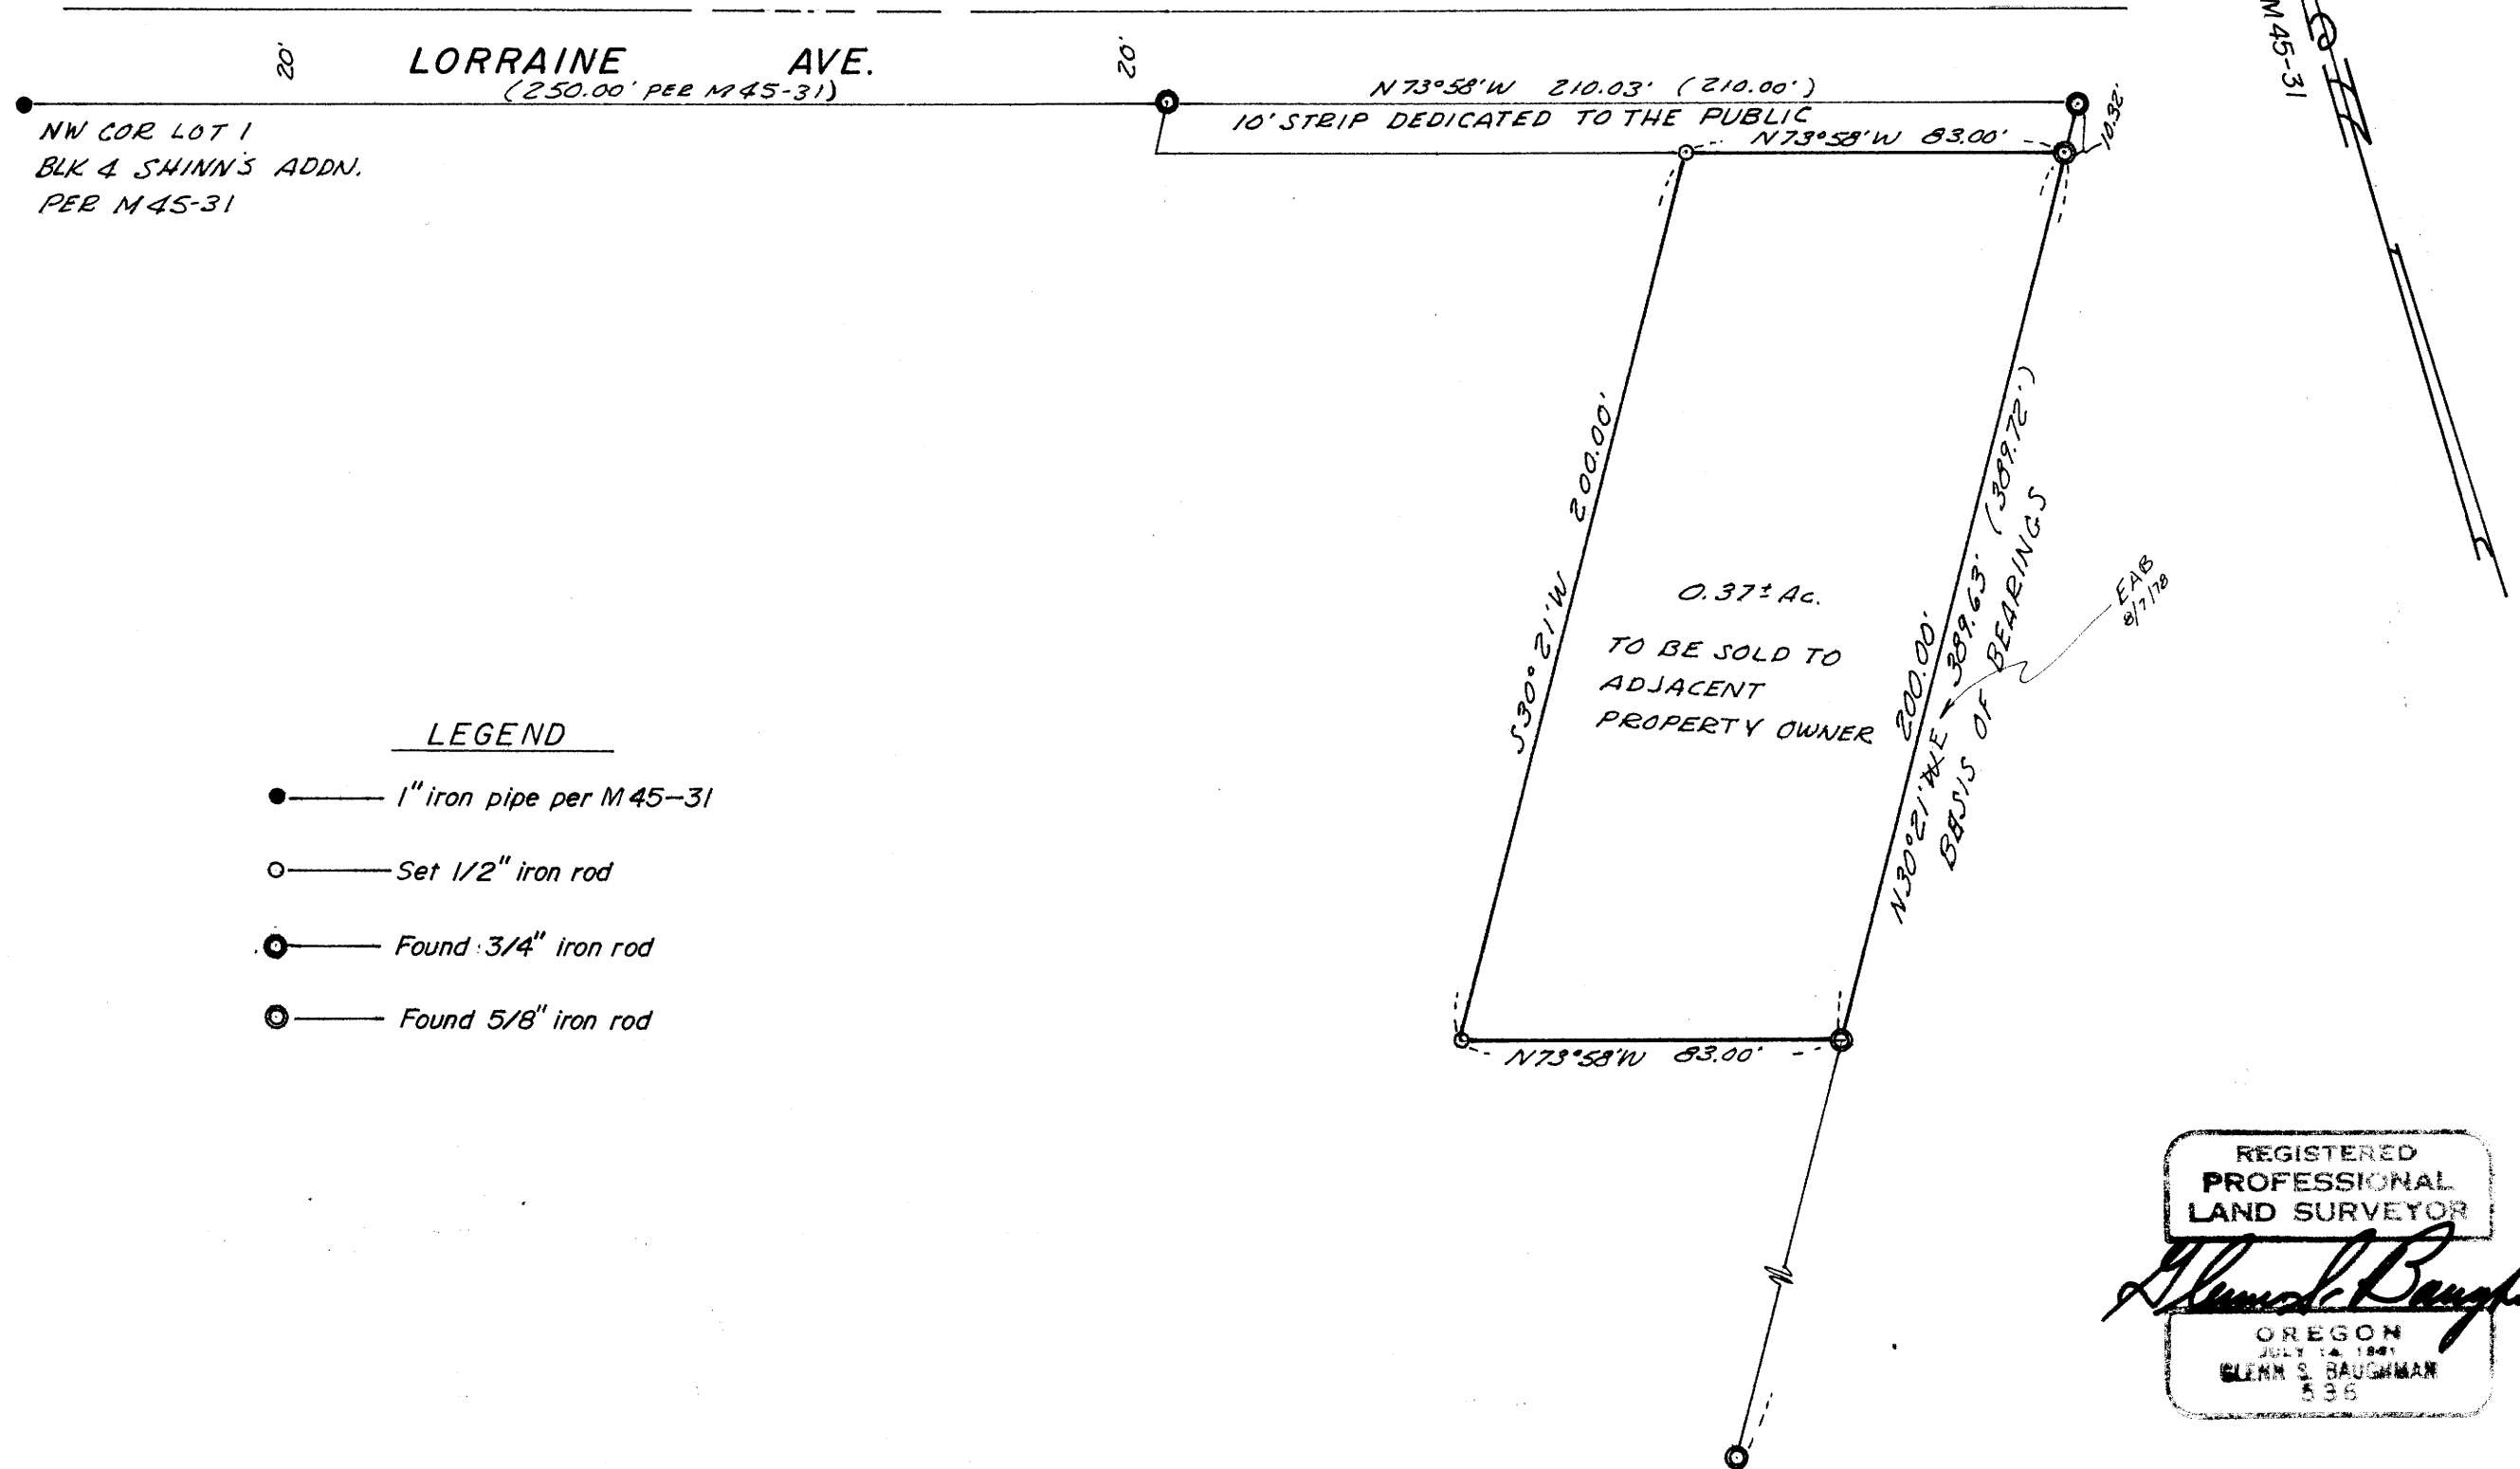

MAP FILE M 63-24