


COUNTY SURVEYORS FILE DATA
DO NOT REMOVE FROM OFFICE

FIELD SURVEY OF DEED DESCRIPTION FOR CLYDE MARRIOTT
CANYONVILLE, OREGON
BLOCK 6 OF GOODELL TRACT, SECTION 34, T.30 S., R.5 W., W.M.

FILED *d*
RECEIVED *gt*

COUNTY SURVEYOR
MIGLAS COUNTY, ORE.
M C

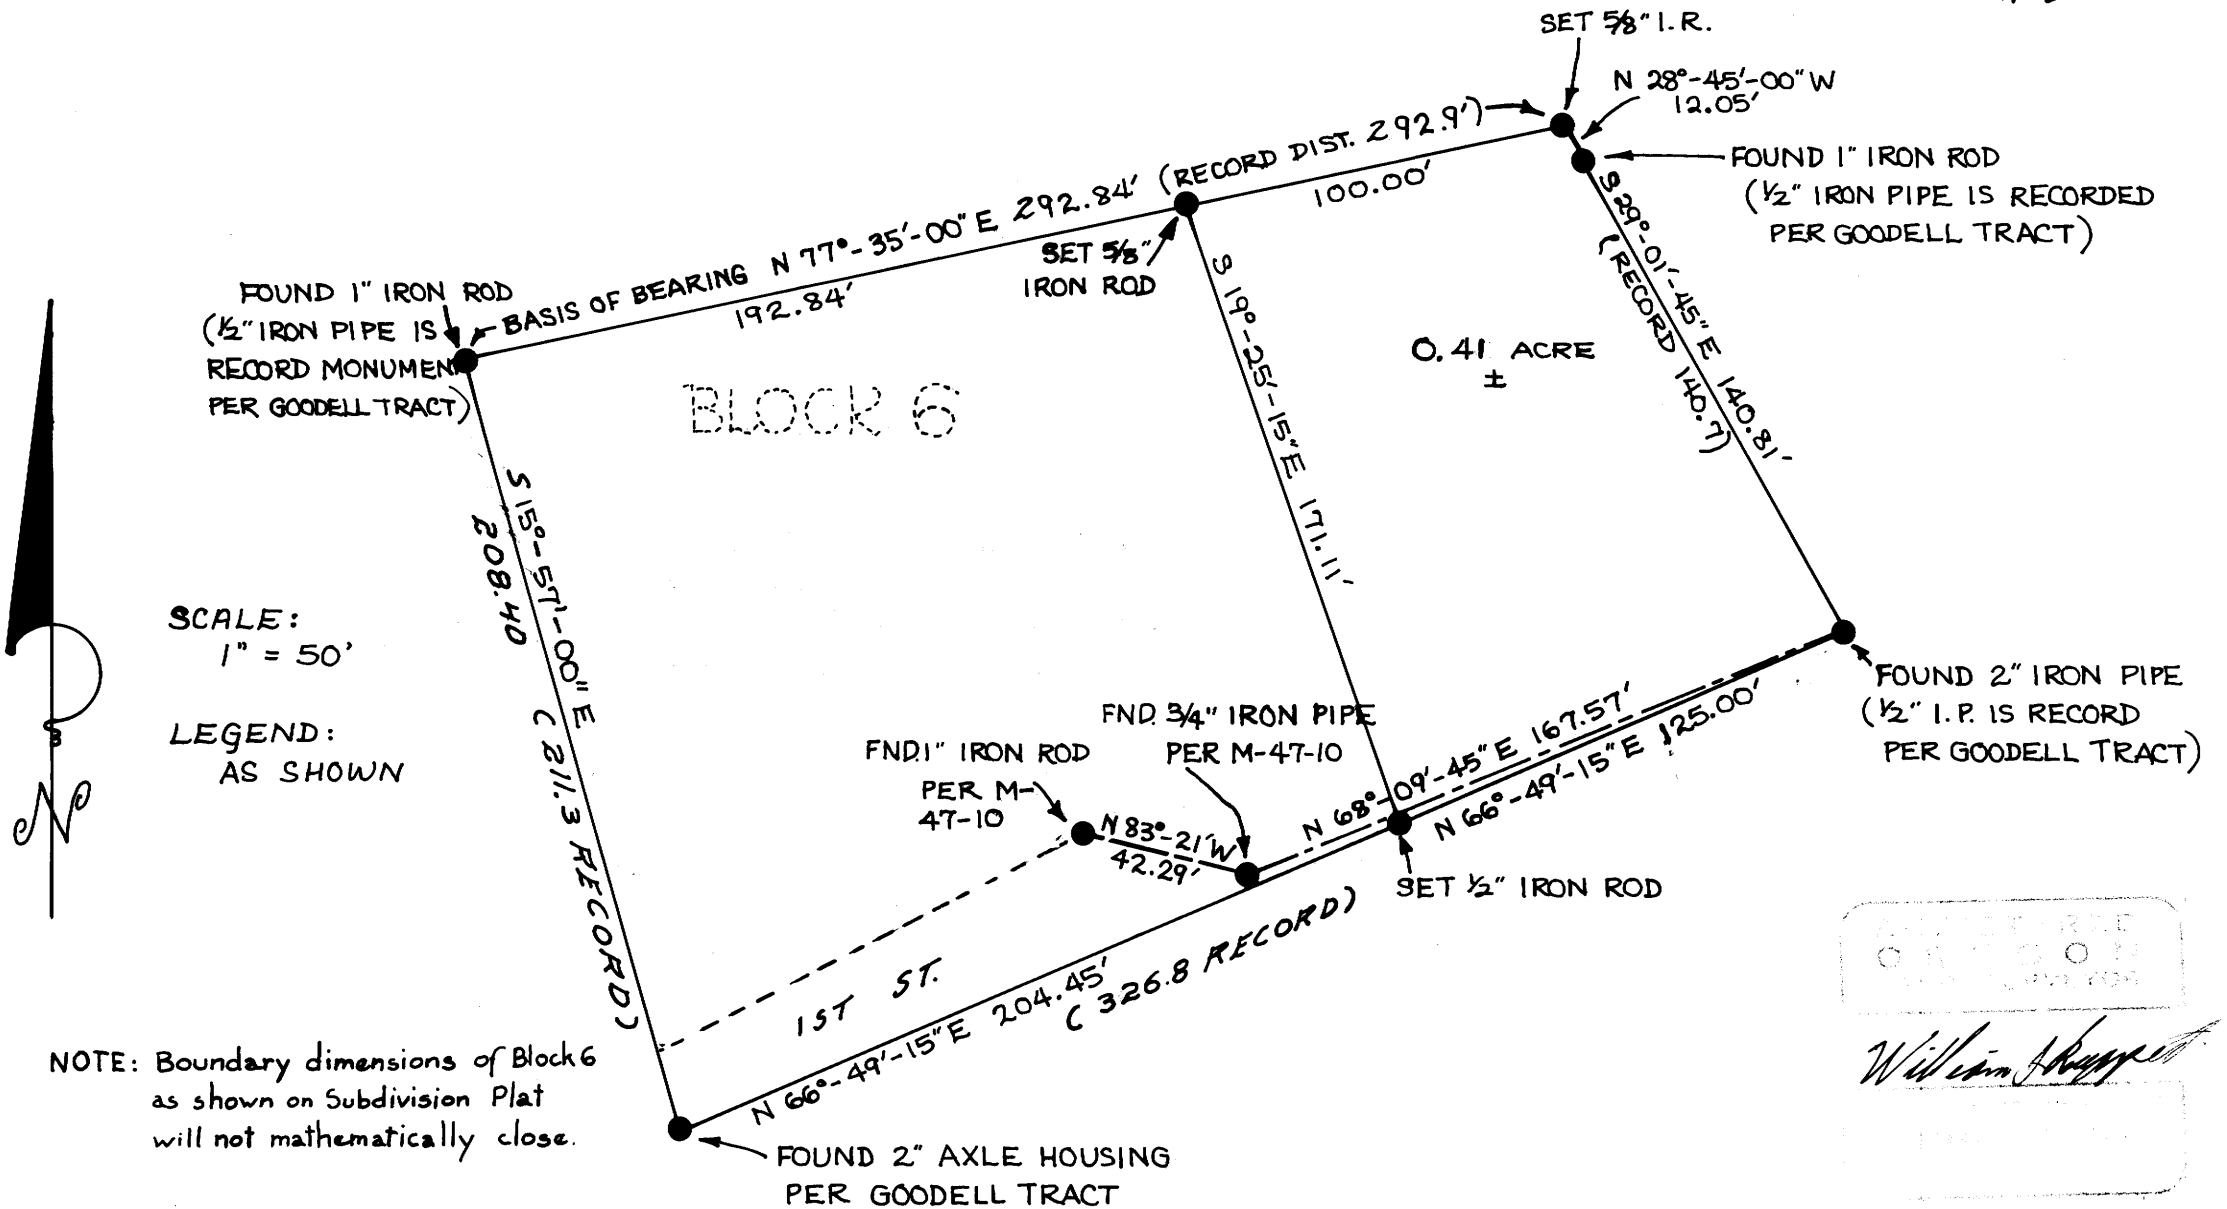

WILLIAM H. HAYES
COUNTY SURVEYOR
MIGLAS COUNTY, ORE.
William Hayes

UMPQUA RESEARCH CO.
MYRTLE CREEK, OREGON
NOVEMBER 1976