


COUNTY SURVEYORS FILE DATA  
DO NOT REMOVE FROM OFFICE

FILED *JRL*  
RECEIVED  
COUNTY SURVEYOR  
DOUGLAS COUNTY, ORE.  
MC

~~SURVEY FOR ROAD EASTMENT~~ IN SEC. 24  
T. 27 S., R. 6 W., W.M., DOUGLAS CO., OREGON  
FOR GEORGE HINSDALE. 1043 W. BROWN AVE., ROSEBURG, ORE.  
BY HERBERT L. NORTHCRAFT  
SCALE 1" = 20' MAR. 1977

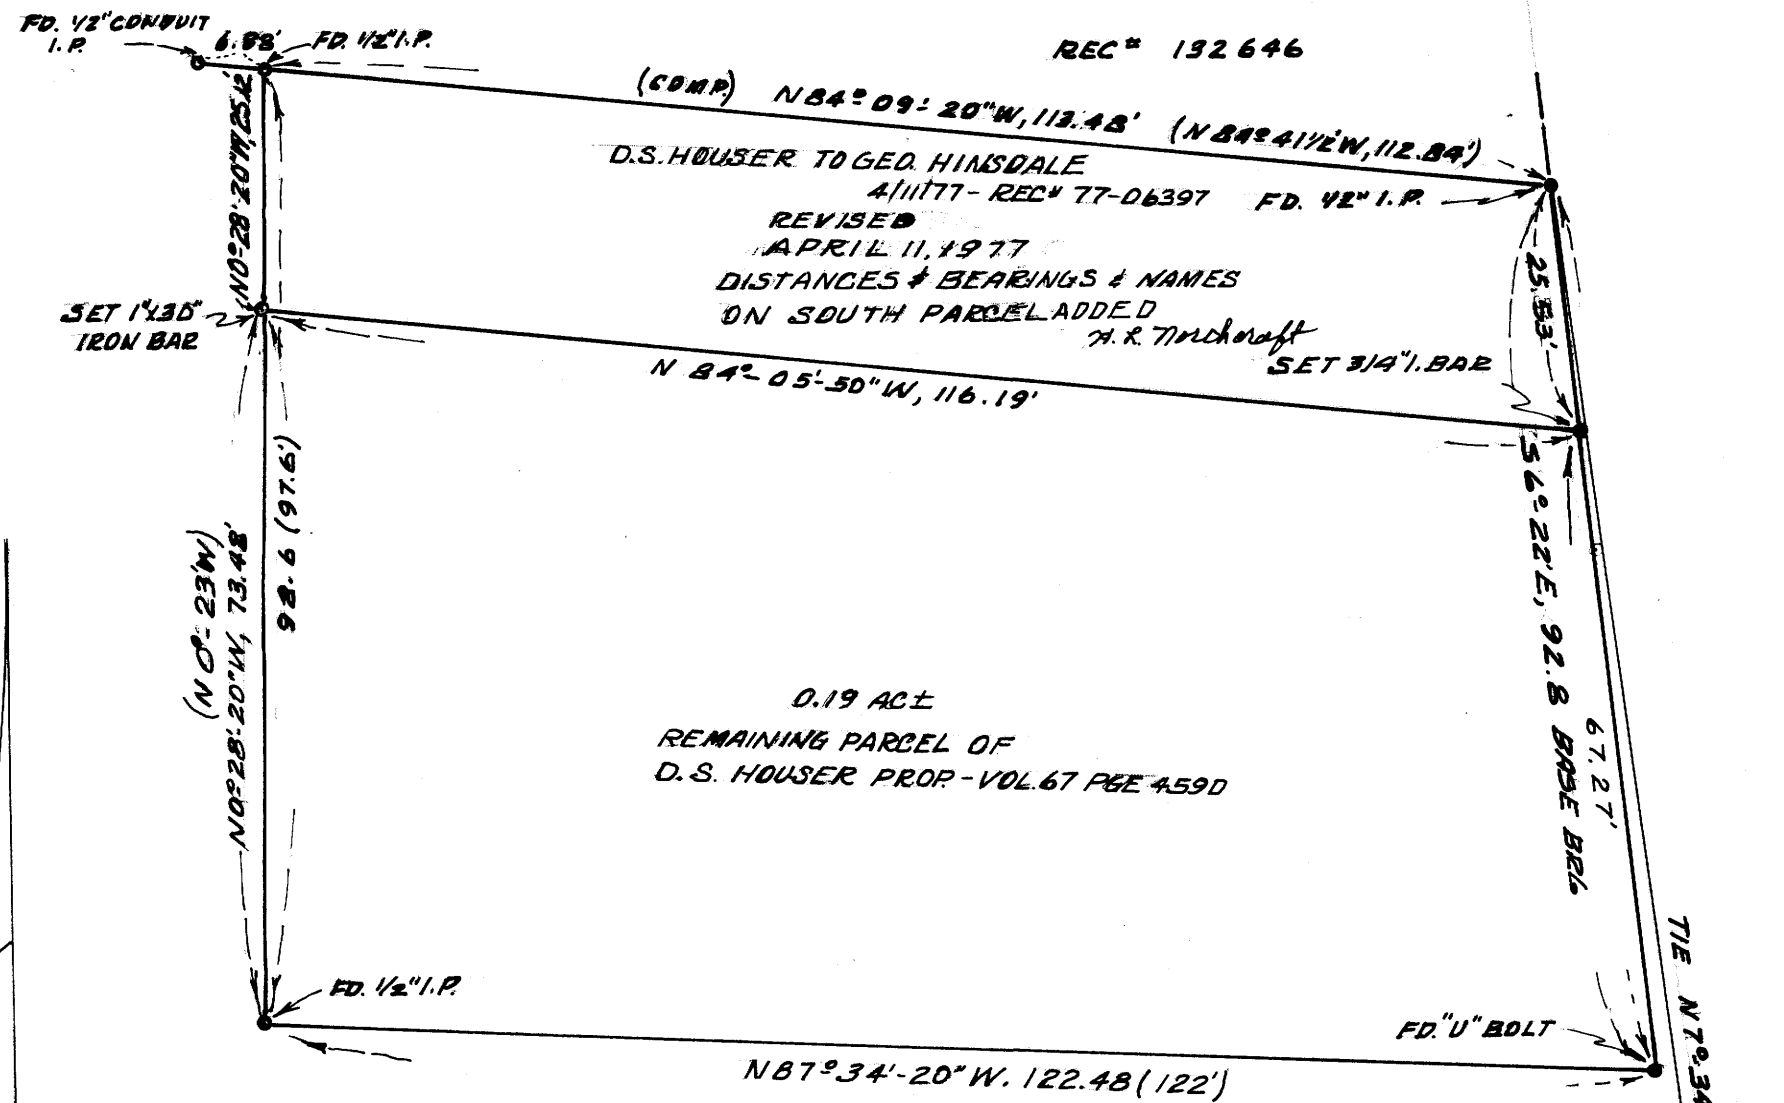

HOUSER TO HINSDALE  
1964

UMPOUA AVE.

LEGEND  
M 28-40 REF.  
M 19-34 REF.

REGISTERED  
PROFESSIONAL  
LAND SURVEYOR

*Herbert L. Northcraft*

OREGON  
JULY 6, 1966  
HERBERT L. NORTHCRAFT  
750

FD. "BC" FOR SW  
COR. J. HUNTLEY  
D.L.C. # 56 SEC. 24 T. 27 S., R. 6 W., W.M.

MAP FILE 63-48

MAP FILE M 63-48

M 63-48