

COUNTY SURVEYORS FILE DATA
DO NOT REMOVE FROM OFFICE


SURVEY IN SEC. 30, T24S, R5W AND SEC. 25, T24S, R6W. W. M.

SURVEYED FOR - JIM DIVINE
SURVEYED BY - W.S. BARNES ENGINEERING SERVICE

APRIL 1977
SCALE 1" = 200'

mc
COUNTY SURVEYOR
v

MAP FILE
M 63-71

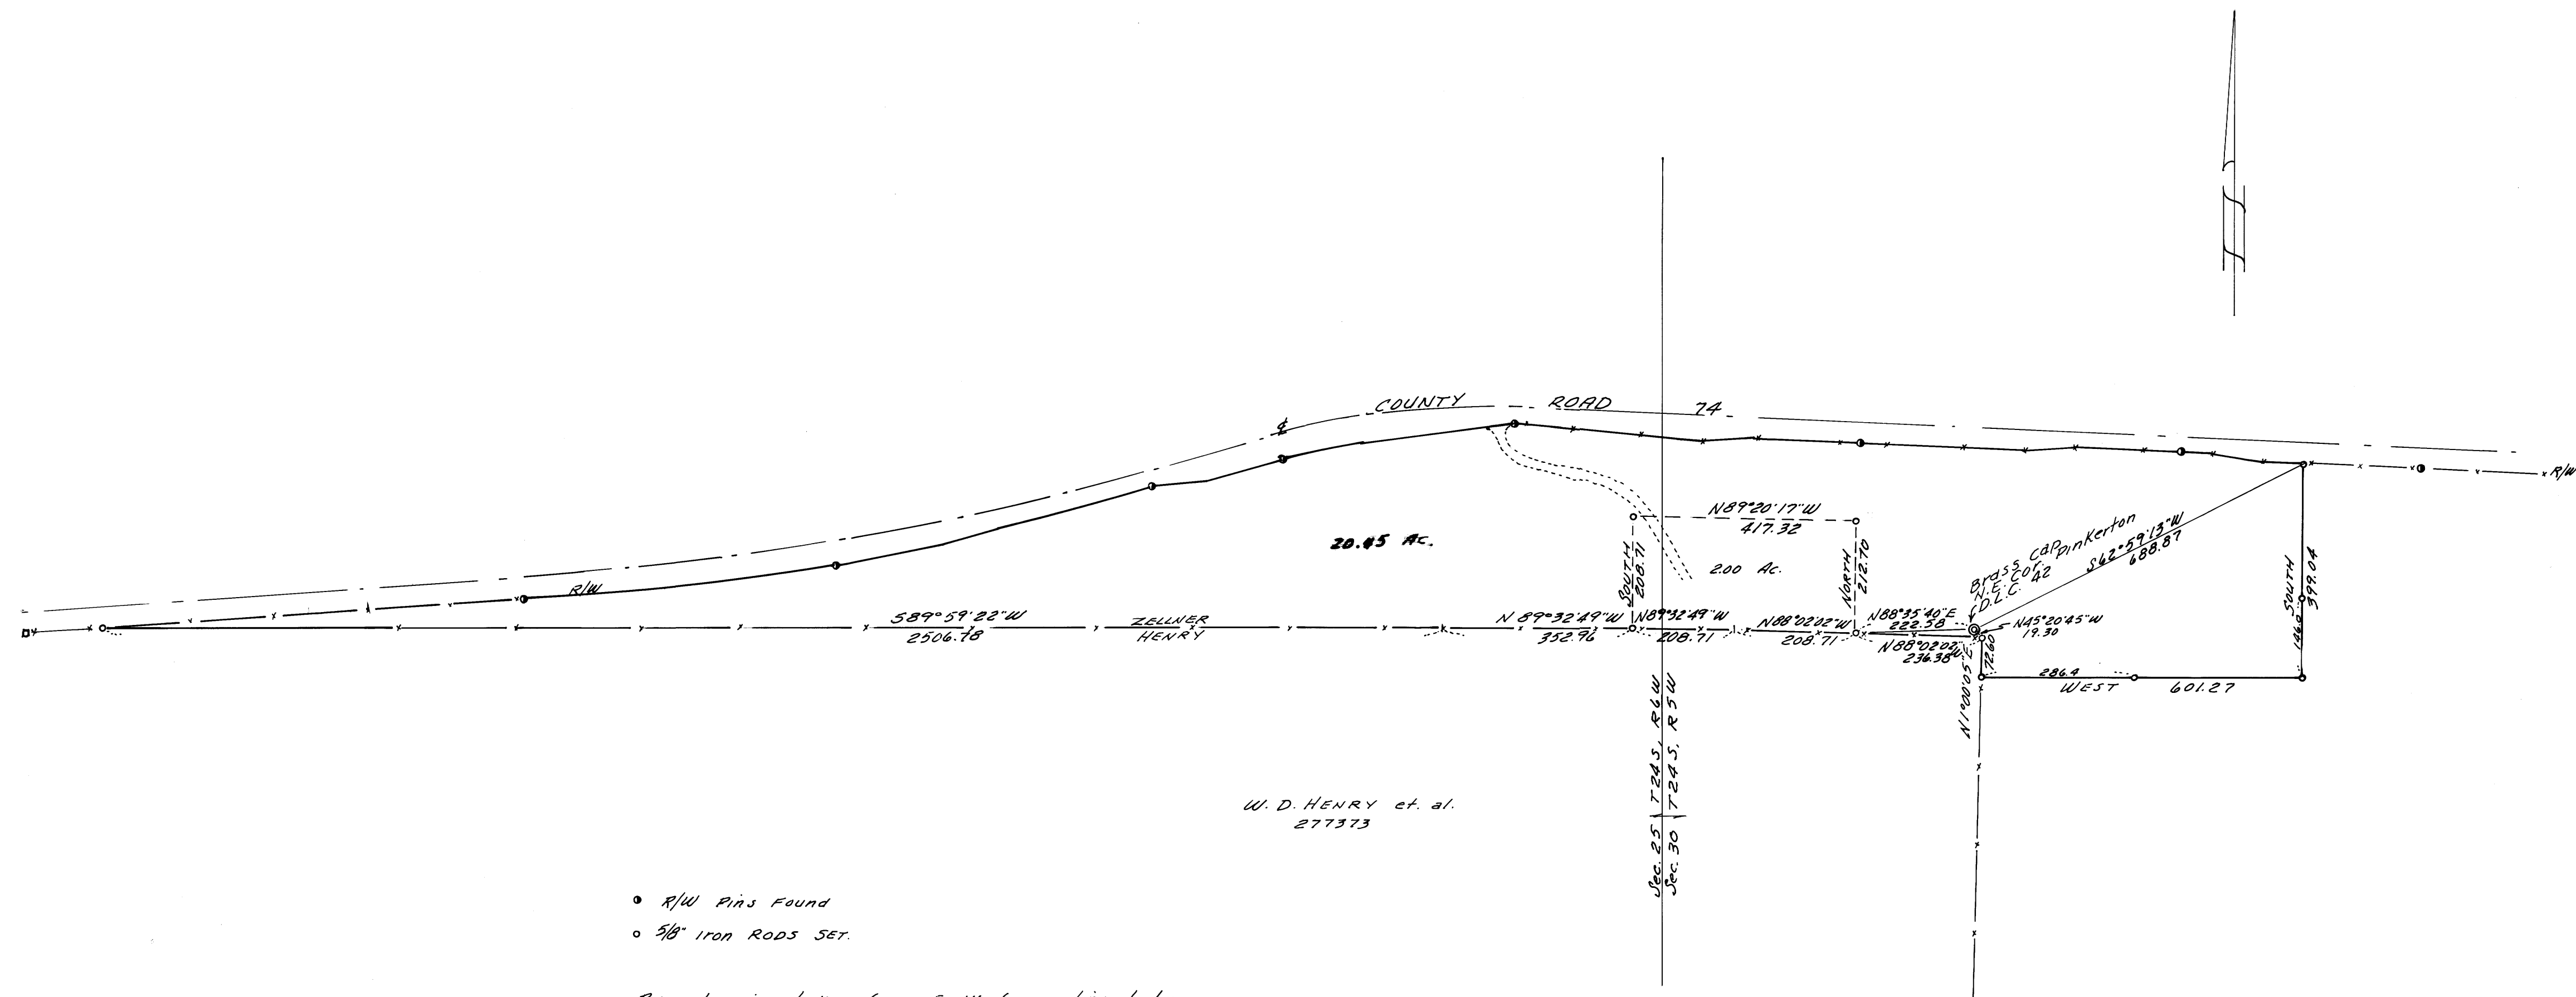

W. D. HENRY et. al.
277373

- R/W Pins Found
- 5/8" IRON RODS SET.

Base bearing taken from E-W fence line between Henry & Zellner.



MAP FILE M 63-71