


COUNTY SURVEYORS FILE DATA
DO NOT REMOVE FROM OFFICE

FILED ✓
RECEIVED *CS*

MAY 3 1977

COUNTY SURVEYOR
DOUGLAS COUNTY, ORE.

SURVEY FOR DEED DESCRIPTION
IN SECTION 6, T. 24S., R. 5 W. W.M.
FOR REYNALD BATTAI
BY BRUCE ROGERS
MAY, 1977
1" = 200'

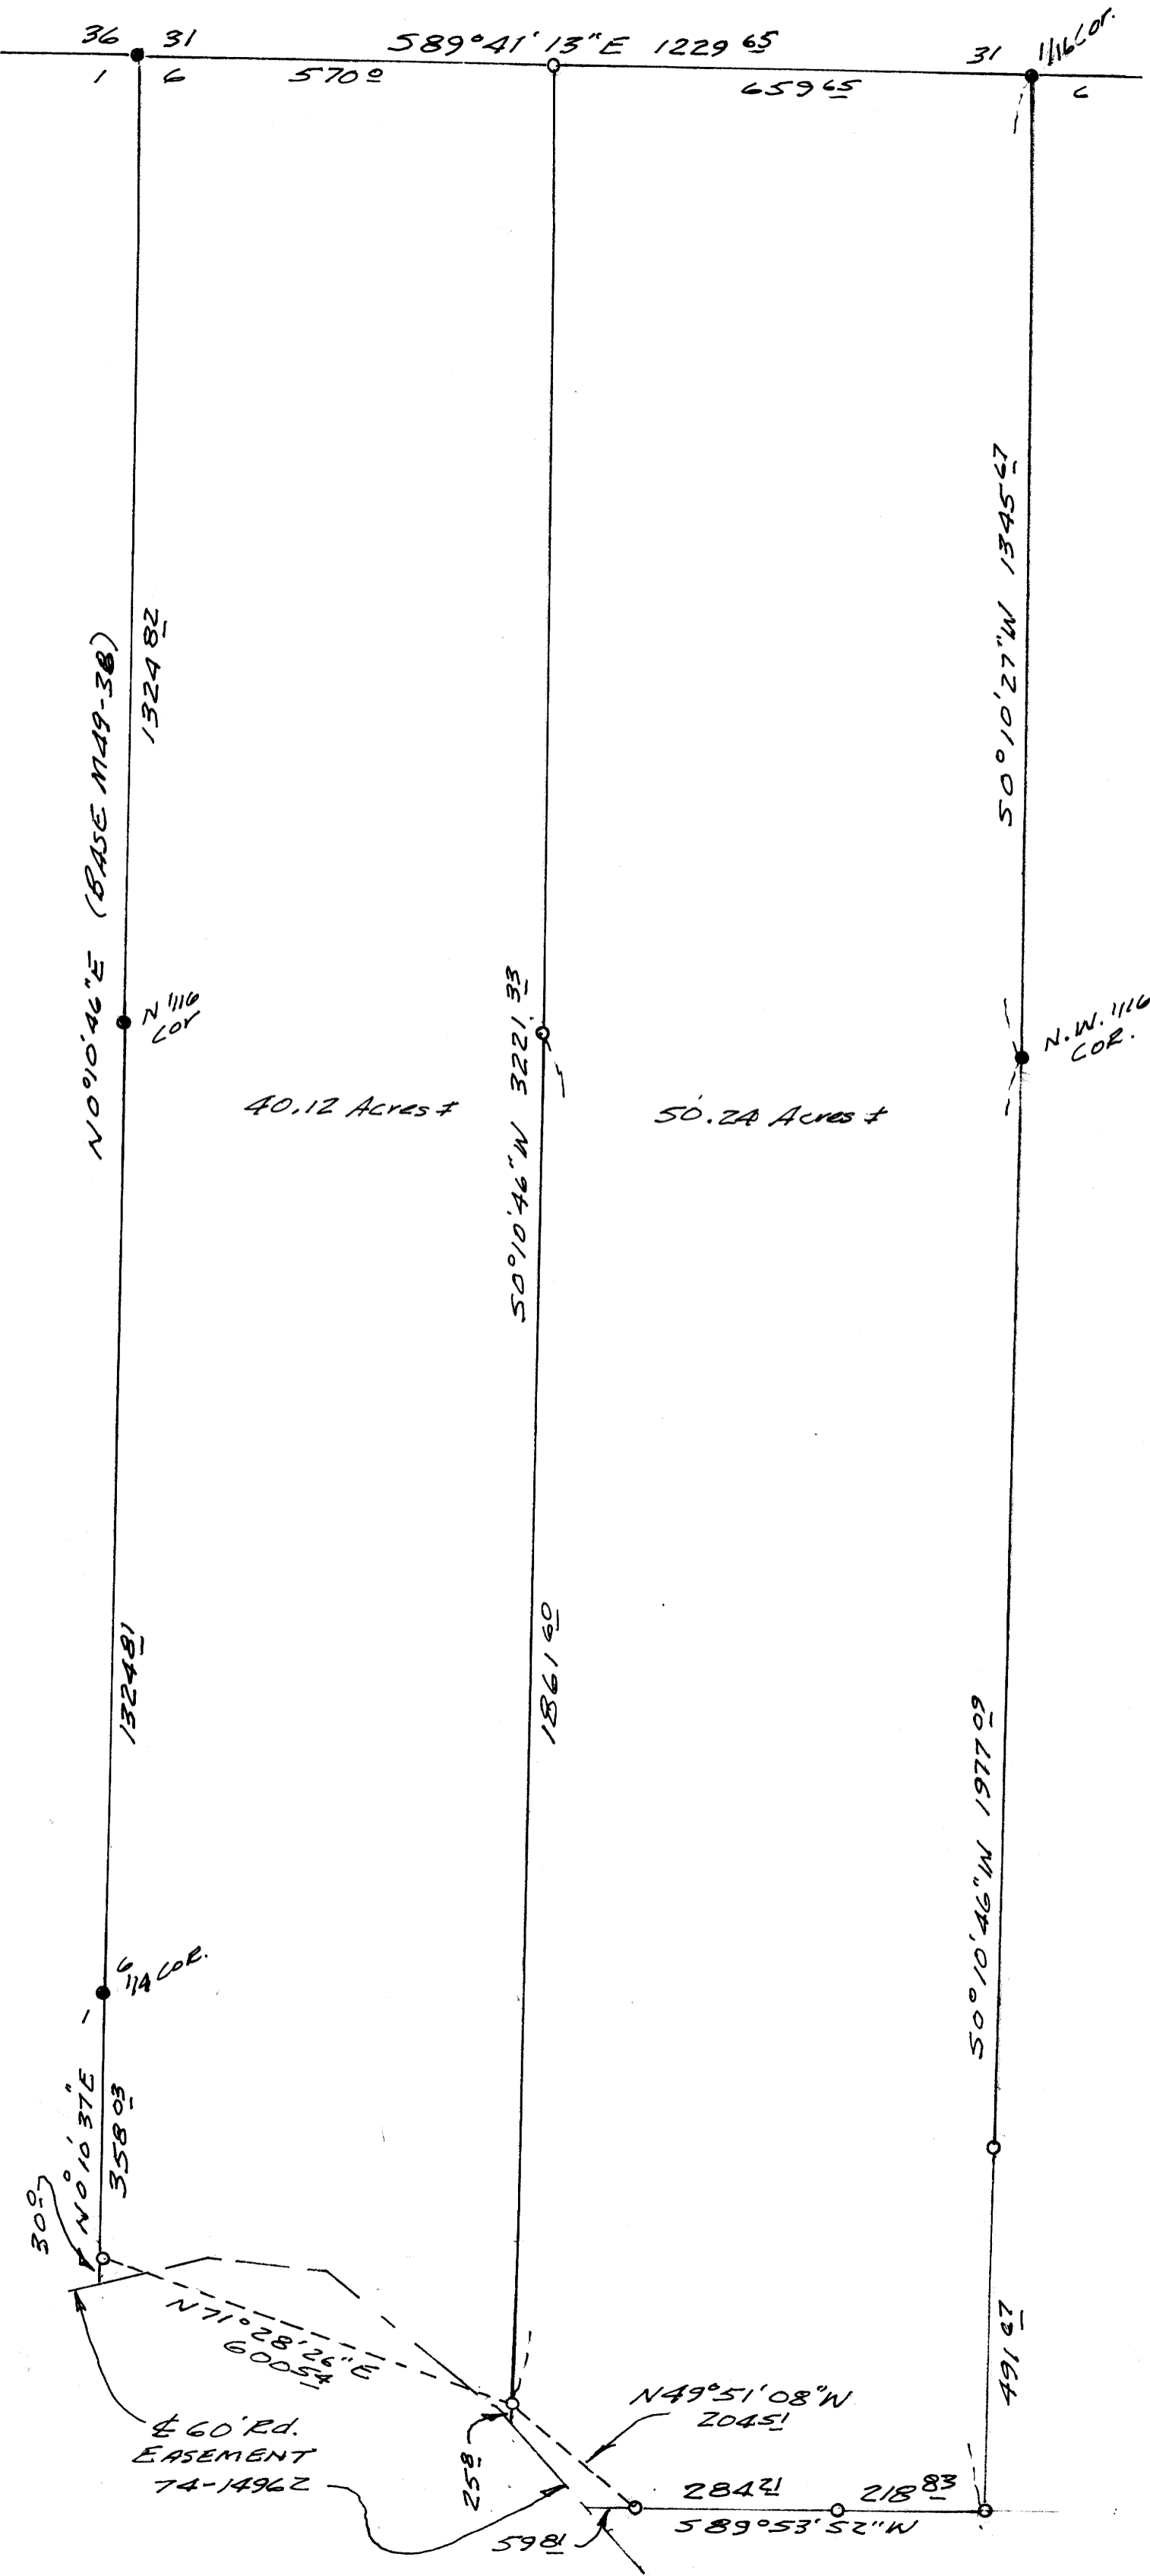

- - FOUND BRASS CAP SEE M49-38
- - SET 5/8" Iron Rod

Bruce F. Rogers
 BRUCE F. ROGERS
 SURVEYOR