

MAP FILE M64-23

FILED *v*
RECEIVED *7/8*

MAY 13 1977

COUNTY SURVEYOR
DOUGLAS COUNTY, ORE.

v

SURVEY

in


Section 19, T. 27 S. R. 5 W. W.M.

for


KEN LANCASTER

legend

- FOUND 1/2" IRON PIPE
- ⊗ FOUND 3/4" IRON PIPE
- FOUND 3/4" IRON ROD
- SET 3/4" IRON ROD

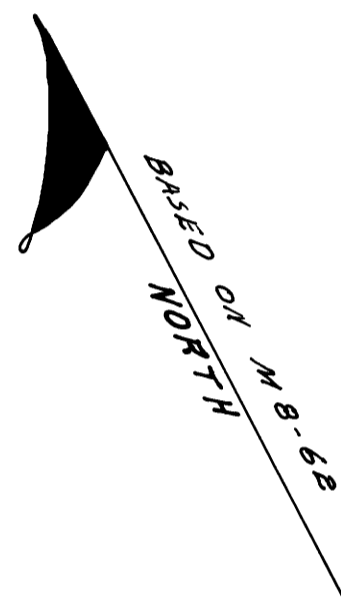

SCALE 1" = 50'

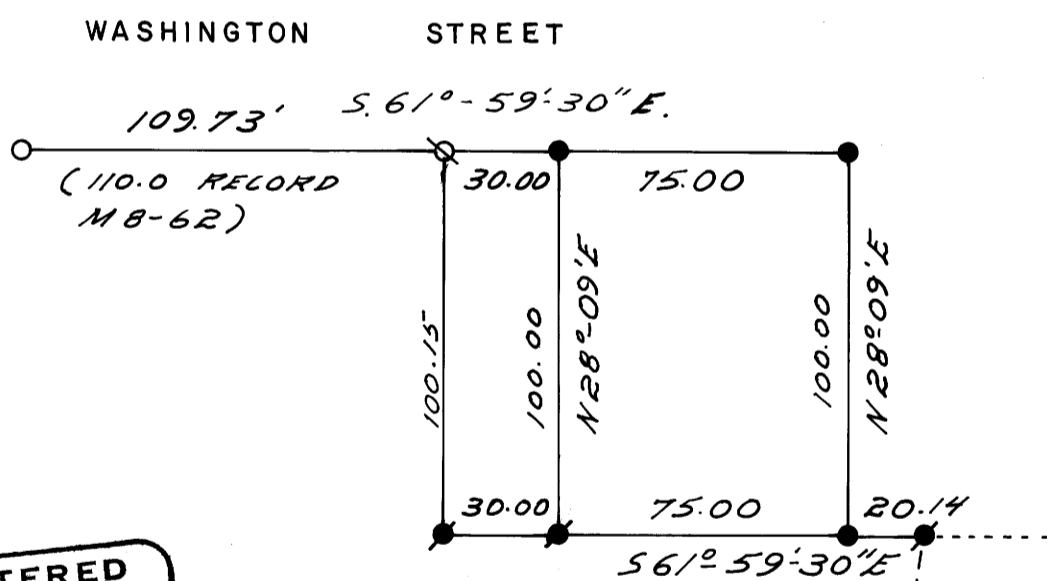

LOT 5
FIRST ADD. TO
OVERLOOK

REGISTERED
OREGON
LAND SURVEYOR

William J. Ruppert

JULY 12, 1968
WILLIAM J. RUPPERT
866

UMPQUA RESEARCH COMPANY

myrtle creek, oregon

april 28, 1977

MAP FILE M64-23