

MAP FILE M64-44  
C.S. FILE NO. 58/143

SURVEY OF DEED DESCRIPTION

FOR

FILED ✓  
RECEIVED ✓


JUN 7 1977

COUNTY SURVEYOR  
DOUGLAS COUNTY, ORE.

✓

ROBERT J. & DOROTHY BRUNSKILL

SECTION 32 T. 30 S. R. 5 W. W.M.

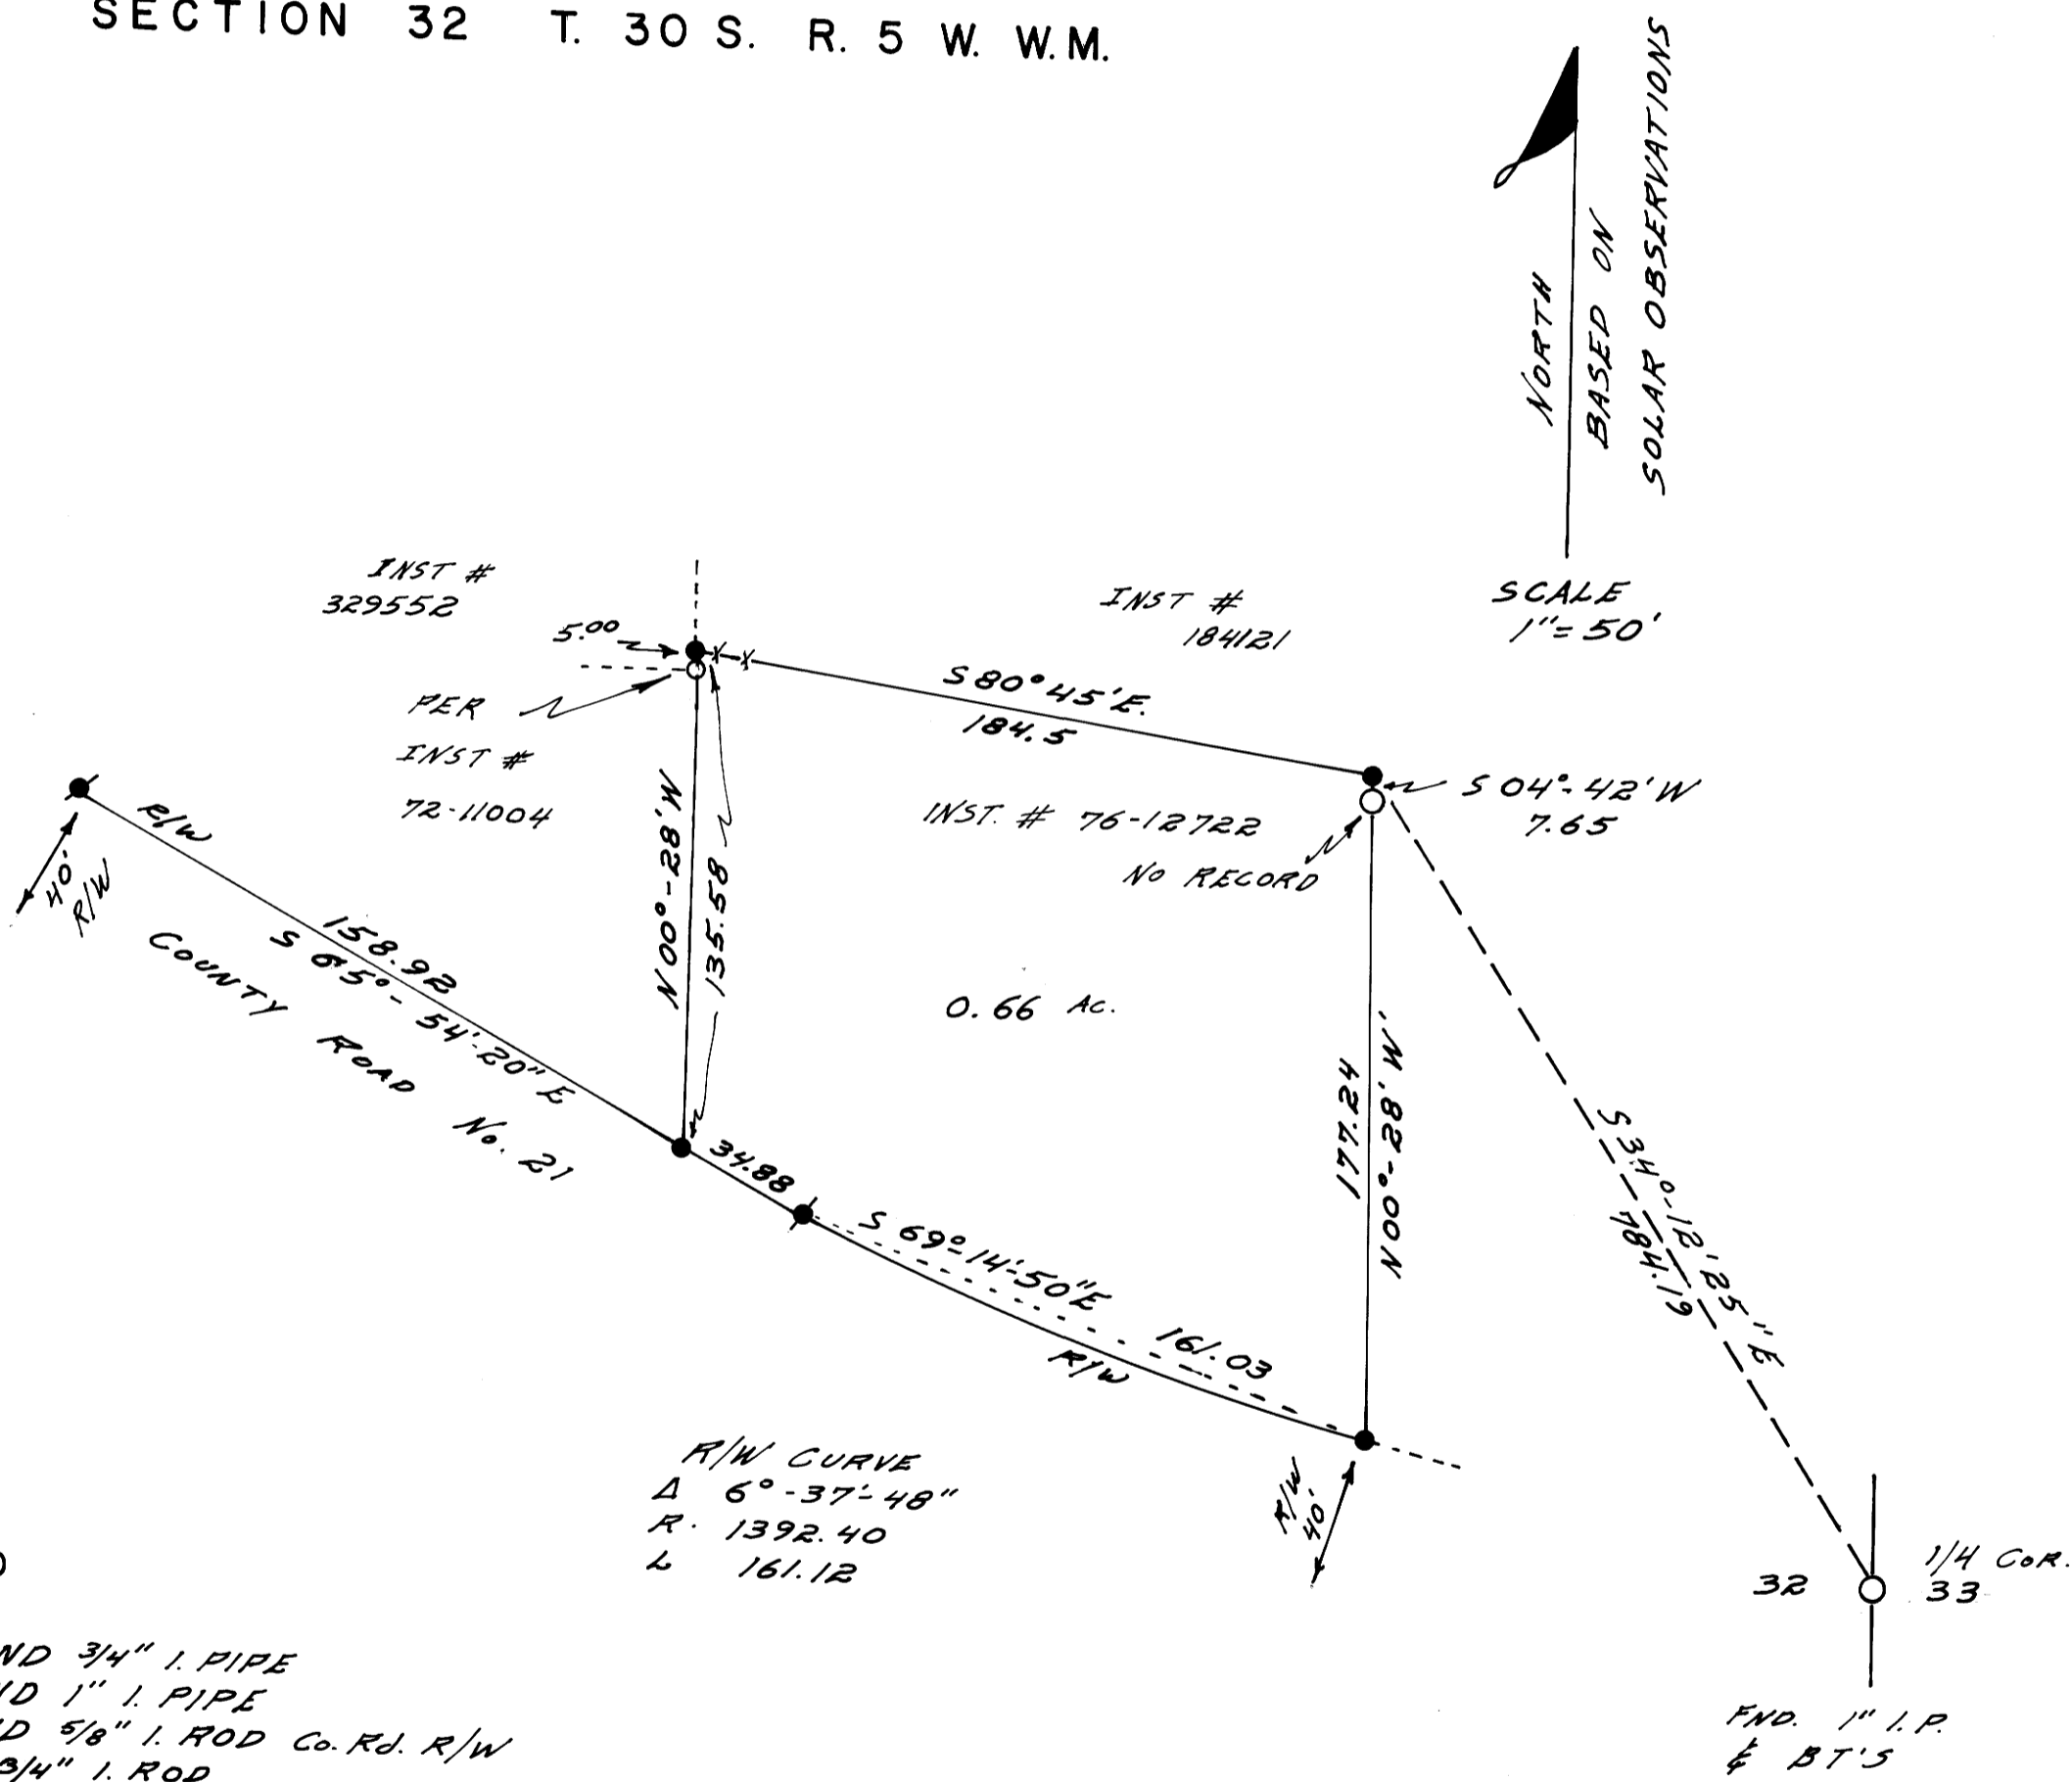

LEGEND

- FOUND 3/4" I. PIPE
- FOUND 1" I. PIPE
- FOUND 5/8" I. ROD Co. Rd. R/W
- SET 3/4" I. ROD

REGISTERED  
OREGON  
LAND SURVEYOR

WILLIAM J. RUPPERT  
JULY 12, 1968  
WILLIAM J. RUPPERT  
866

UMPQUA RESEARCH CO.

myrtle creek, oregon

may 1977

C.S. FILE NO. 58/143  
MAP FILE M64-44

CS FILE FOLDER

CONTAINS

MORE

INFORMATION