


DO NOT REMOVE FROM OFFICE

FILED  
RECEIVED JRL  
MAY 16 1977  
COUNTY SURVEYOR  
DOUGLAS COUNTY, OREG.

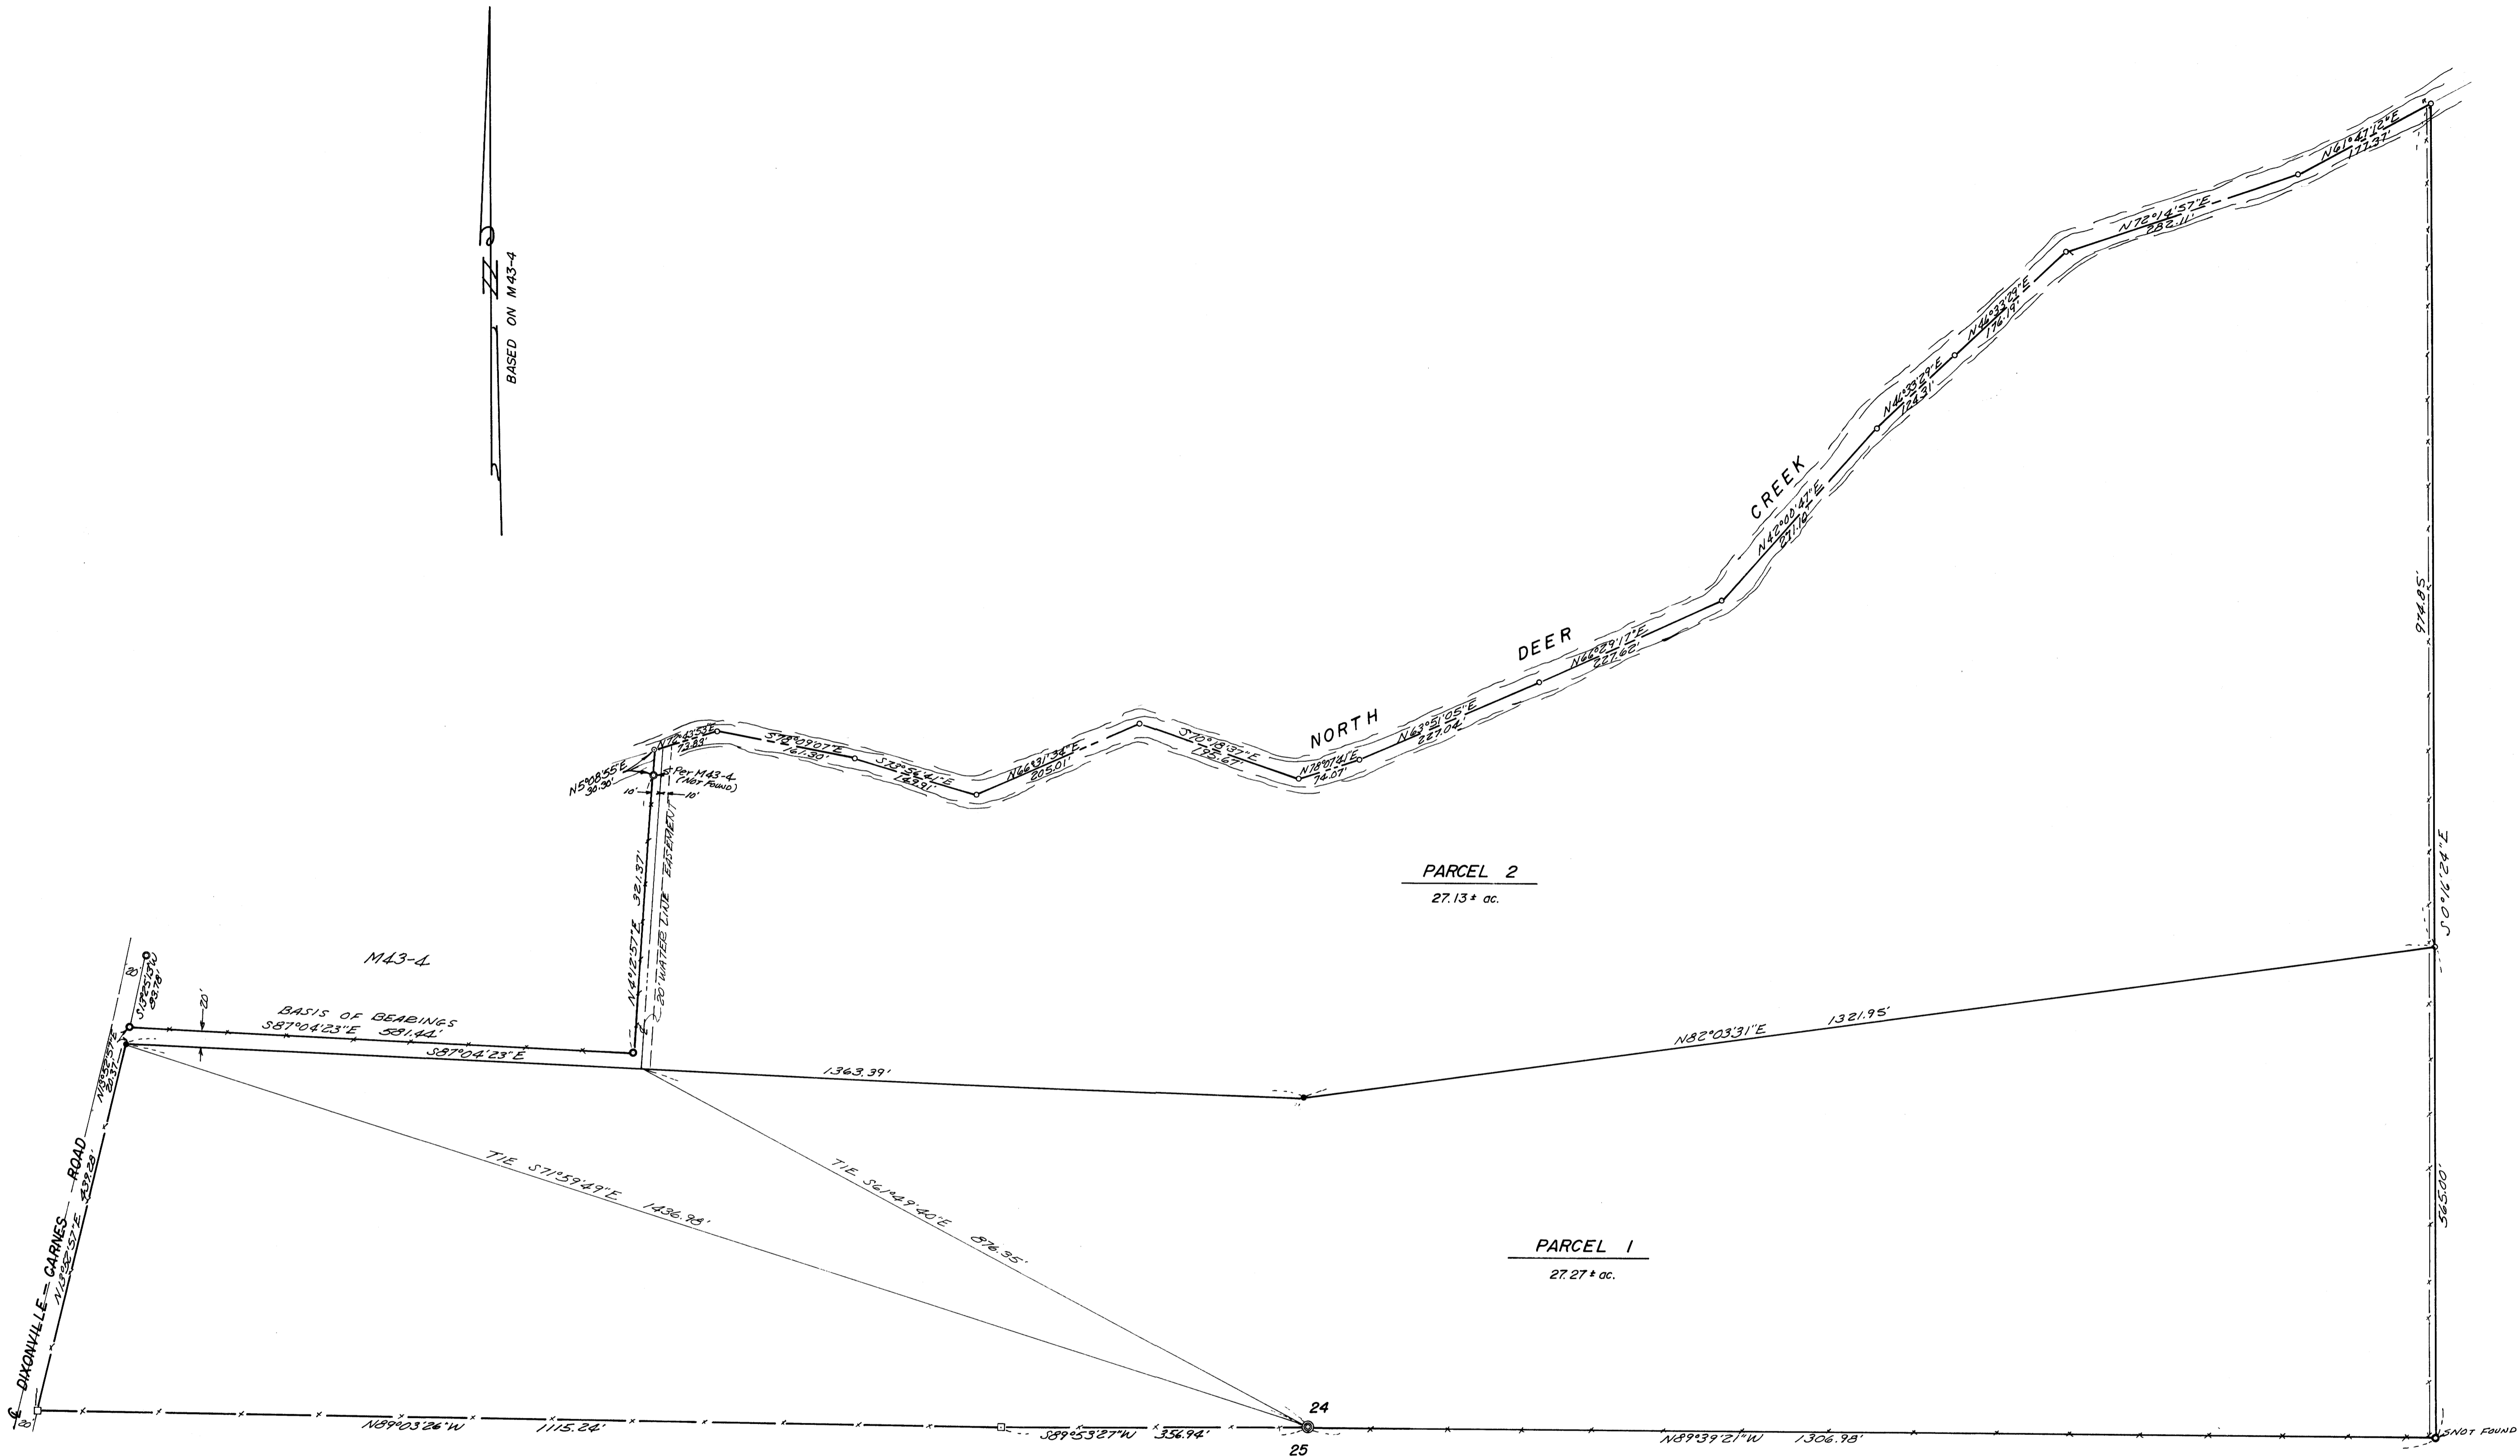

LEGEND

- — Set 5/8" iron rod
- — Point not set
- — 3/4" iron rod - per M34-47
- — Found 5/8" iron rod
- — Found Brass cap
- — Fence corner

COUNTY SURVEYORS FILE DATA  
DO NOT REMOVE FROM OFFICE

REGISTERED  
PROFESSIONAL  
LAND SURVEYOR  
*Allen S. Baughman*  
OREGON  
MAY 1977  
WERNER S. BAUGHMAN  
530

|   |                  |                             |
|---|------------------|-----------------------------|
| SURVEY FOR DESCRIPTION<br>FOR: GEORGE JAMES       |                  |                             |
| IN SECTION 24, T.27S. R.5W.W.M.                   | SCALE<br>1"=100' | DRAWN BY<br>Eob             |
| C & G, ENG. INC. - P.O. BOX 222, ROSEBURG, OREGON |                  |                             |
| DATE<br>MAY 1977                                  | APPROVED BY      | DRAWING NUMBER<br>6150.0032 |