
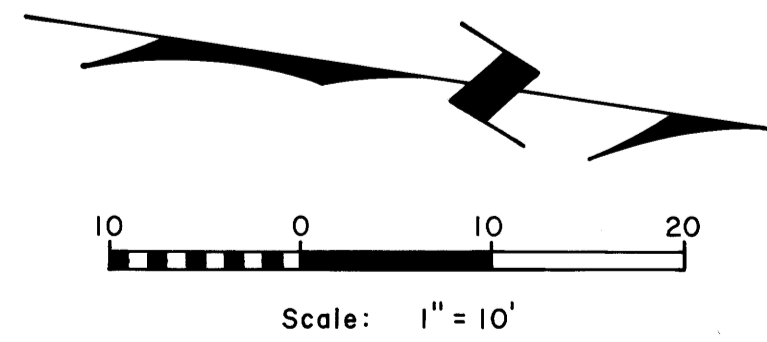


FILED
RECEIVED
JUN 6 1977
COUNTY SURVEYOR
DOUGLAS COUNTY, ORE.

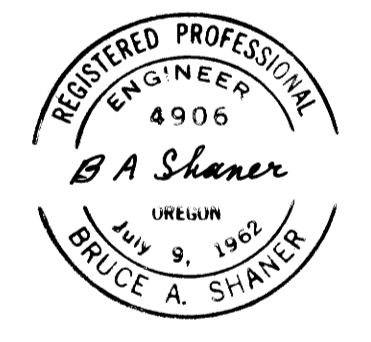

Basis of bearings: Original subdivision bearings

LEGEND

- Corner found (5/8" iron rod unless noted) •
- Corner set (5/8" iron rod with aluminum cap) ○
- PK ○

PROPERTY LINE SURVEY IN LOTS 3 & 4,
DOUBLE - VIEW TERRACE, A SUBDIVISION
IN THE NW 1/4 SEC. 18, T. 27 S., R. 5 W., W. M.
IN THE CITY OF ROSEBURG, OREGON

For: J. C. Hibbs

By: Shaner Engineering, Inc.

June 6, 1977